


COUNTRY

VOL. 4

G - N

1925

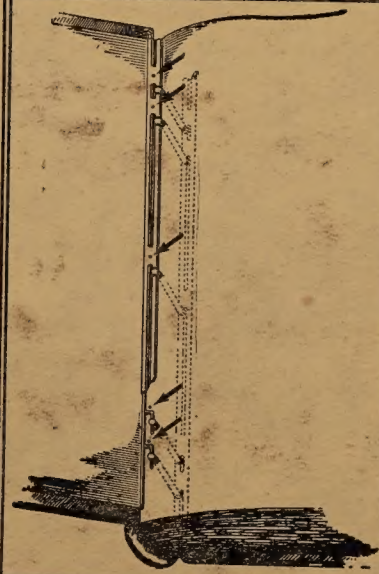

The H & M Loose Leaf Typewriter Book

MADE IN U. S. A. PATENTED JUNE 4, 1907

For Typewritten Records, Sales Books, Etc.

In using this book, take out the first leaf, make needed entries thereon and, when filled, replace it AT THE BACK of the book following the leaf with leather tab marked "Front". By continuing in this manner this tabbed leaf will gradually move forward and at all times indicate the first page or beginning of the book.

After the entries are all completed, it may be permanently and securely locked or sealed by making, with a hammer and punch or sharp nail, depressions just ahead of each off-set hook as indicated on the cut. If desired, the hook end of the rod can be cut off, but it is not essential.


Manufactured Exclusively by

HALL & MCCHESENEY, INC.
SYRACUSE .. NEW YORK

Special Order No. H **25800**



BINSON TRACT

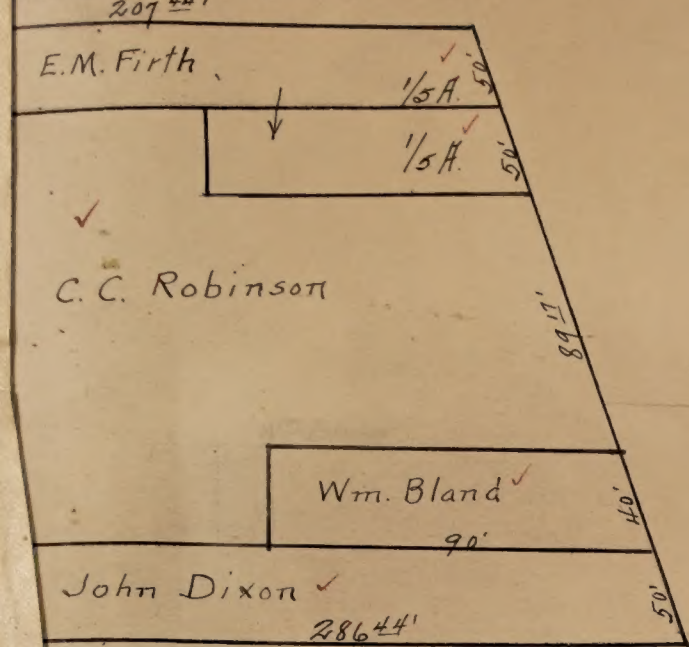


GALT

Scale 3 chains = 1 inch


Sargent

Galt. S.D.

PALIN'S ADD.

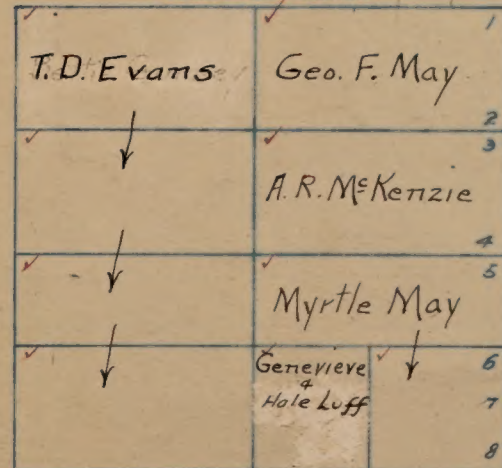


FERRIS ADD.

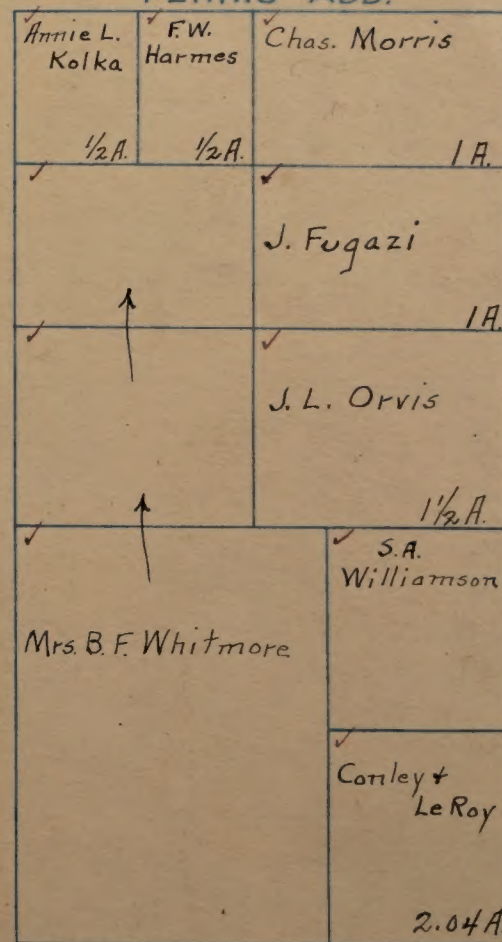

QUIGGLE TRACT

Scale - 100 ft. = 1 in.

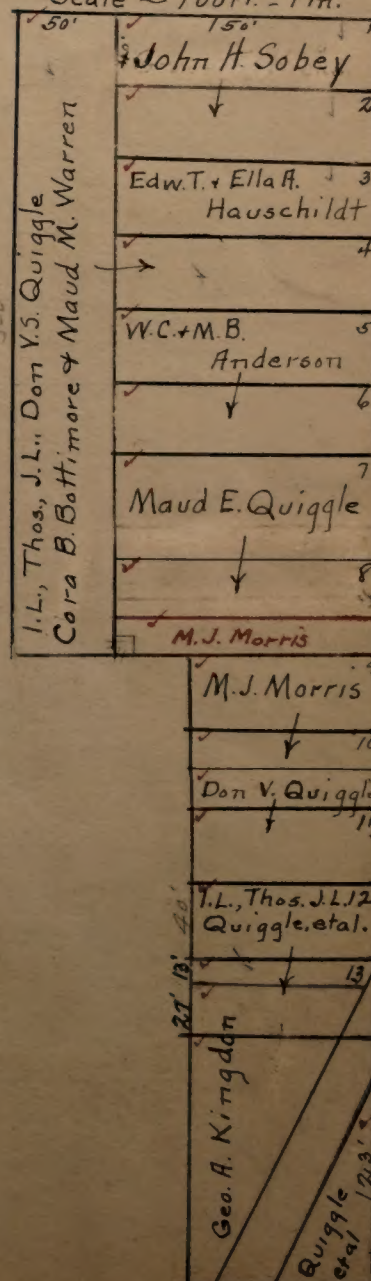





A.H. Alderman
4 Acs.
Checked in
Sec. 27-5-6

Andor Branch R.R.

S.P.R.R.

OAK AVE.

Myrtle St.

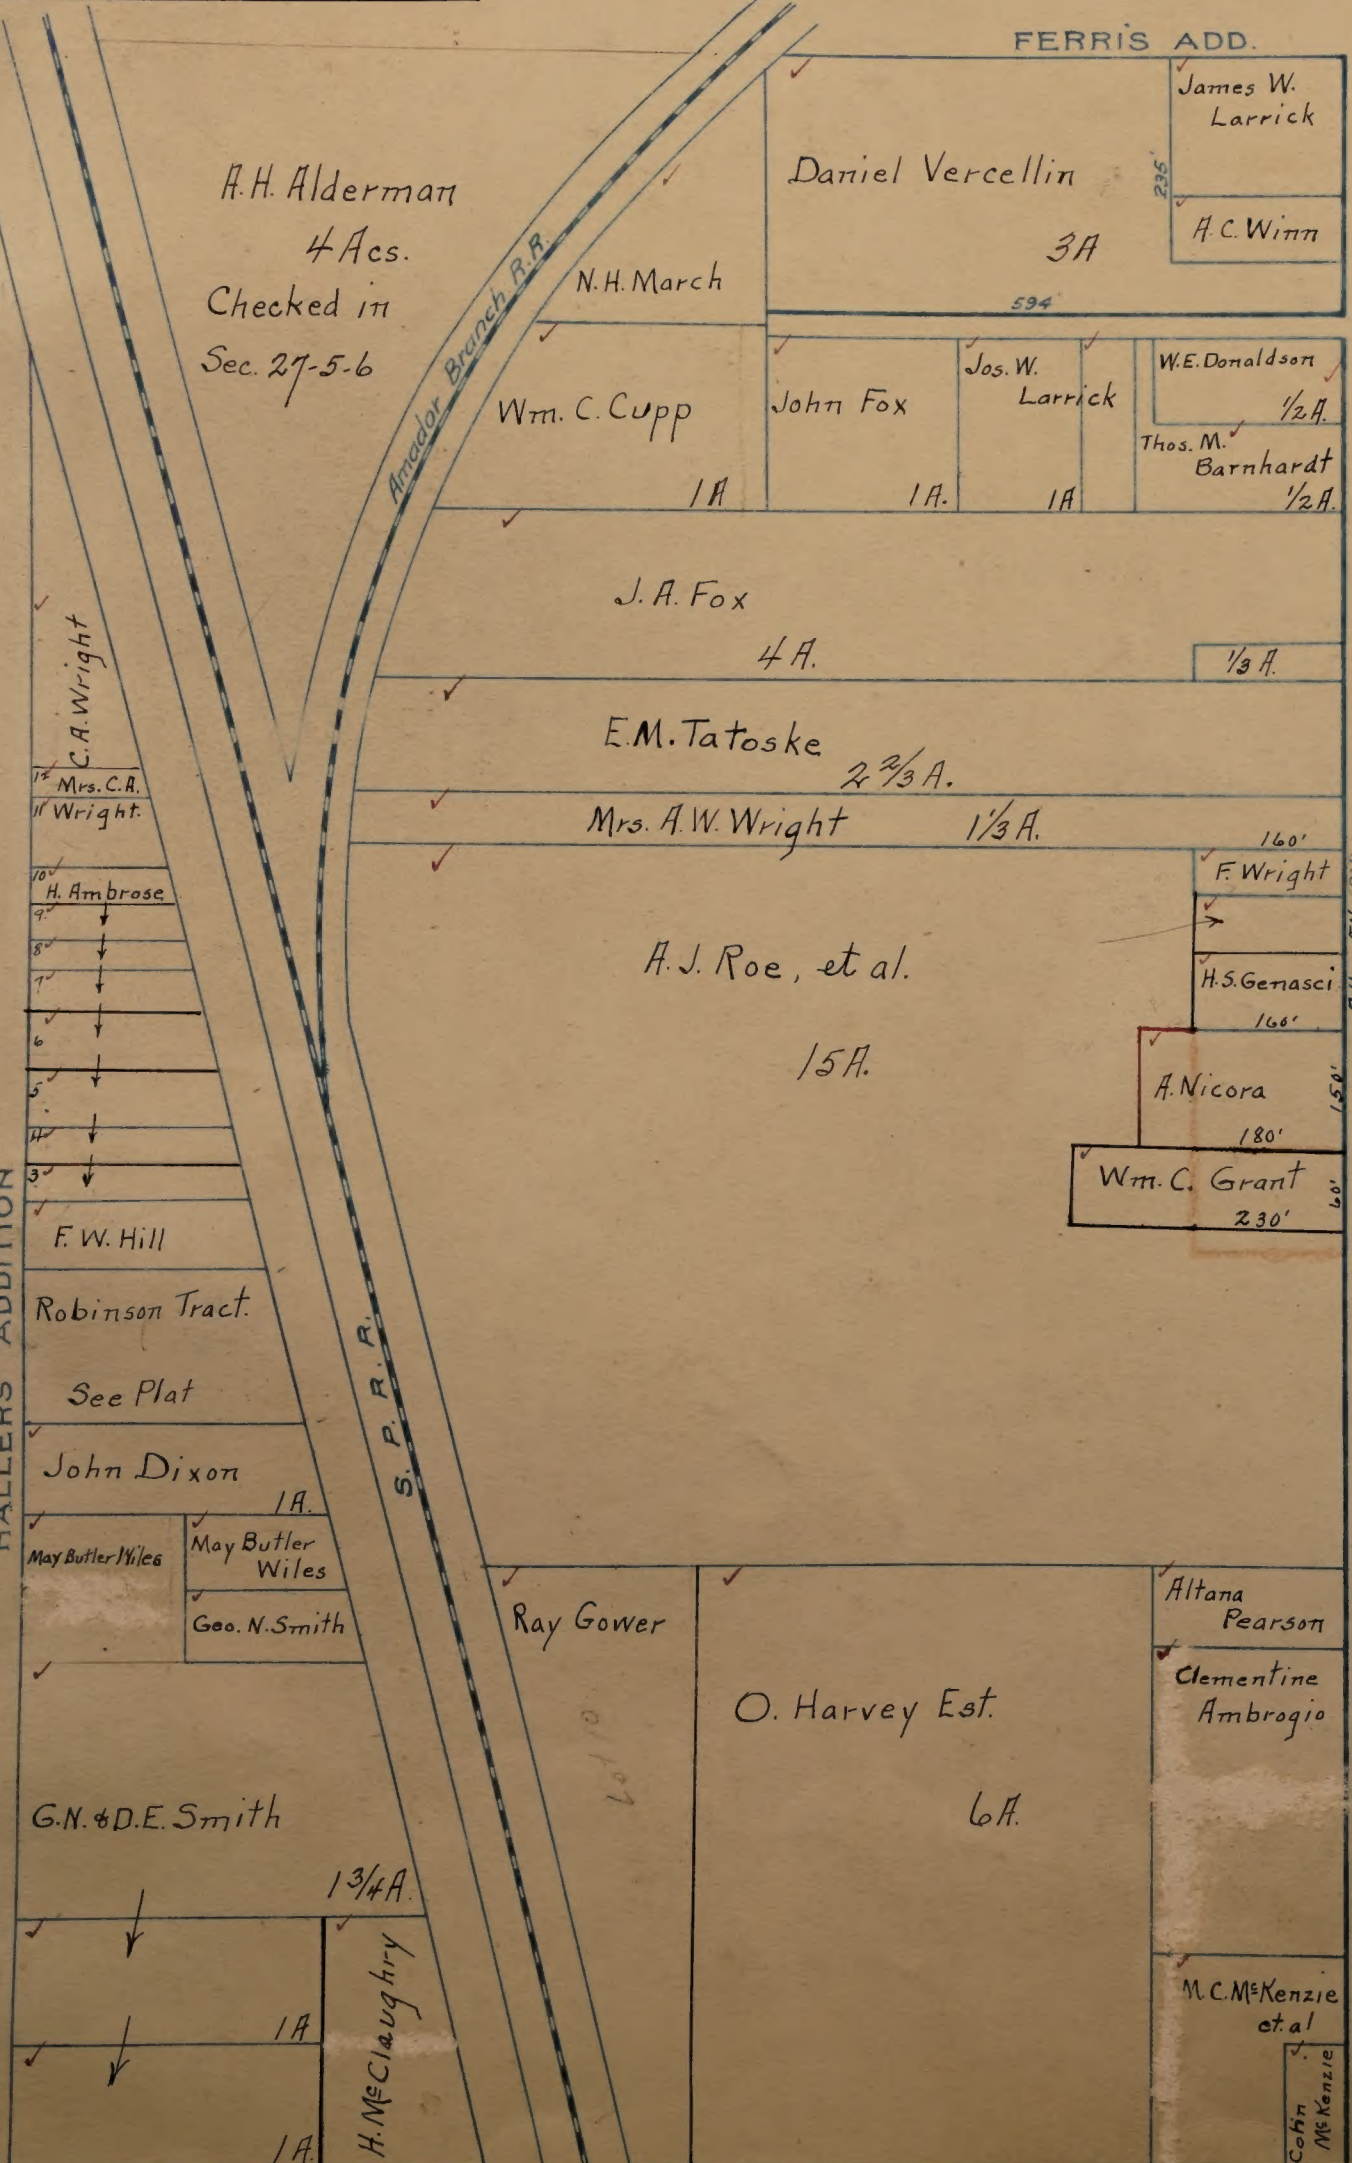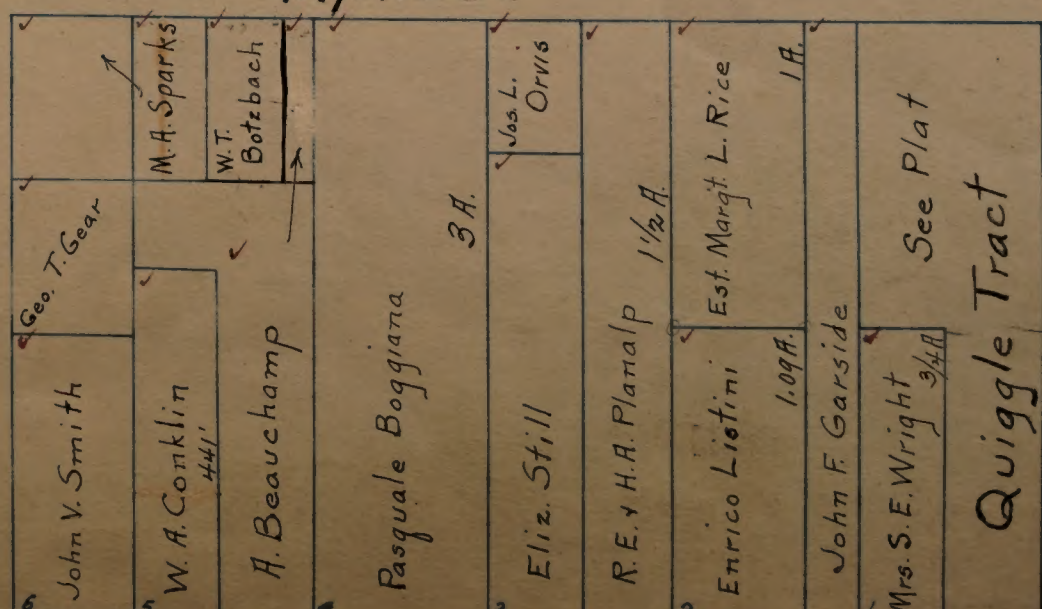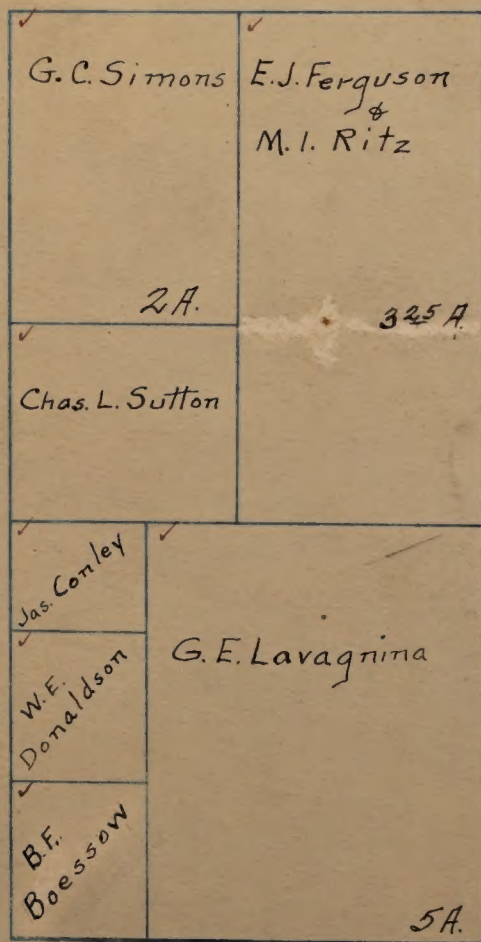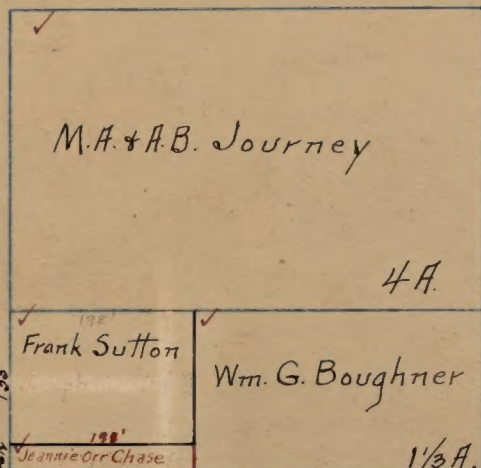

S.P.Co. 21,600 Sq. Ft.


A St.

GALT. ✓

Scale 100 feet=1 inch.

GALT, S.D.


Blanks to Obed Harvey Estate

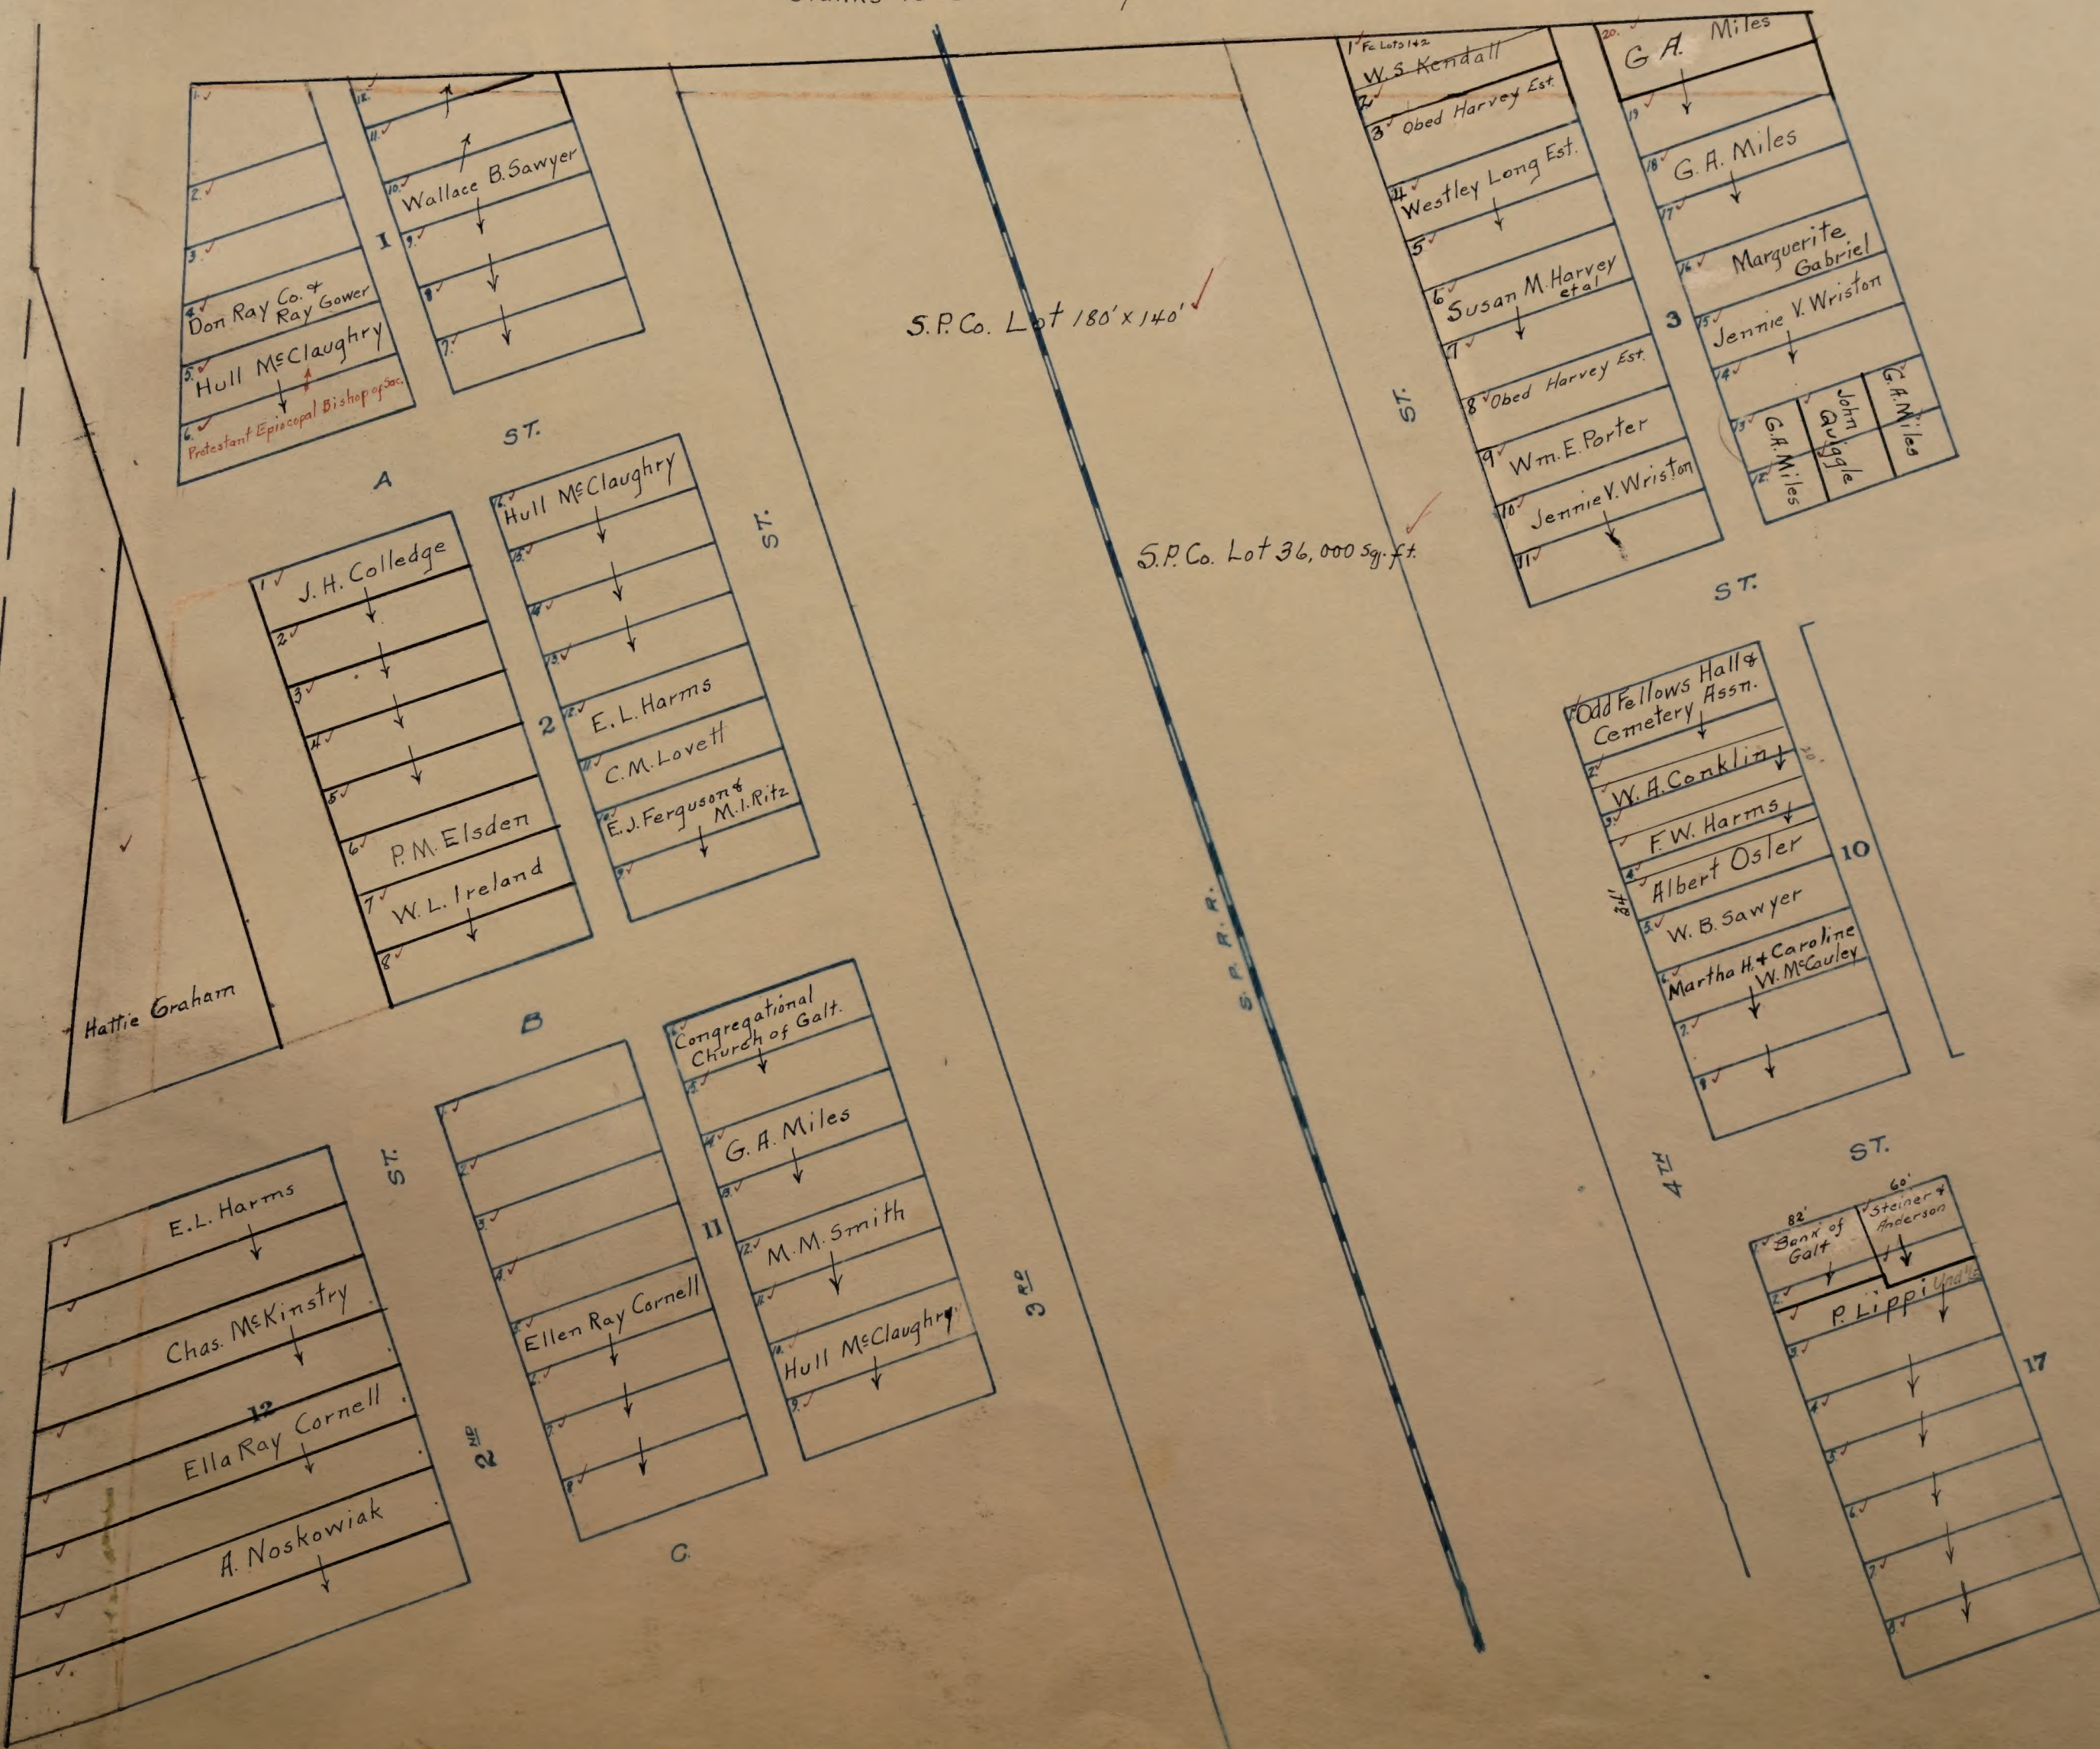


GALT.

GALT, S.D.

Scale 100 feet = 1 inch.

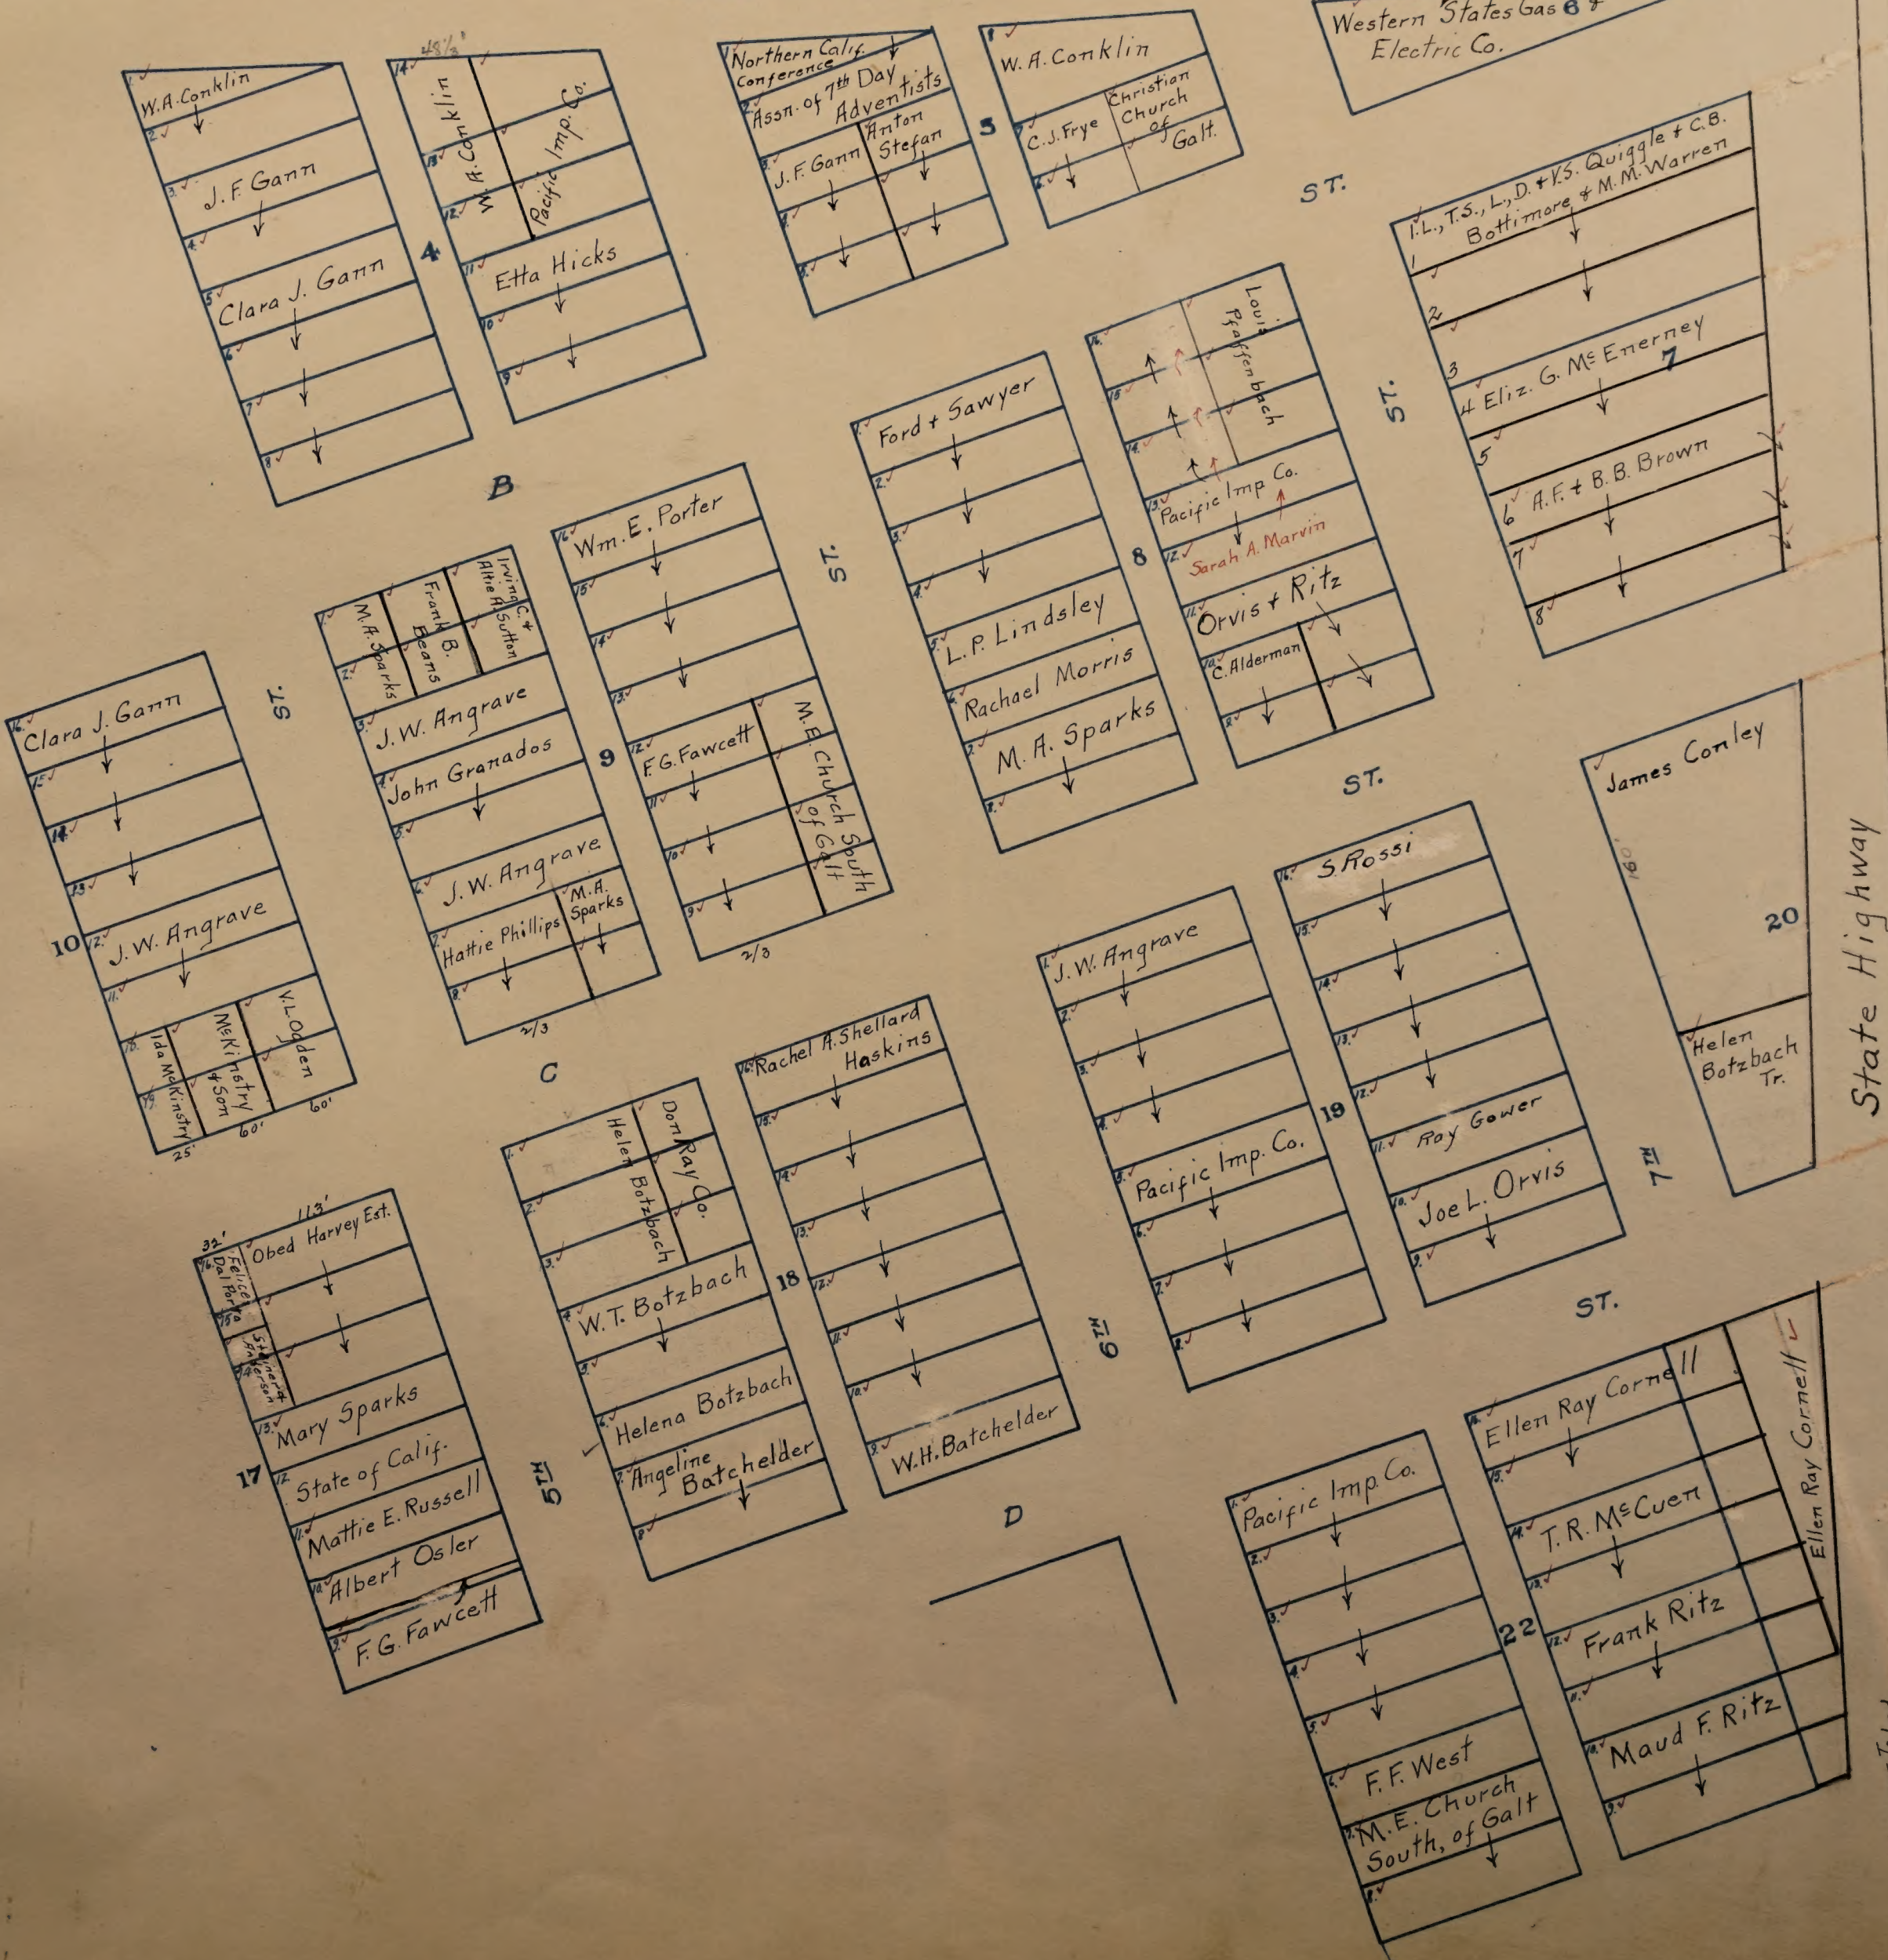

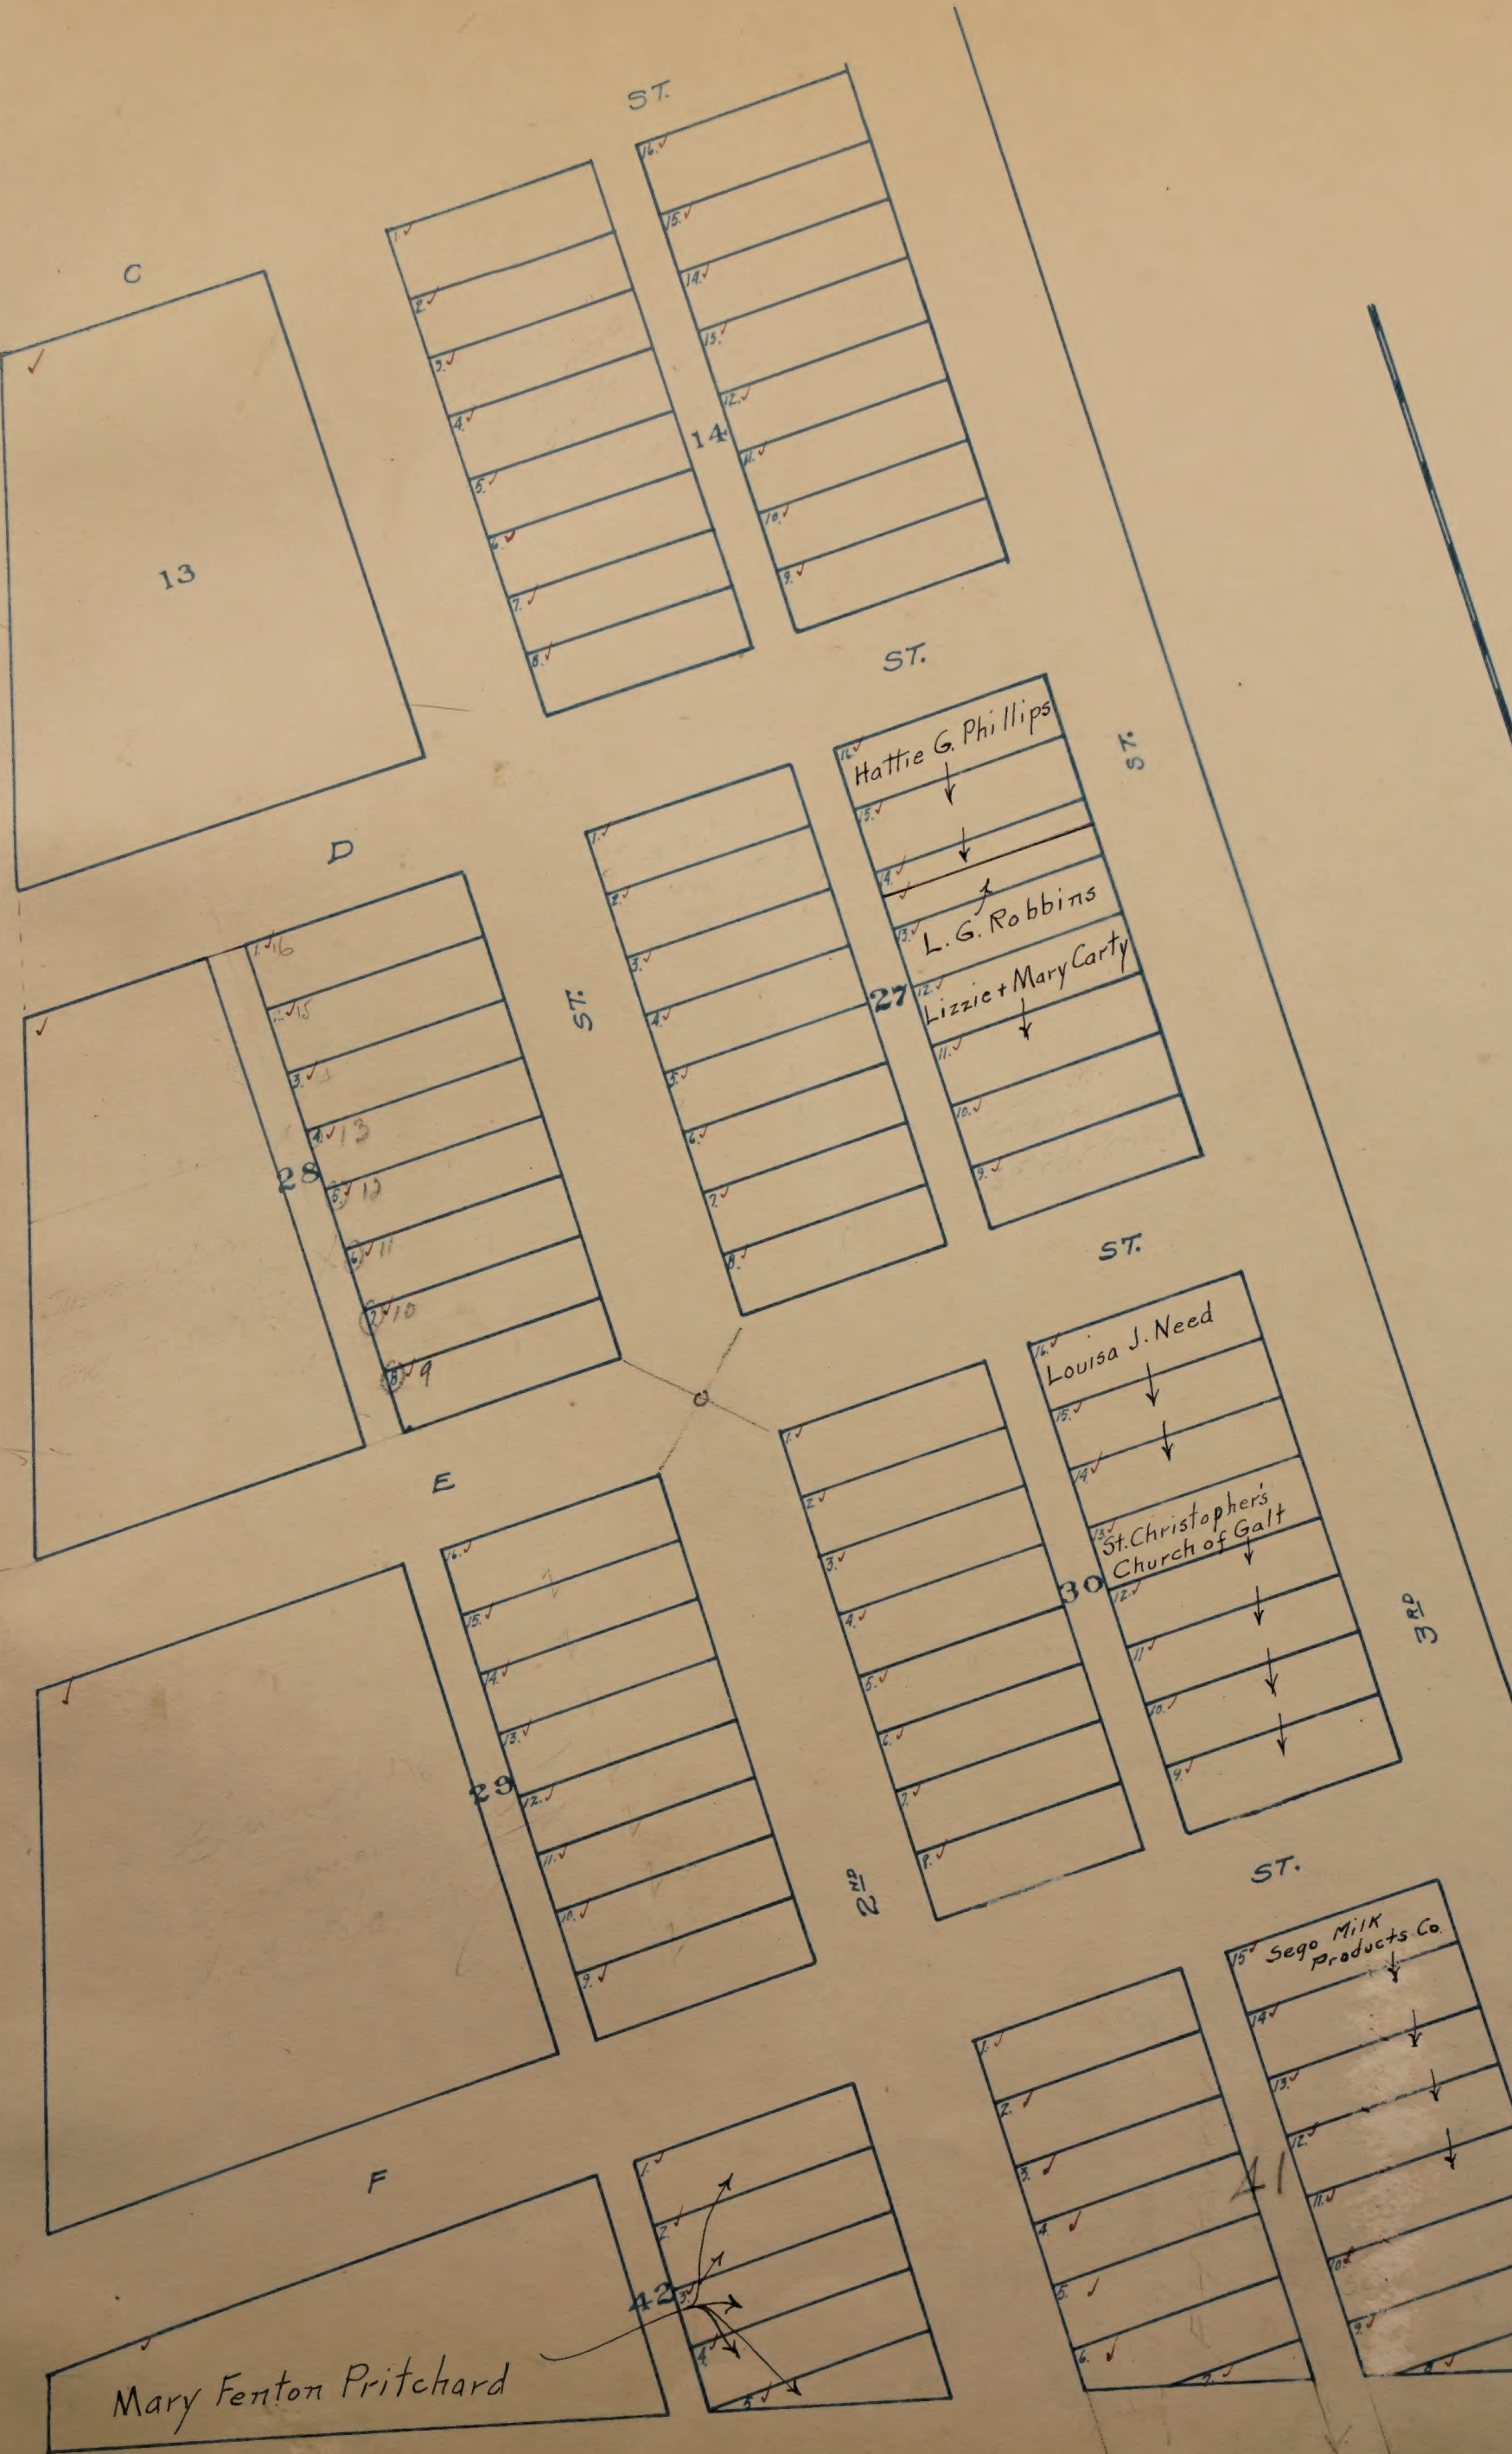

GALT.

Scale 100 feet = 1 inch.

Blanks to Obed Harvey Est.

GALT, S.D. ✓

Blanks to Pacific Imp. Co.


GALT. ✓

Scale 100 feet = 1 inch.

Galt SD.



All Lots 1 Acre unless otherwise noted

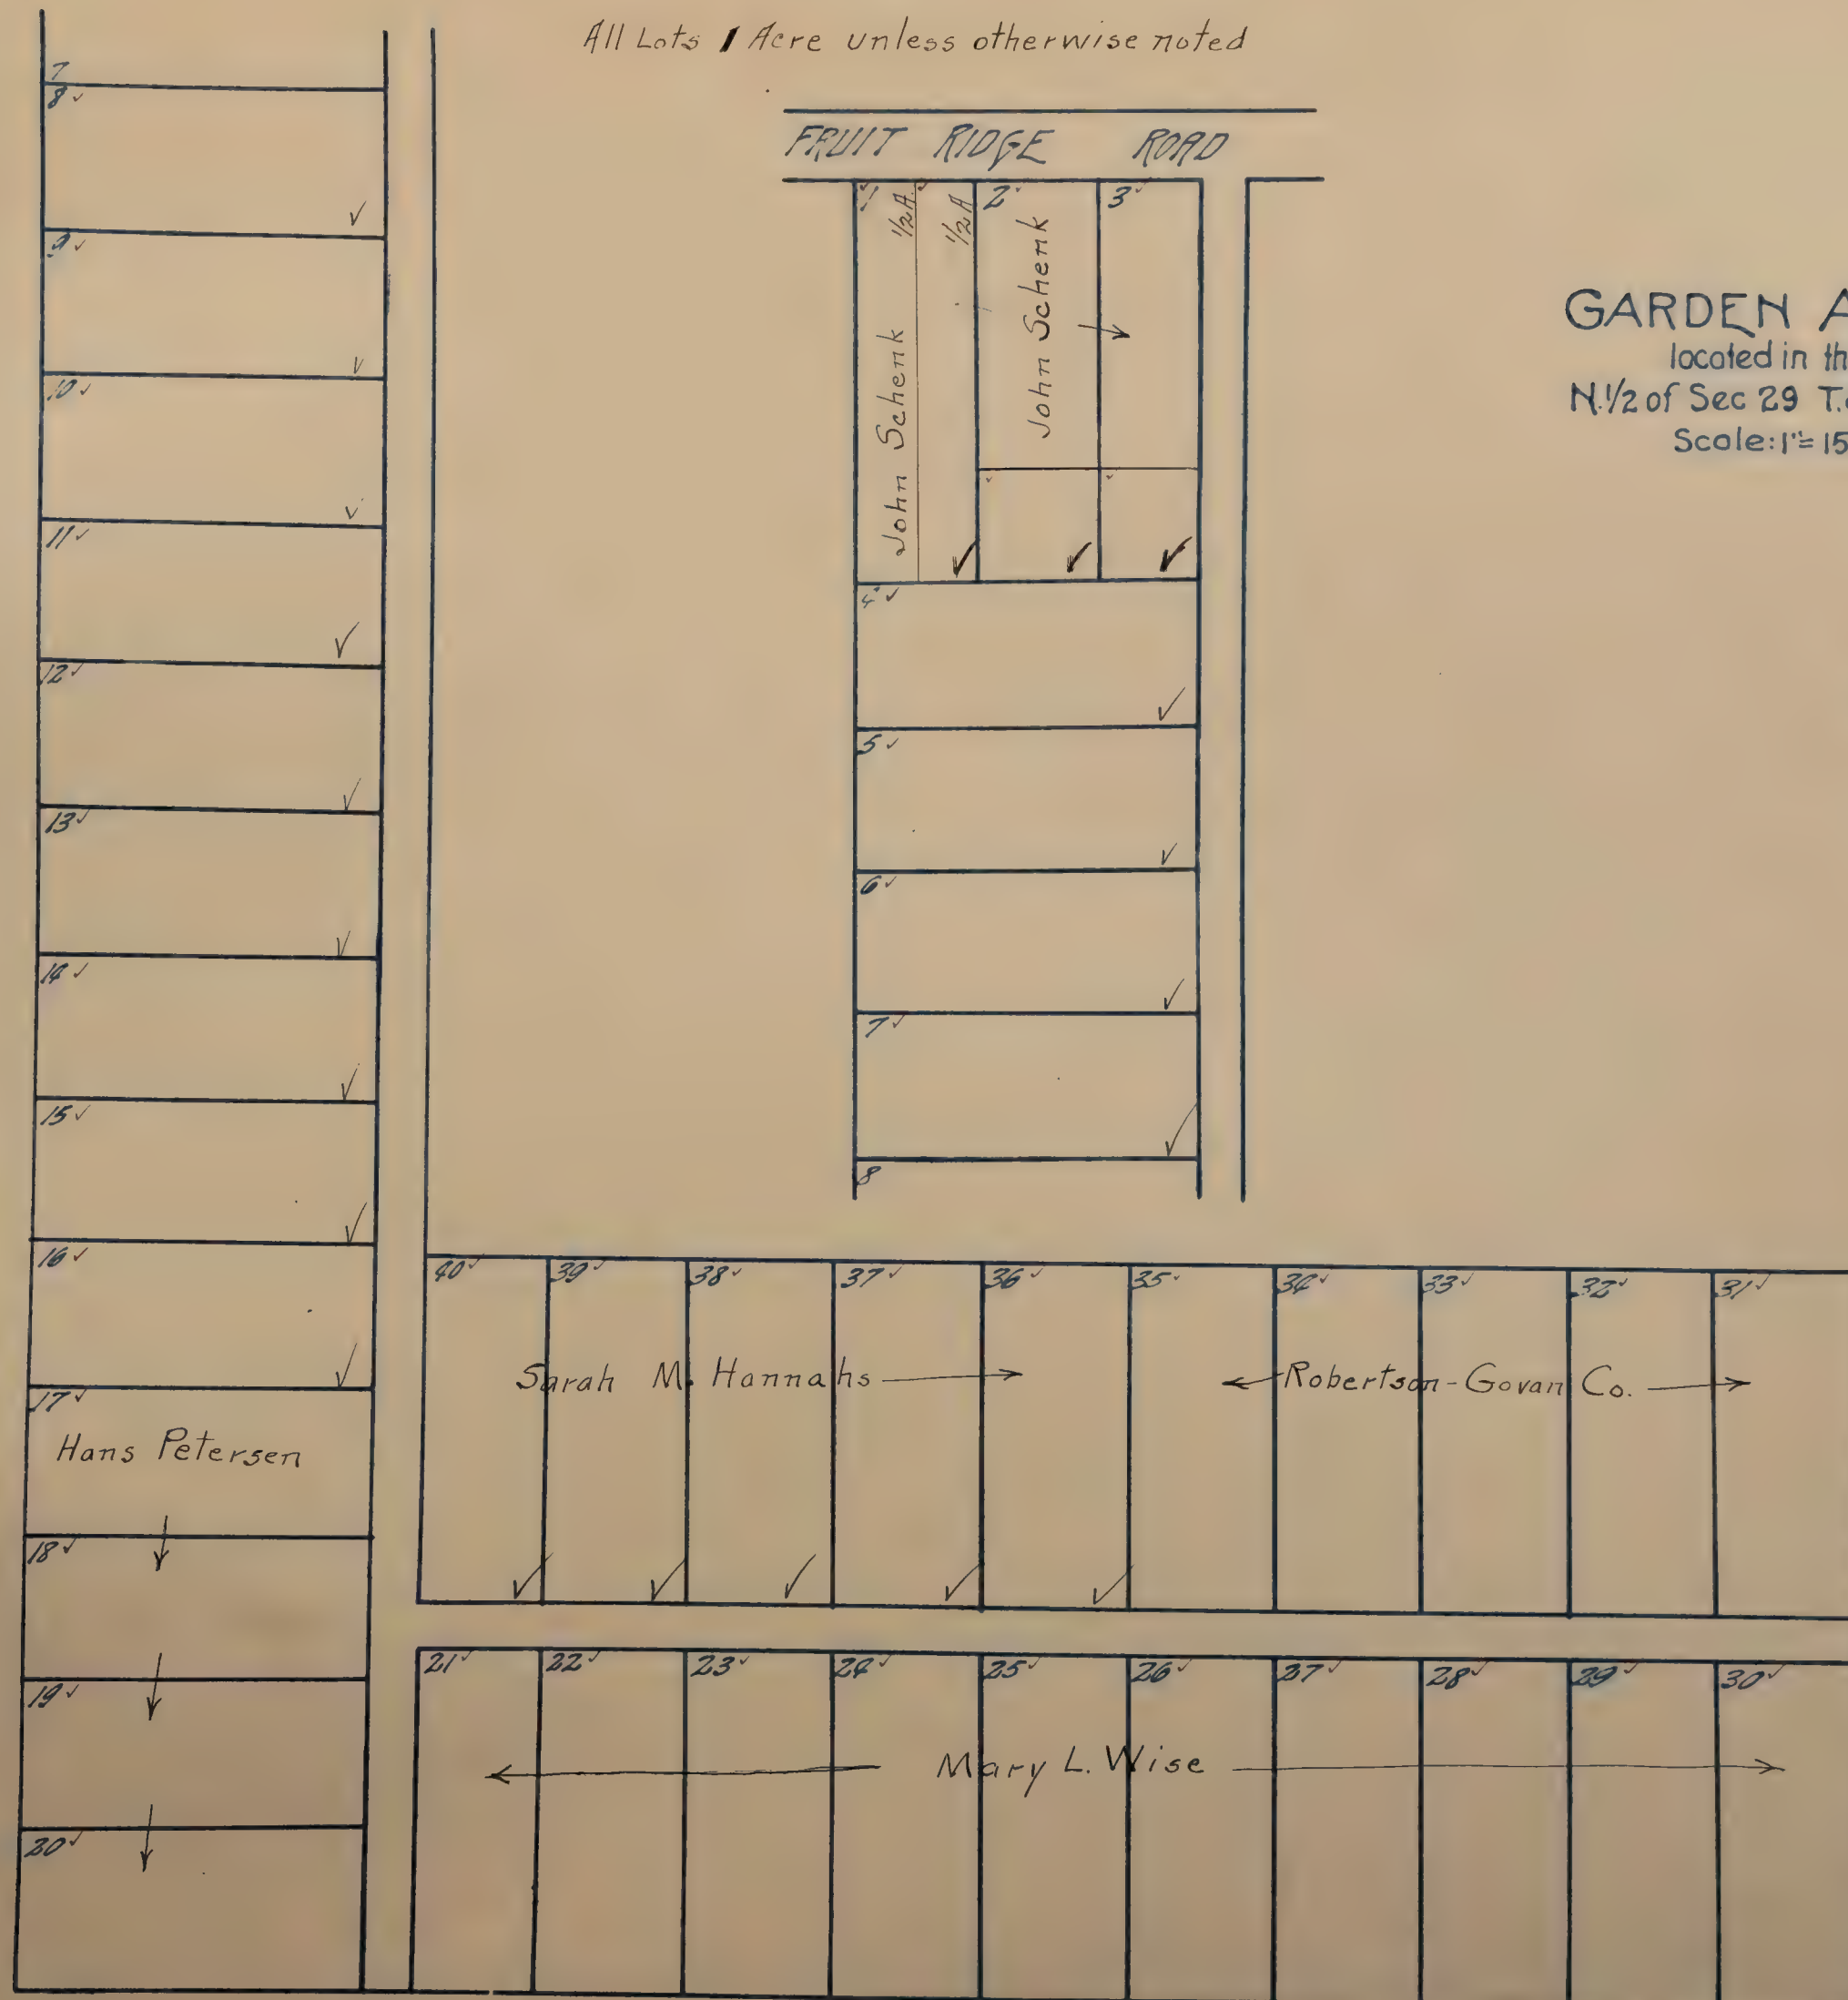

Scale: 1" = 150'

Goldberg S.D.

FRUIT RIDGE, S.D.


Garden Acres

GARDEN DALE ✓

located in
N.W. 1/4 of Sec. 6 T. 7 N. R. 5 E.
Scale: 1" = 400'

Pacific S.D.

Blanks to C.M. Goethe

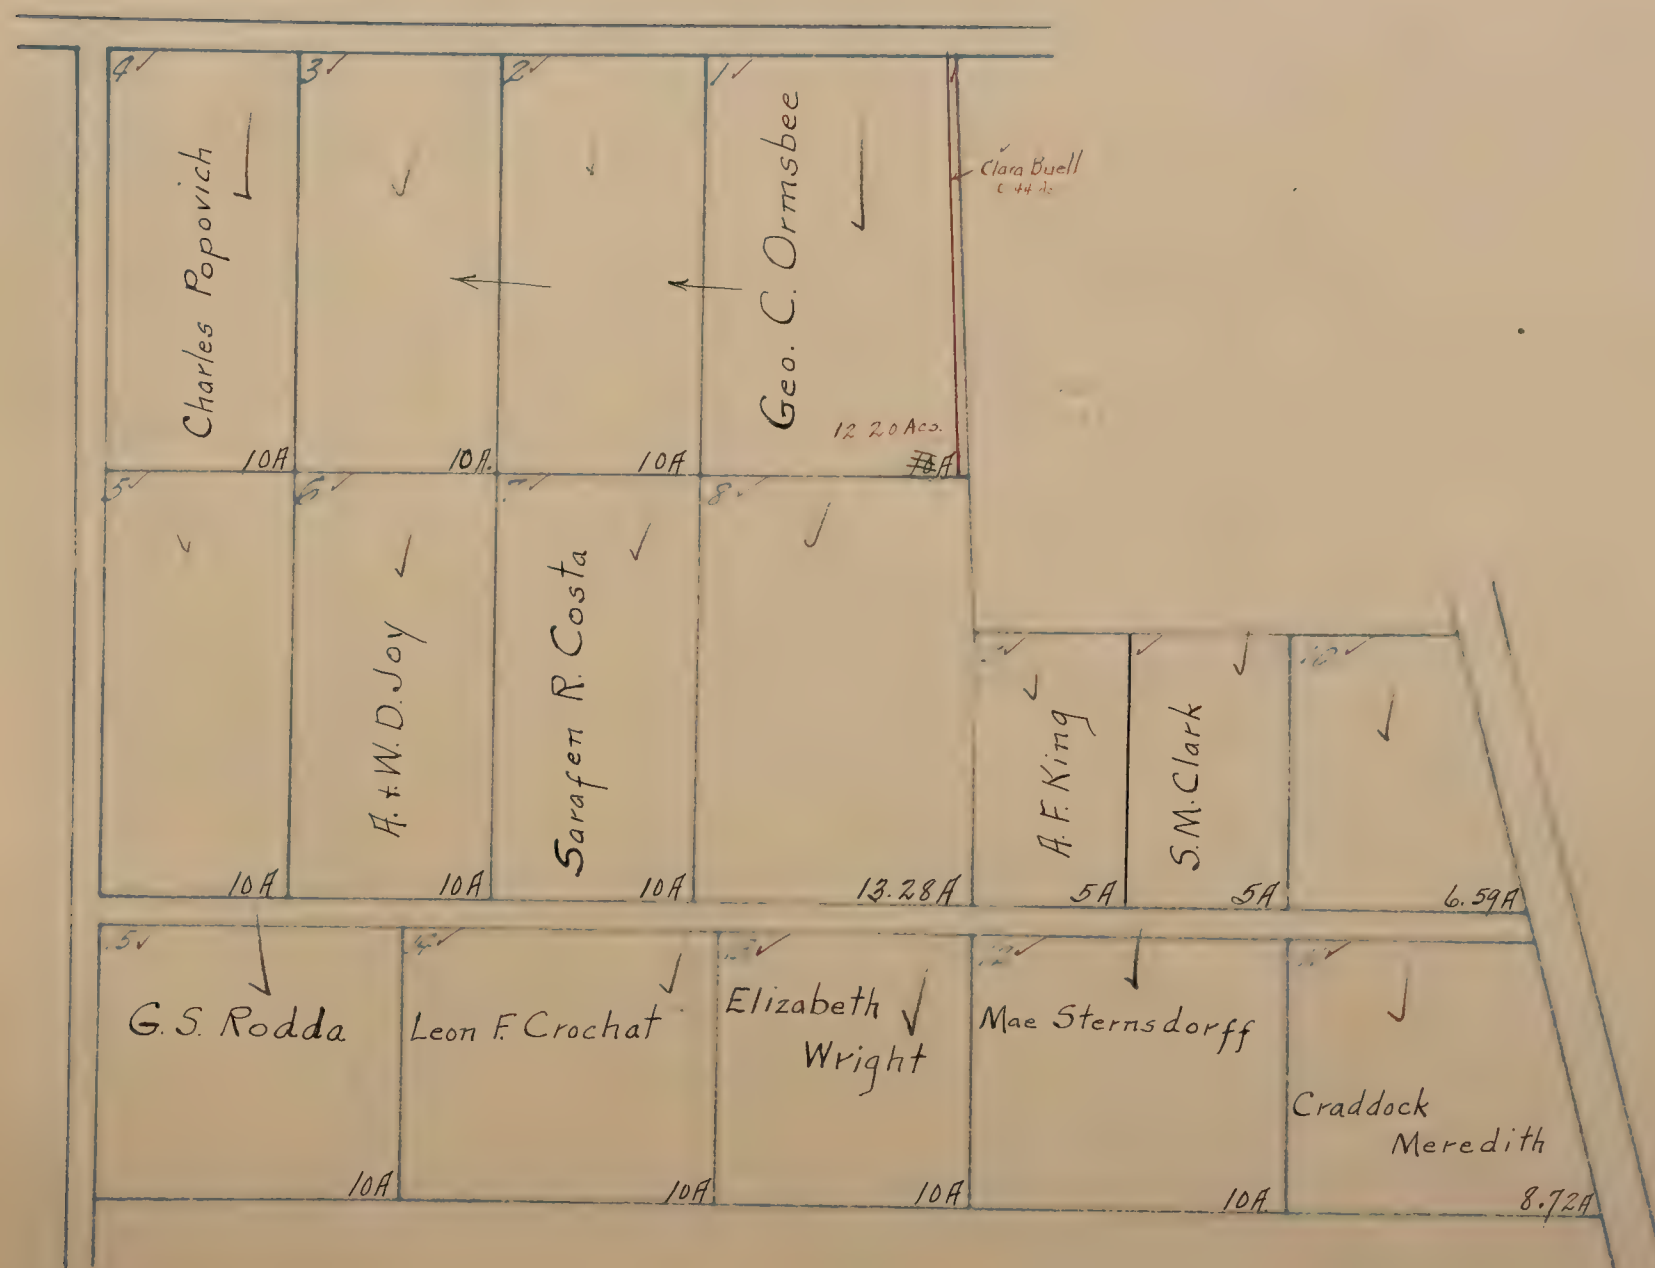


GERHARDT TRACT

SEC. 30 T. 8 N. R. 5 E.

Scale 3 Chains = 1 Inch.


PACIFIC S. D.

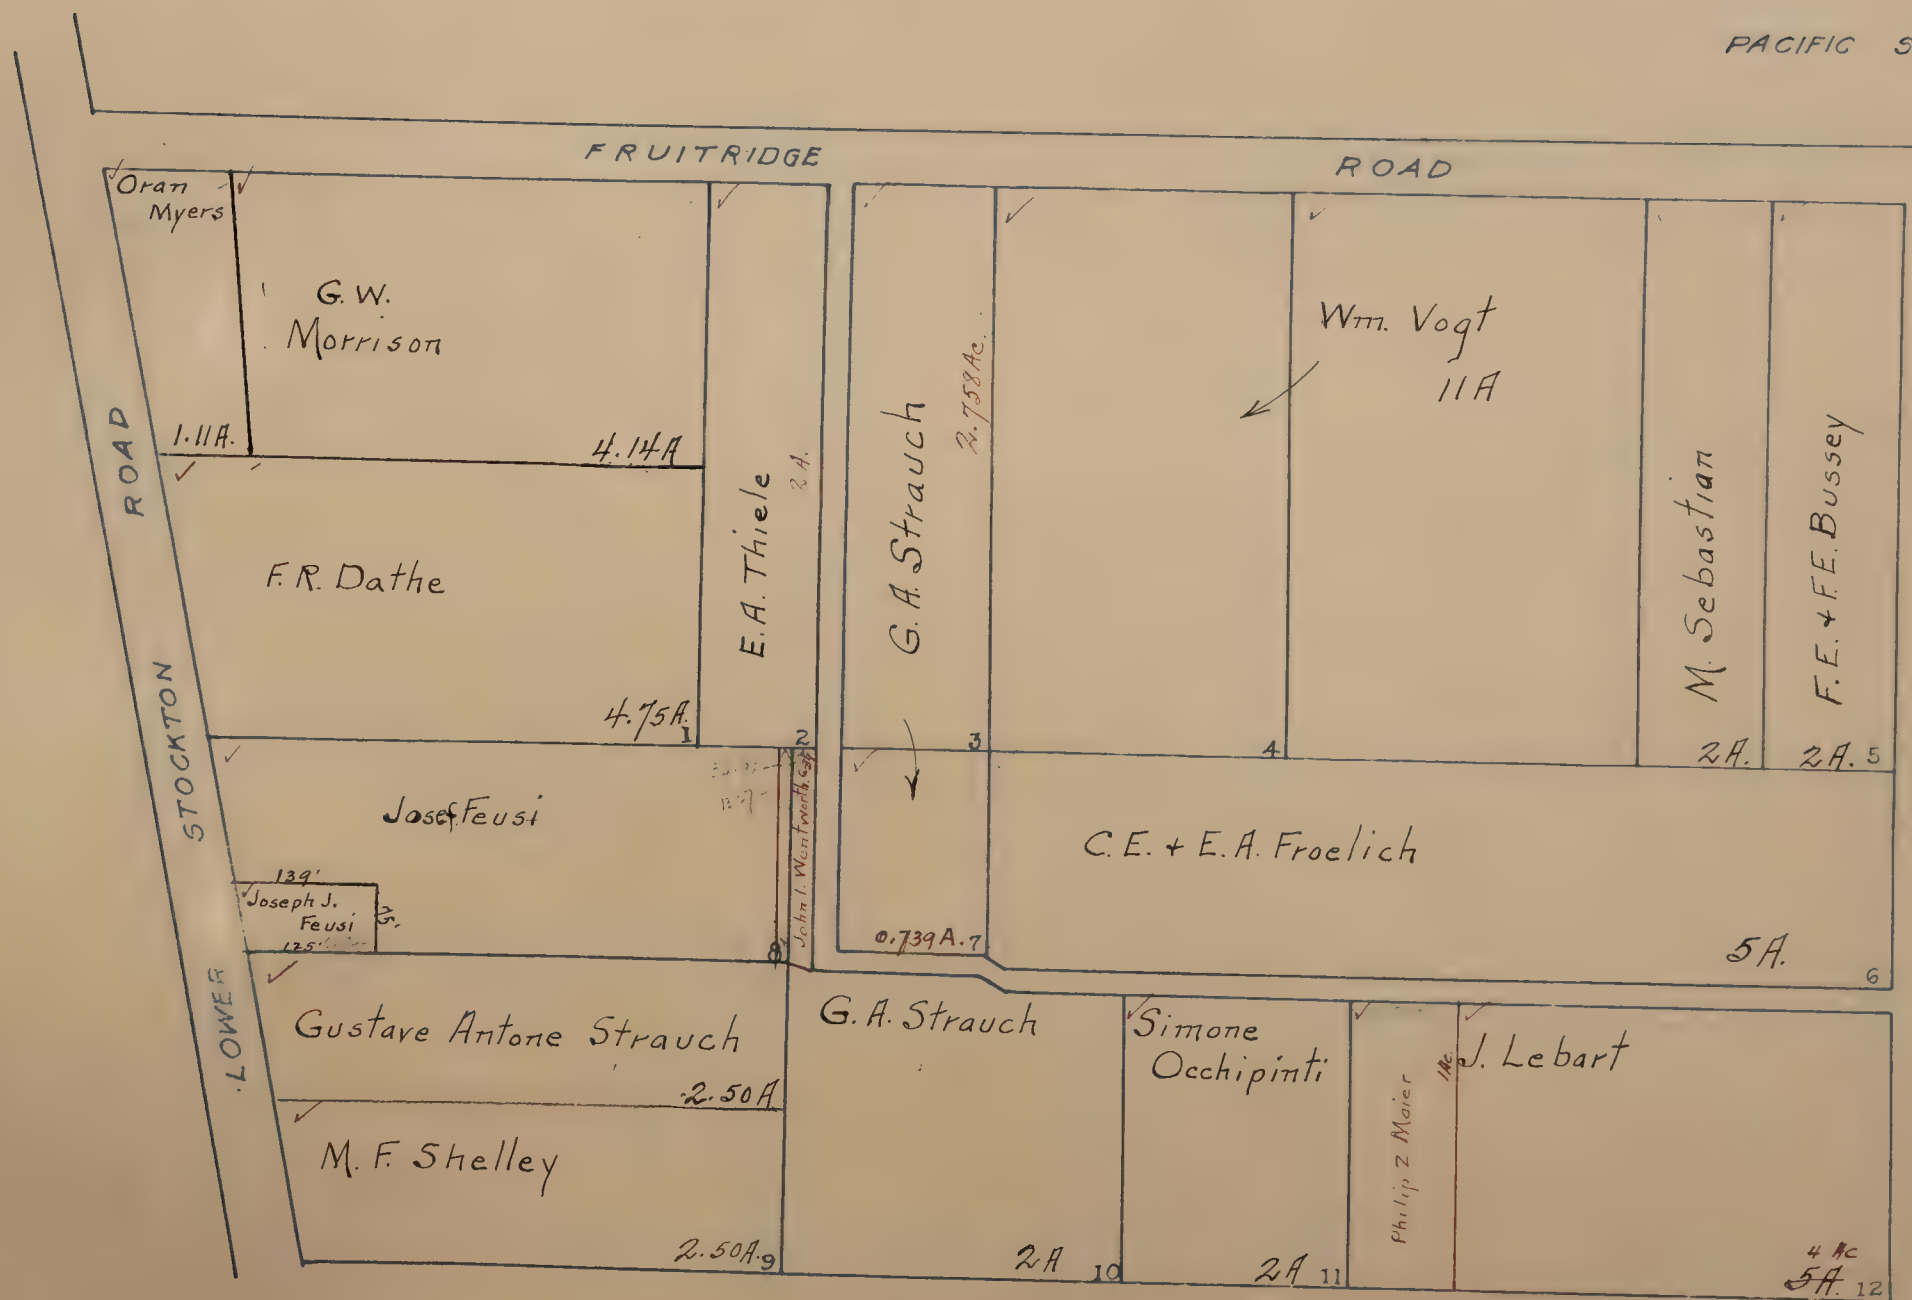

Gillen Oaks.
Lot 2 Block 13 Subdivision No 3
Scale: 1" = 50'

North Sacramento, S.D

Blanks to J.C. Carly Co.

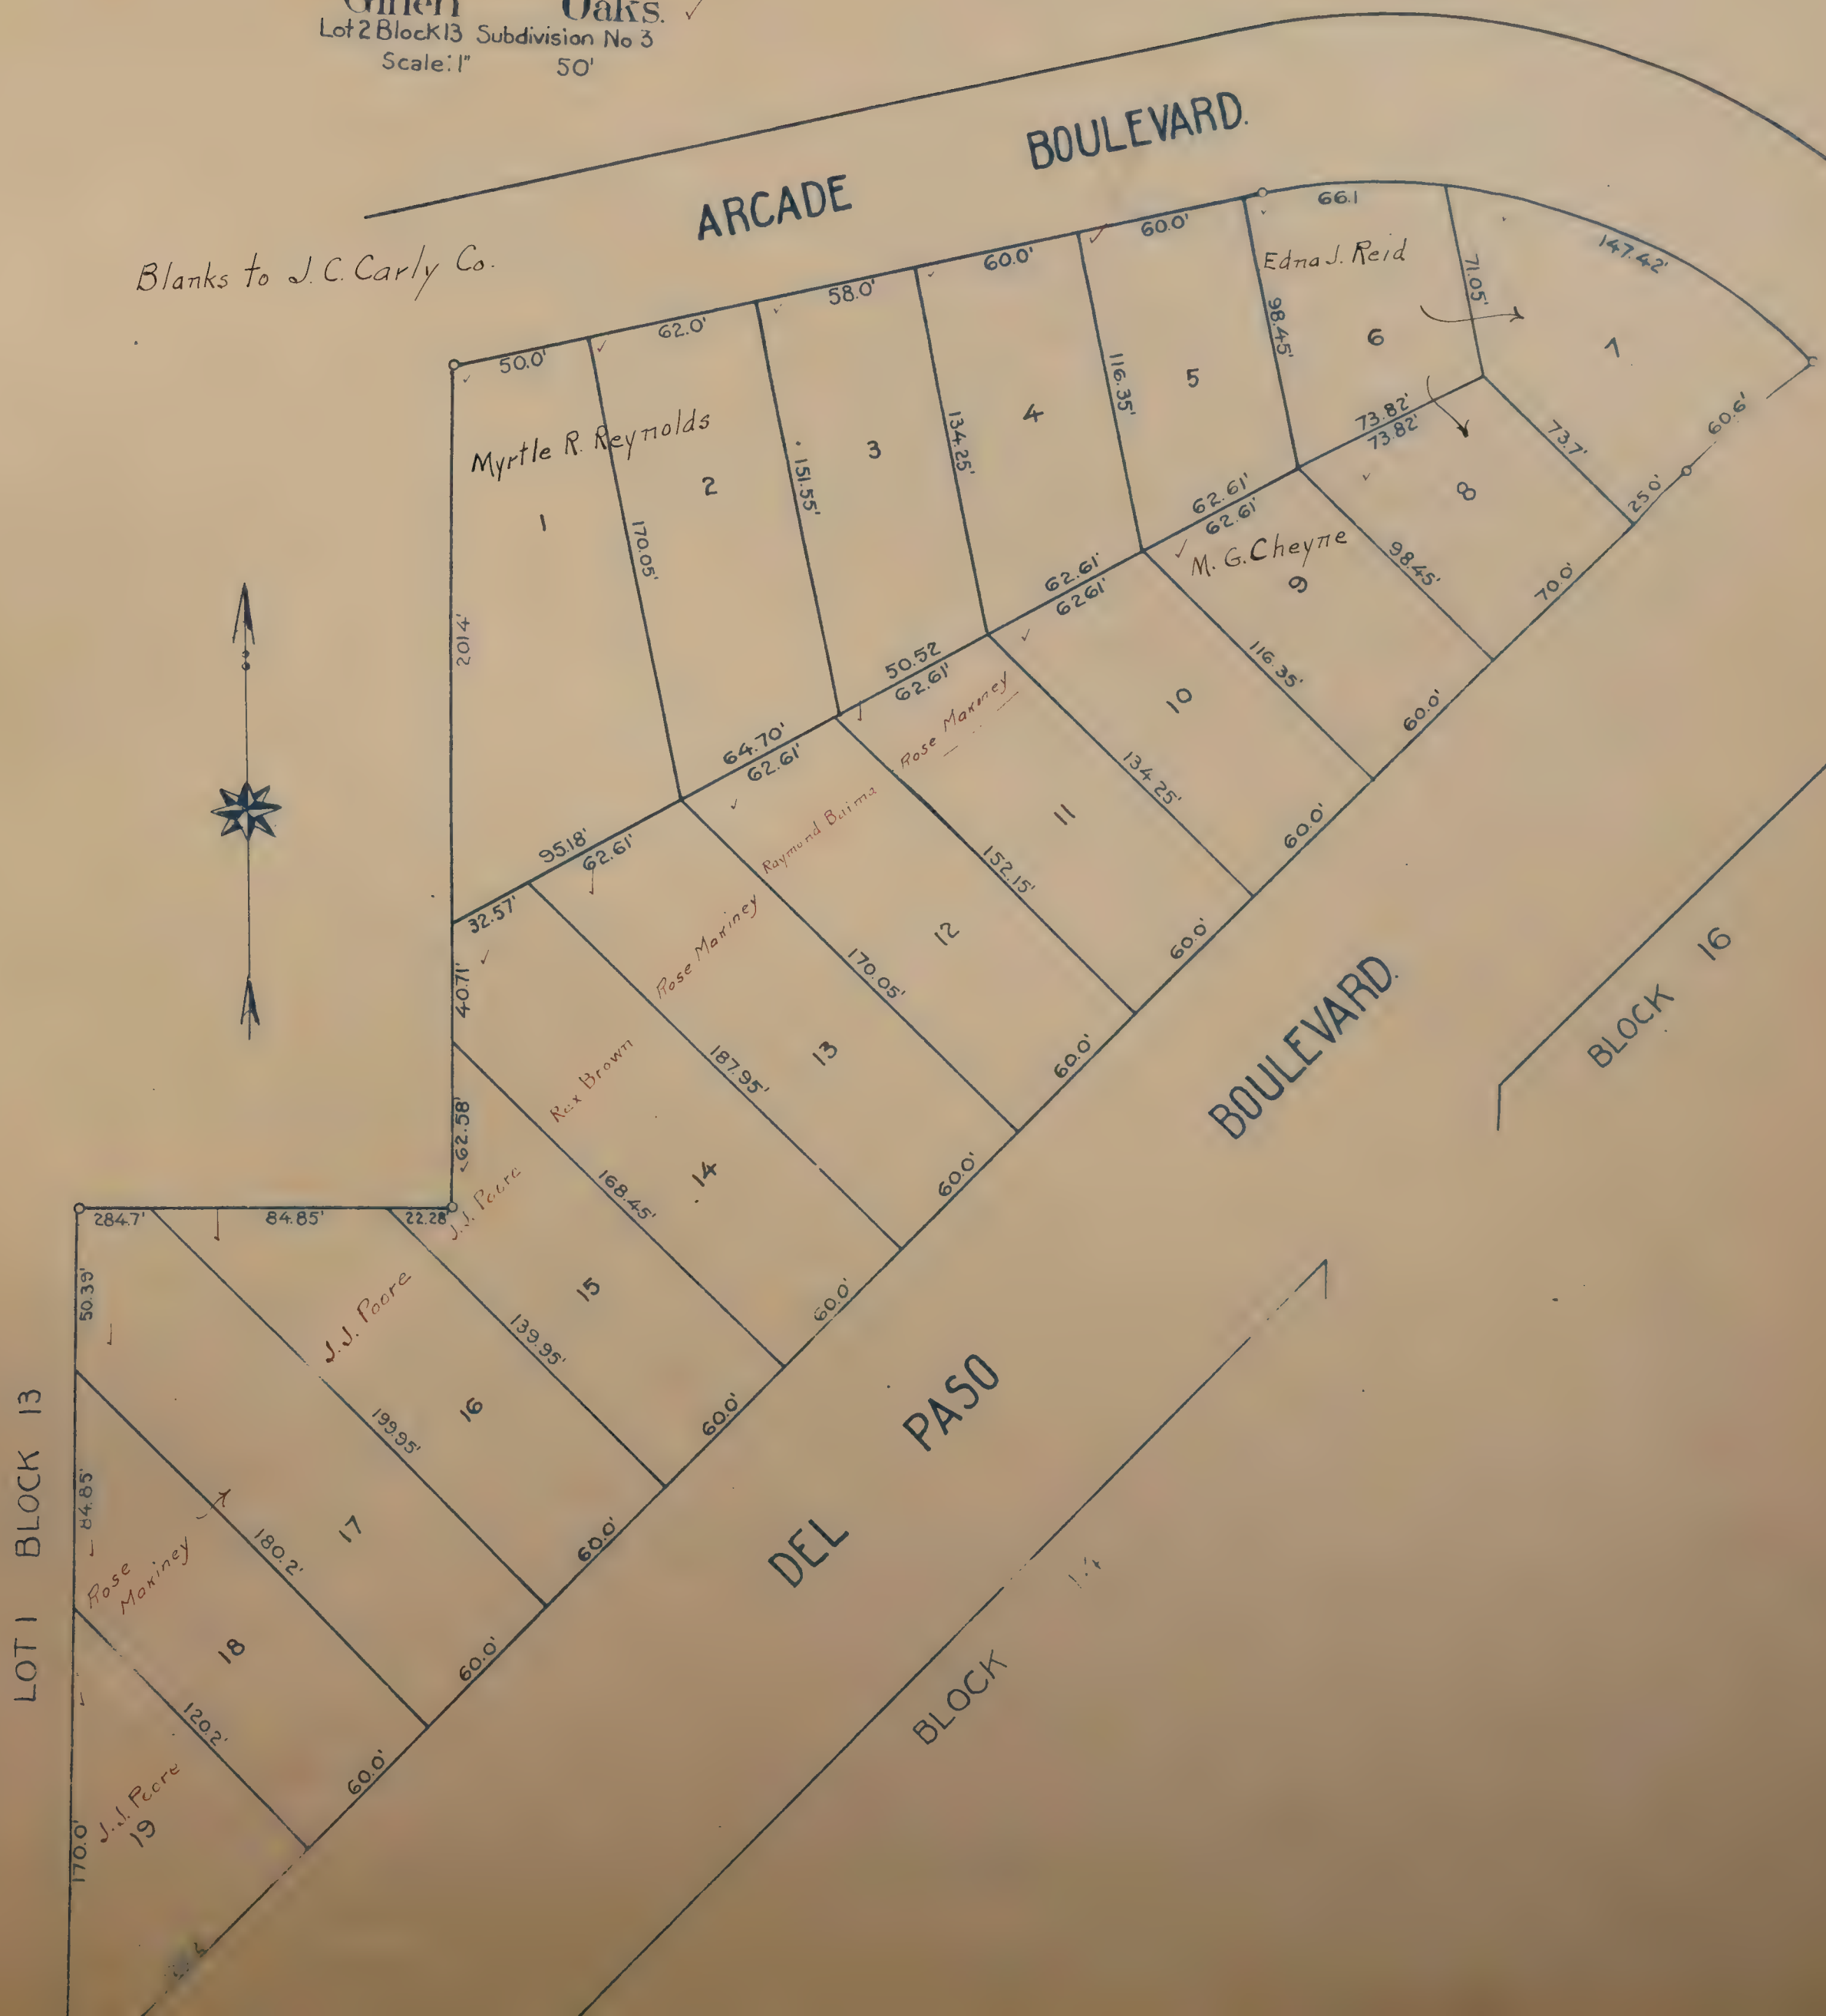


GOETHE ADDITION M ✓

SECTION 20 T8 N. R 5 E.

Scale 50 feet 1 inch

Fruit Ridge, S.D.

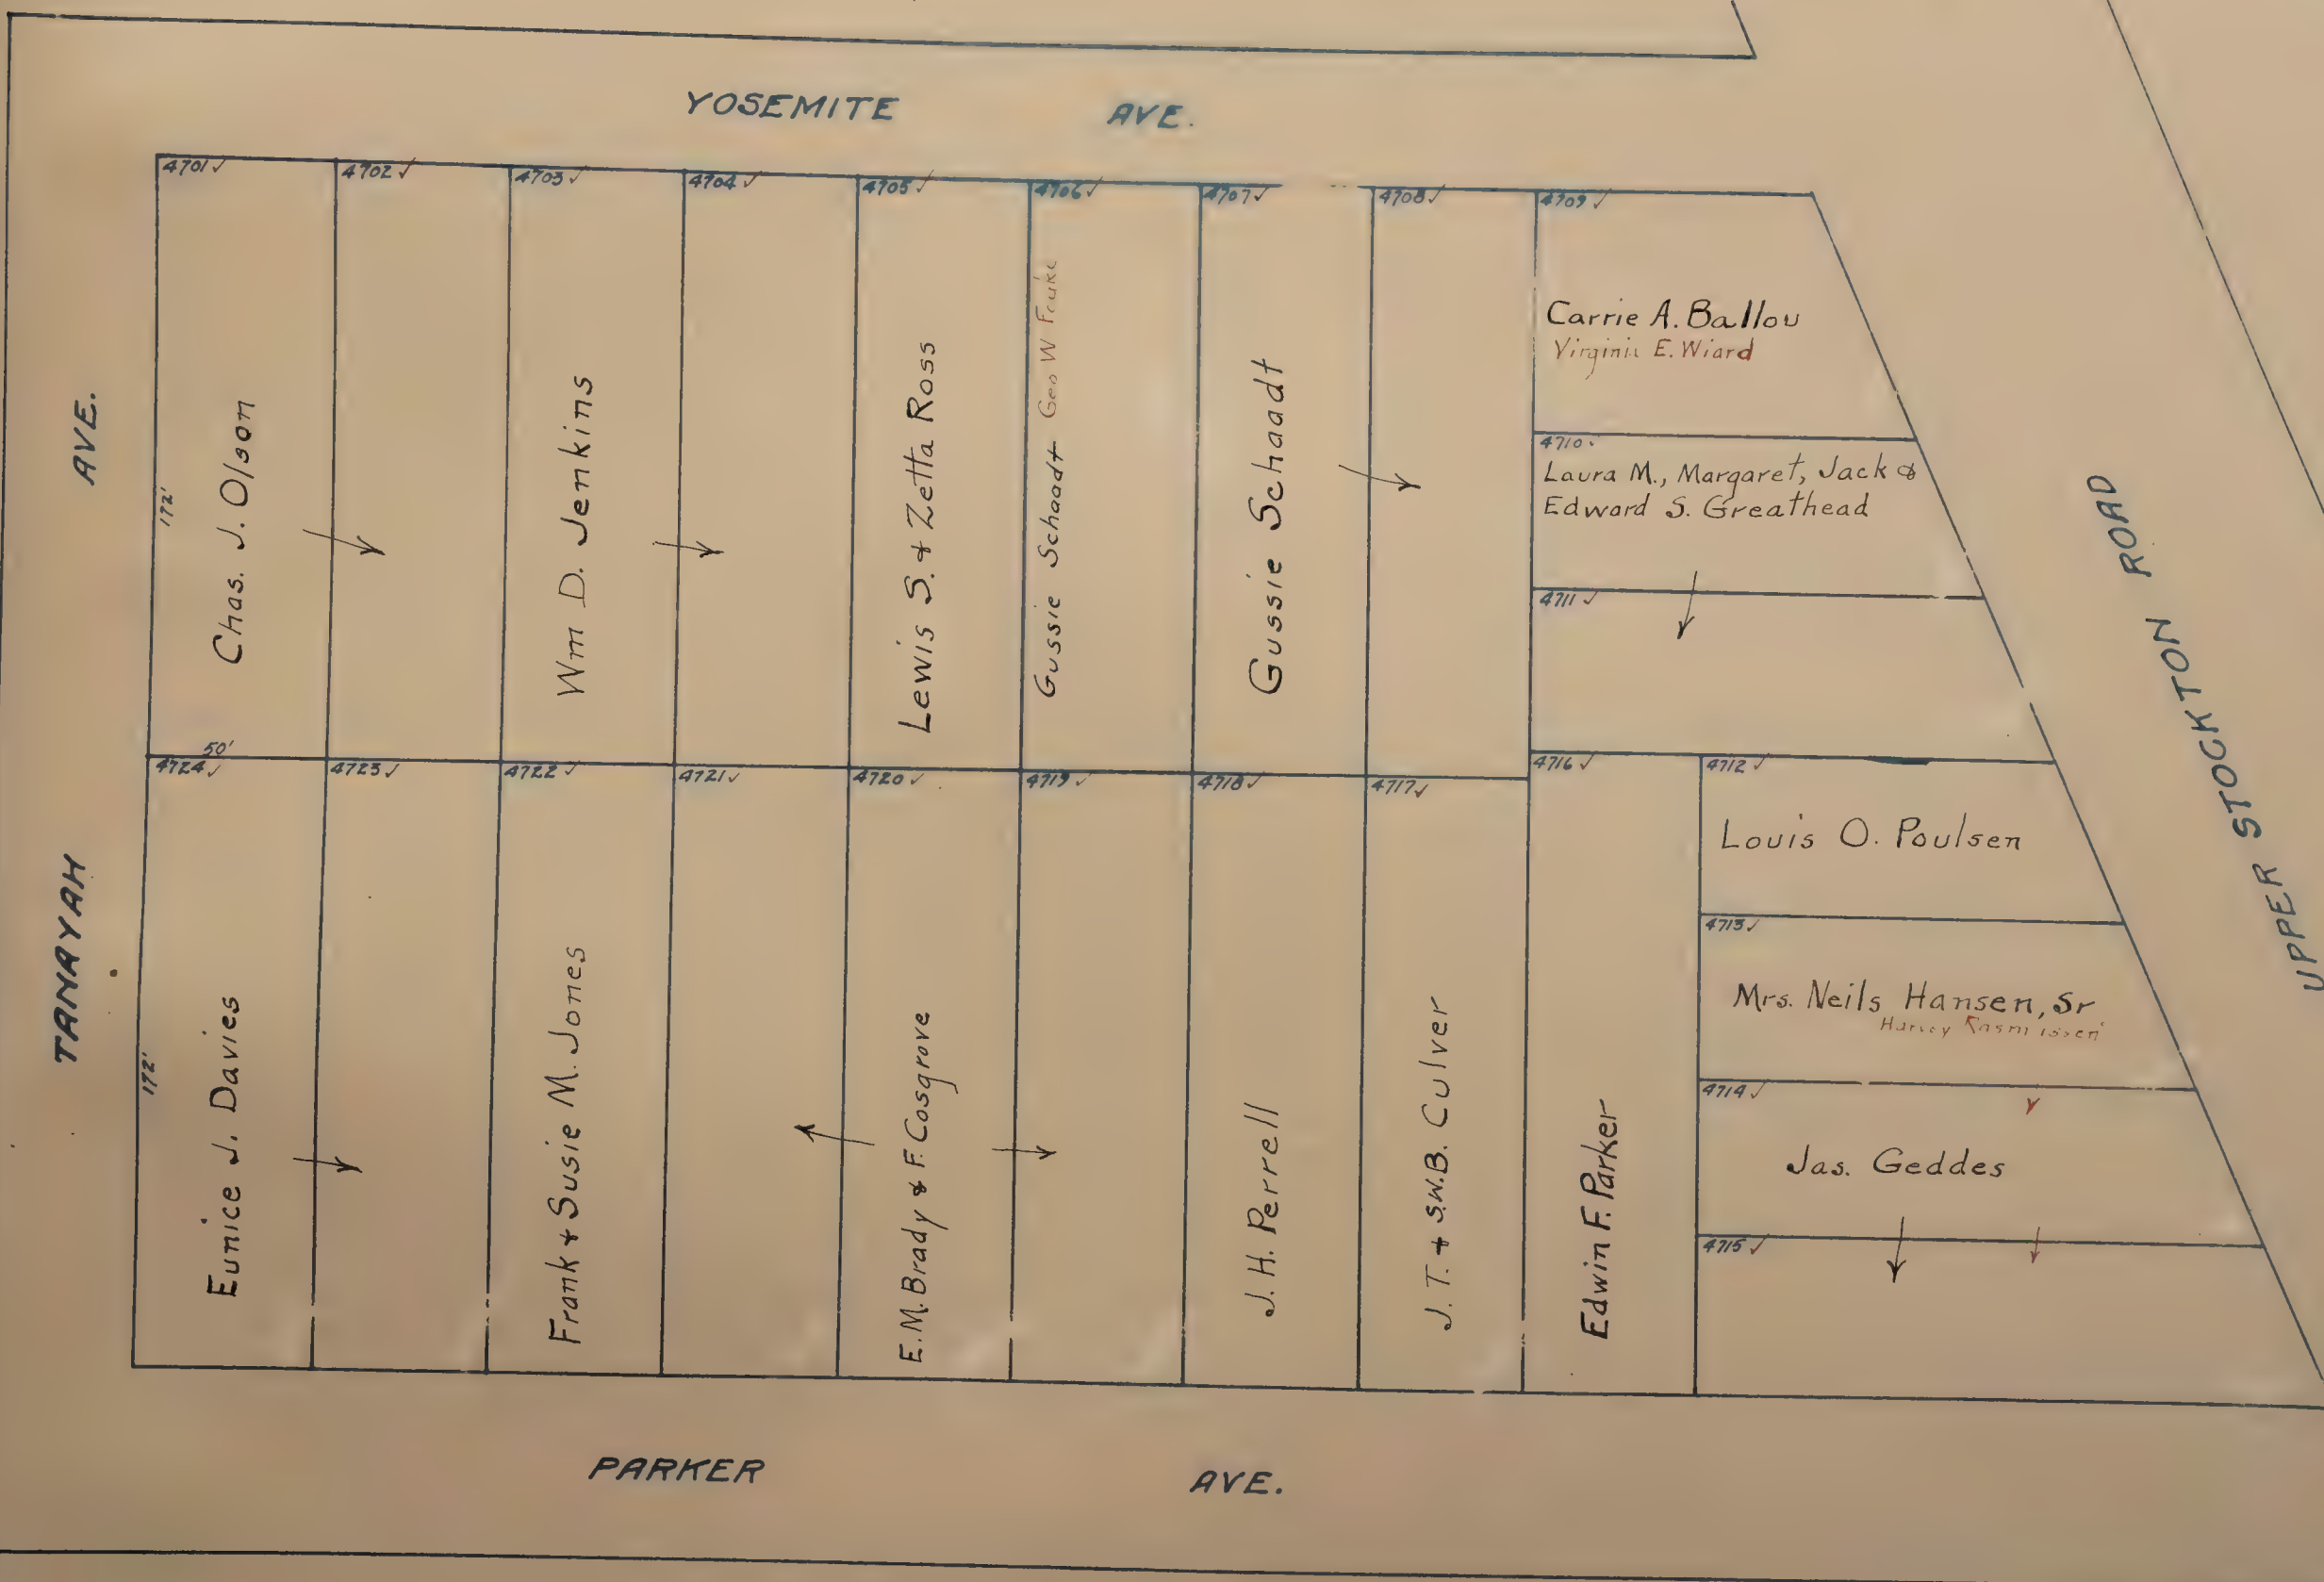

GOETHE COLONY N^o 7 & 9 ✓

N^o 7
N.E. ¼ SEC. 10 T 6 N R 5 E
Scale 400 feet = 1 in

Goethe, S.D.

1 ✓	2 ✓	3 ✓	4 ✓
Alfred G. Eddy	Harriett G. Eddy	Harriett G. Eddy	
19 ½ A.	19 ½ A.	19 1 A	
19.7 A.			19.7 A.
8 ✓	7 ✓	6 ✓	5 ✓
Ralph Newman			Fred & Katherine Kammerer
1 A.			Anna Deming
18.7 A.	7.70 A	11.50 A	19.70 A
		9.85 A	10 A

N^o 9
S.W. ¼ SEC. 10 T 6 N R 5 E.
Scale 400 feet = 1 in

Franklin, S.D.

Goethe, S.D.

901 ✓	902 ✓	903 ✓	904 ✓
Edw. W. Wittenberg			
20 A	20 A	20 A	20 A
906 ✓	907 ✓	908 ✓	909 ✓
David Lippert		Phillipp & Elisabeth Wanner	
20 A	20 A	20 A	20 A


GOETHE COLONY N° 10, 11 & 17 ✓

N° 10

S.E. 1/4 SEC. 10 T 6 N. R 5 E.

Scale 300 feet = 1 inch

Goethe
~~Franklin~~ S.D.

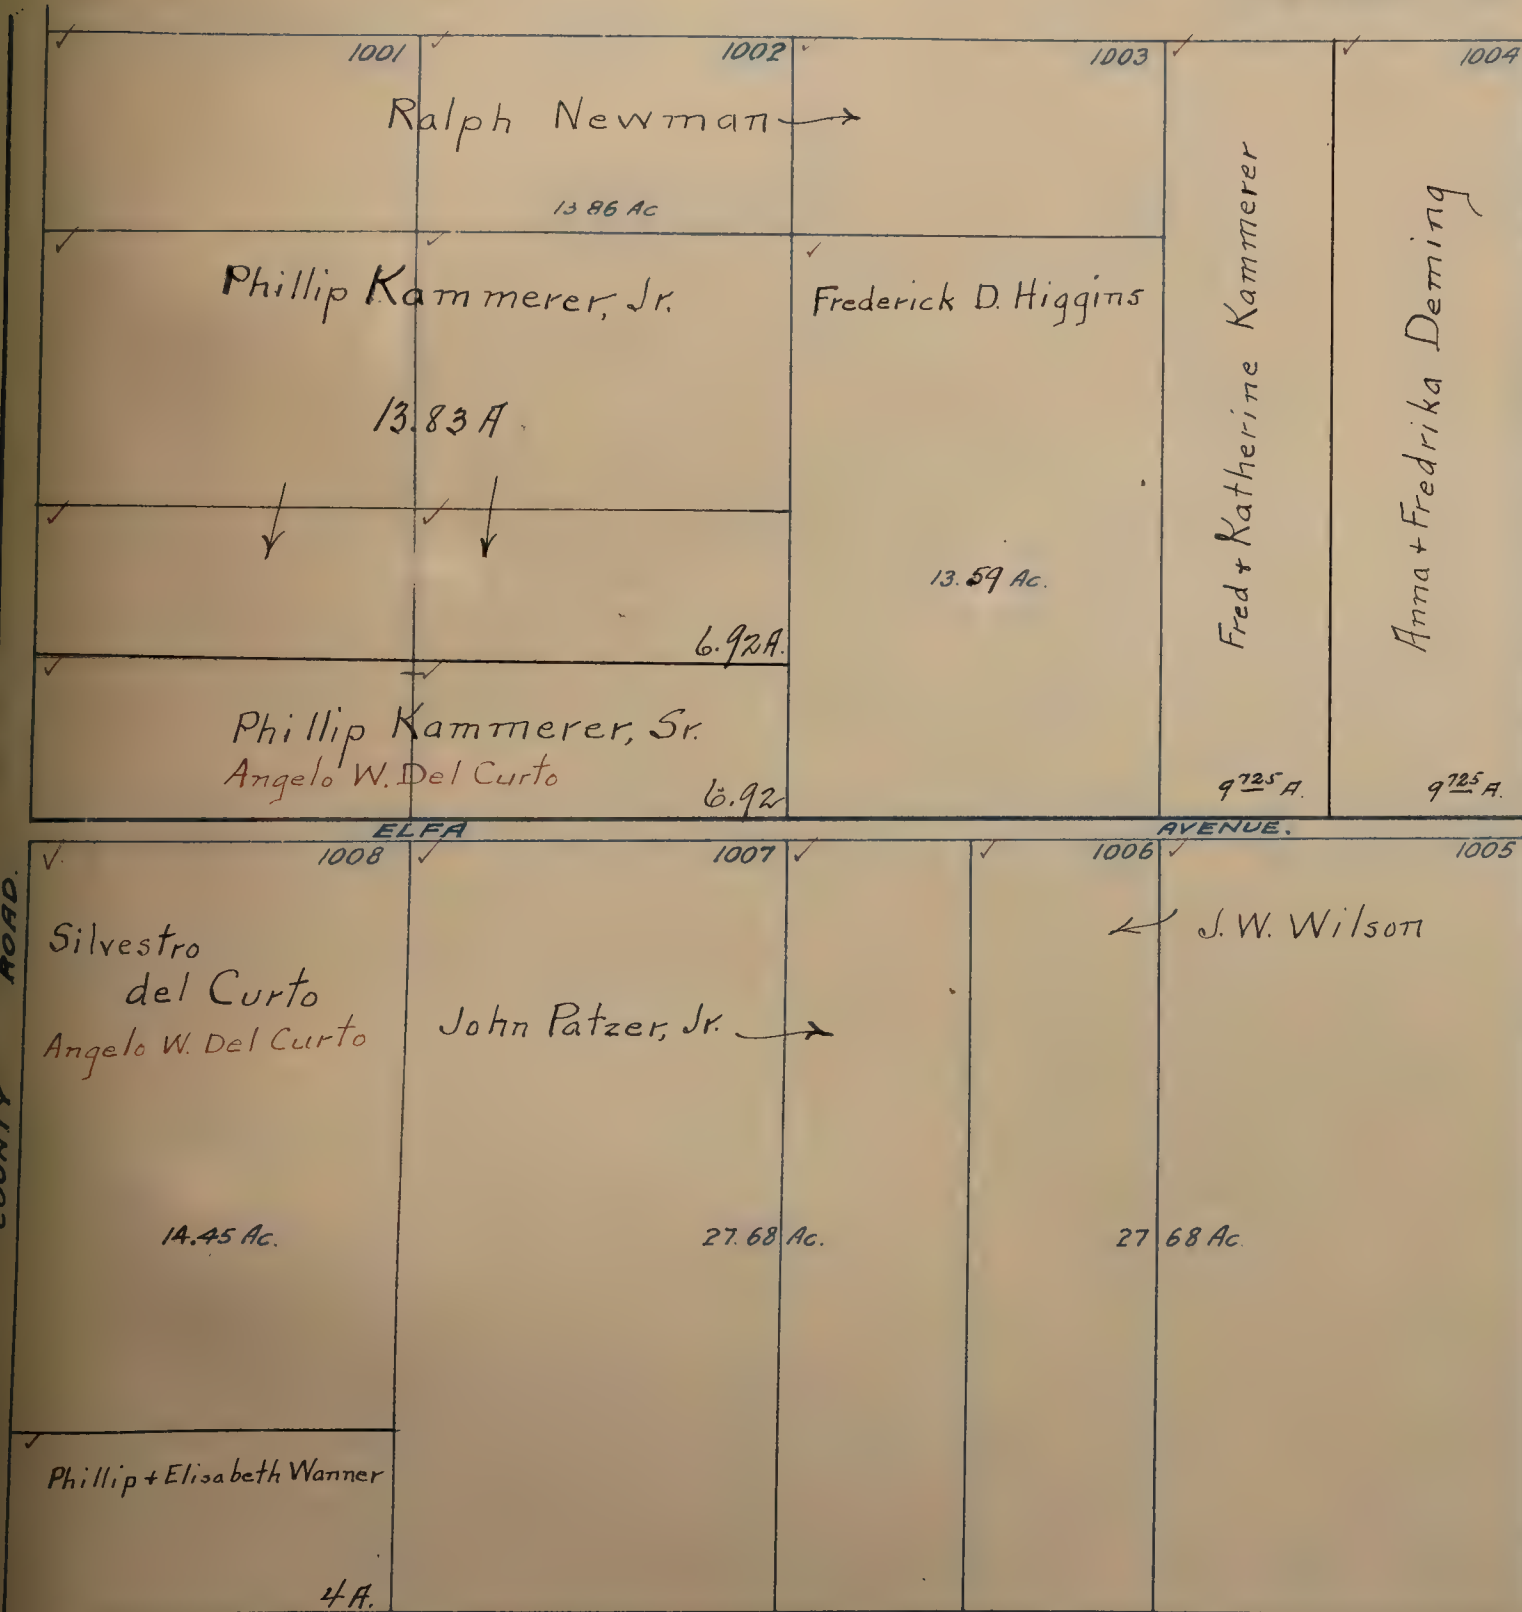

N° 11

N° 17

S.W. 1/4 & W 1/2 SEC'S 9 & 16 T 7 N. R 6 E.

Scale 10 chains = 1 inch

Reese S.D.




GOETHE COLONY N^o 29 ✓

N.W. 4 SEC. 10 T. 8 N. R. 5 E.

Scale 5 chains = 1 inch.

Goethe, S.D.

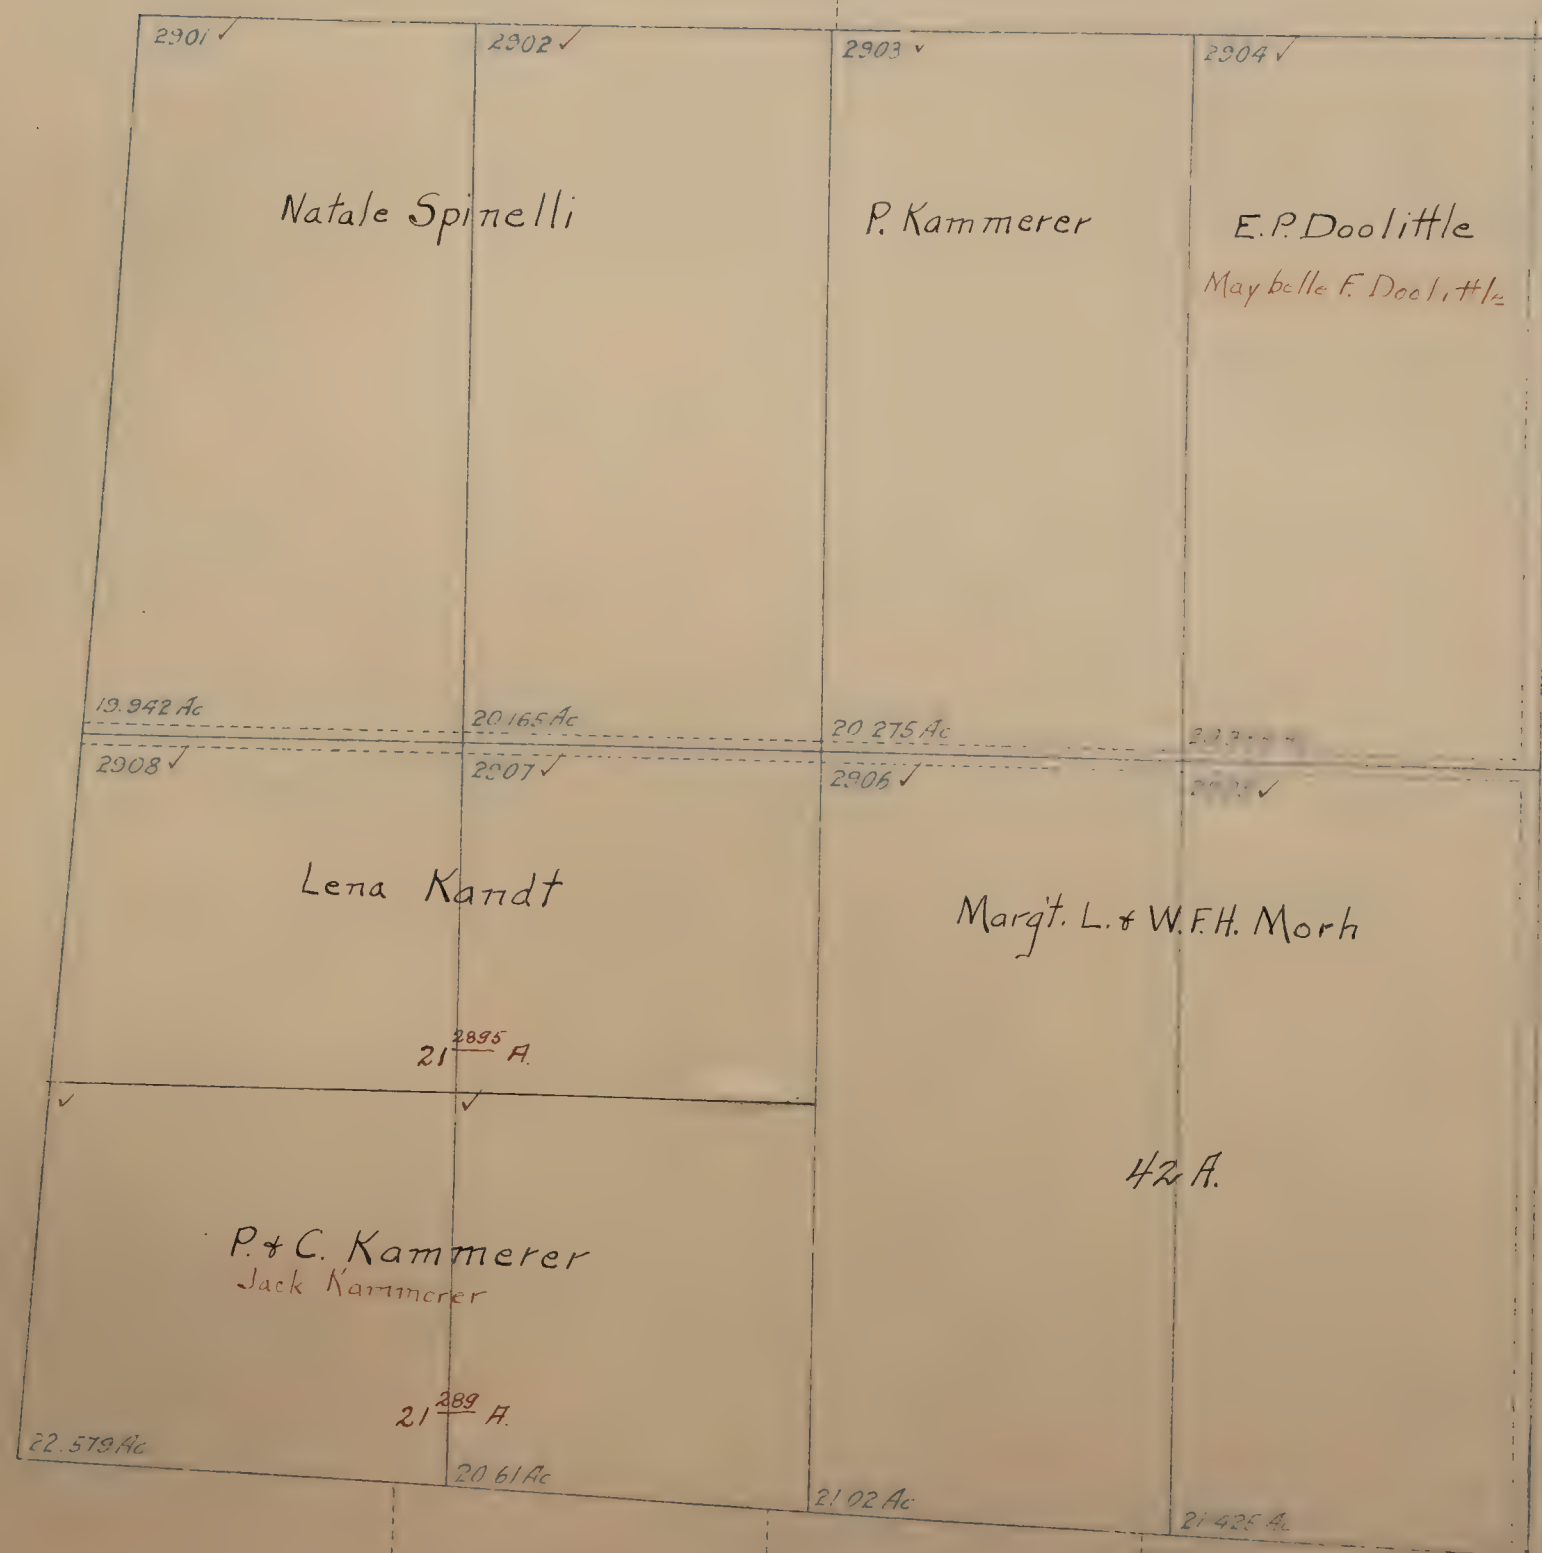

Colony No. 29


Colony No. 29

GOETHE COLONY N°31 ✓

N½ SECTION 4 T.7 N. R. 5 E.

Scale 5 chains - 1 inch

Florin, S.D.

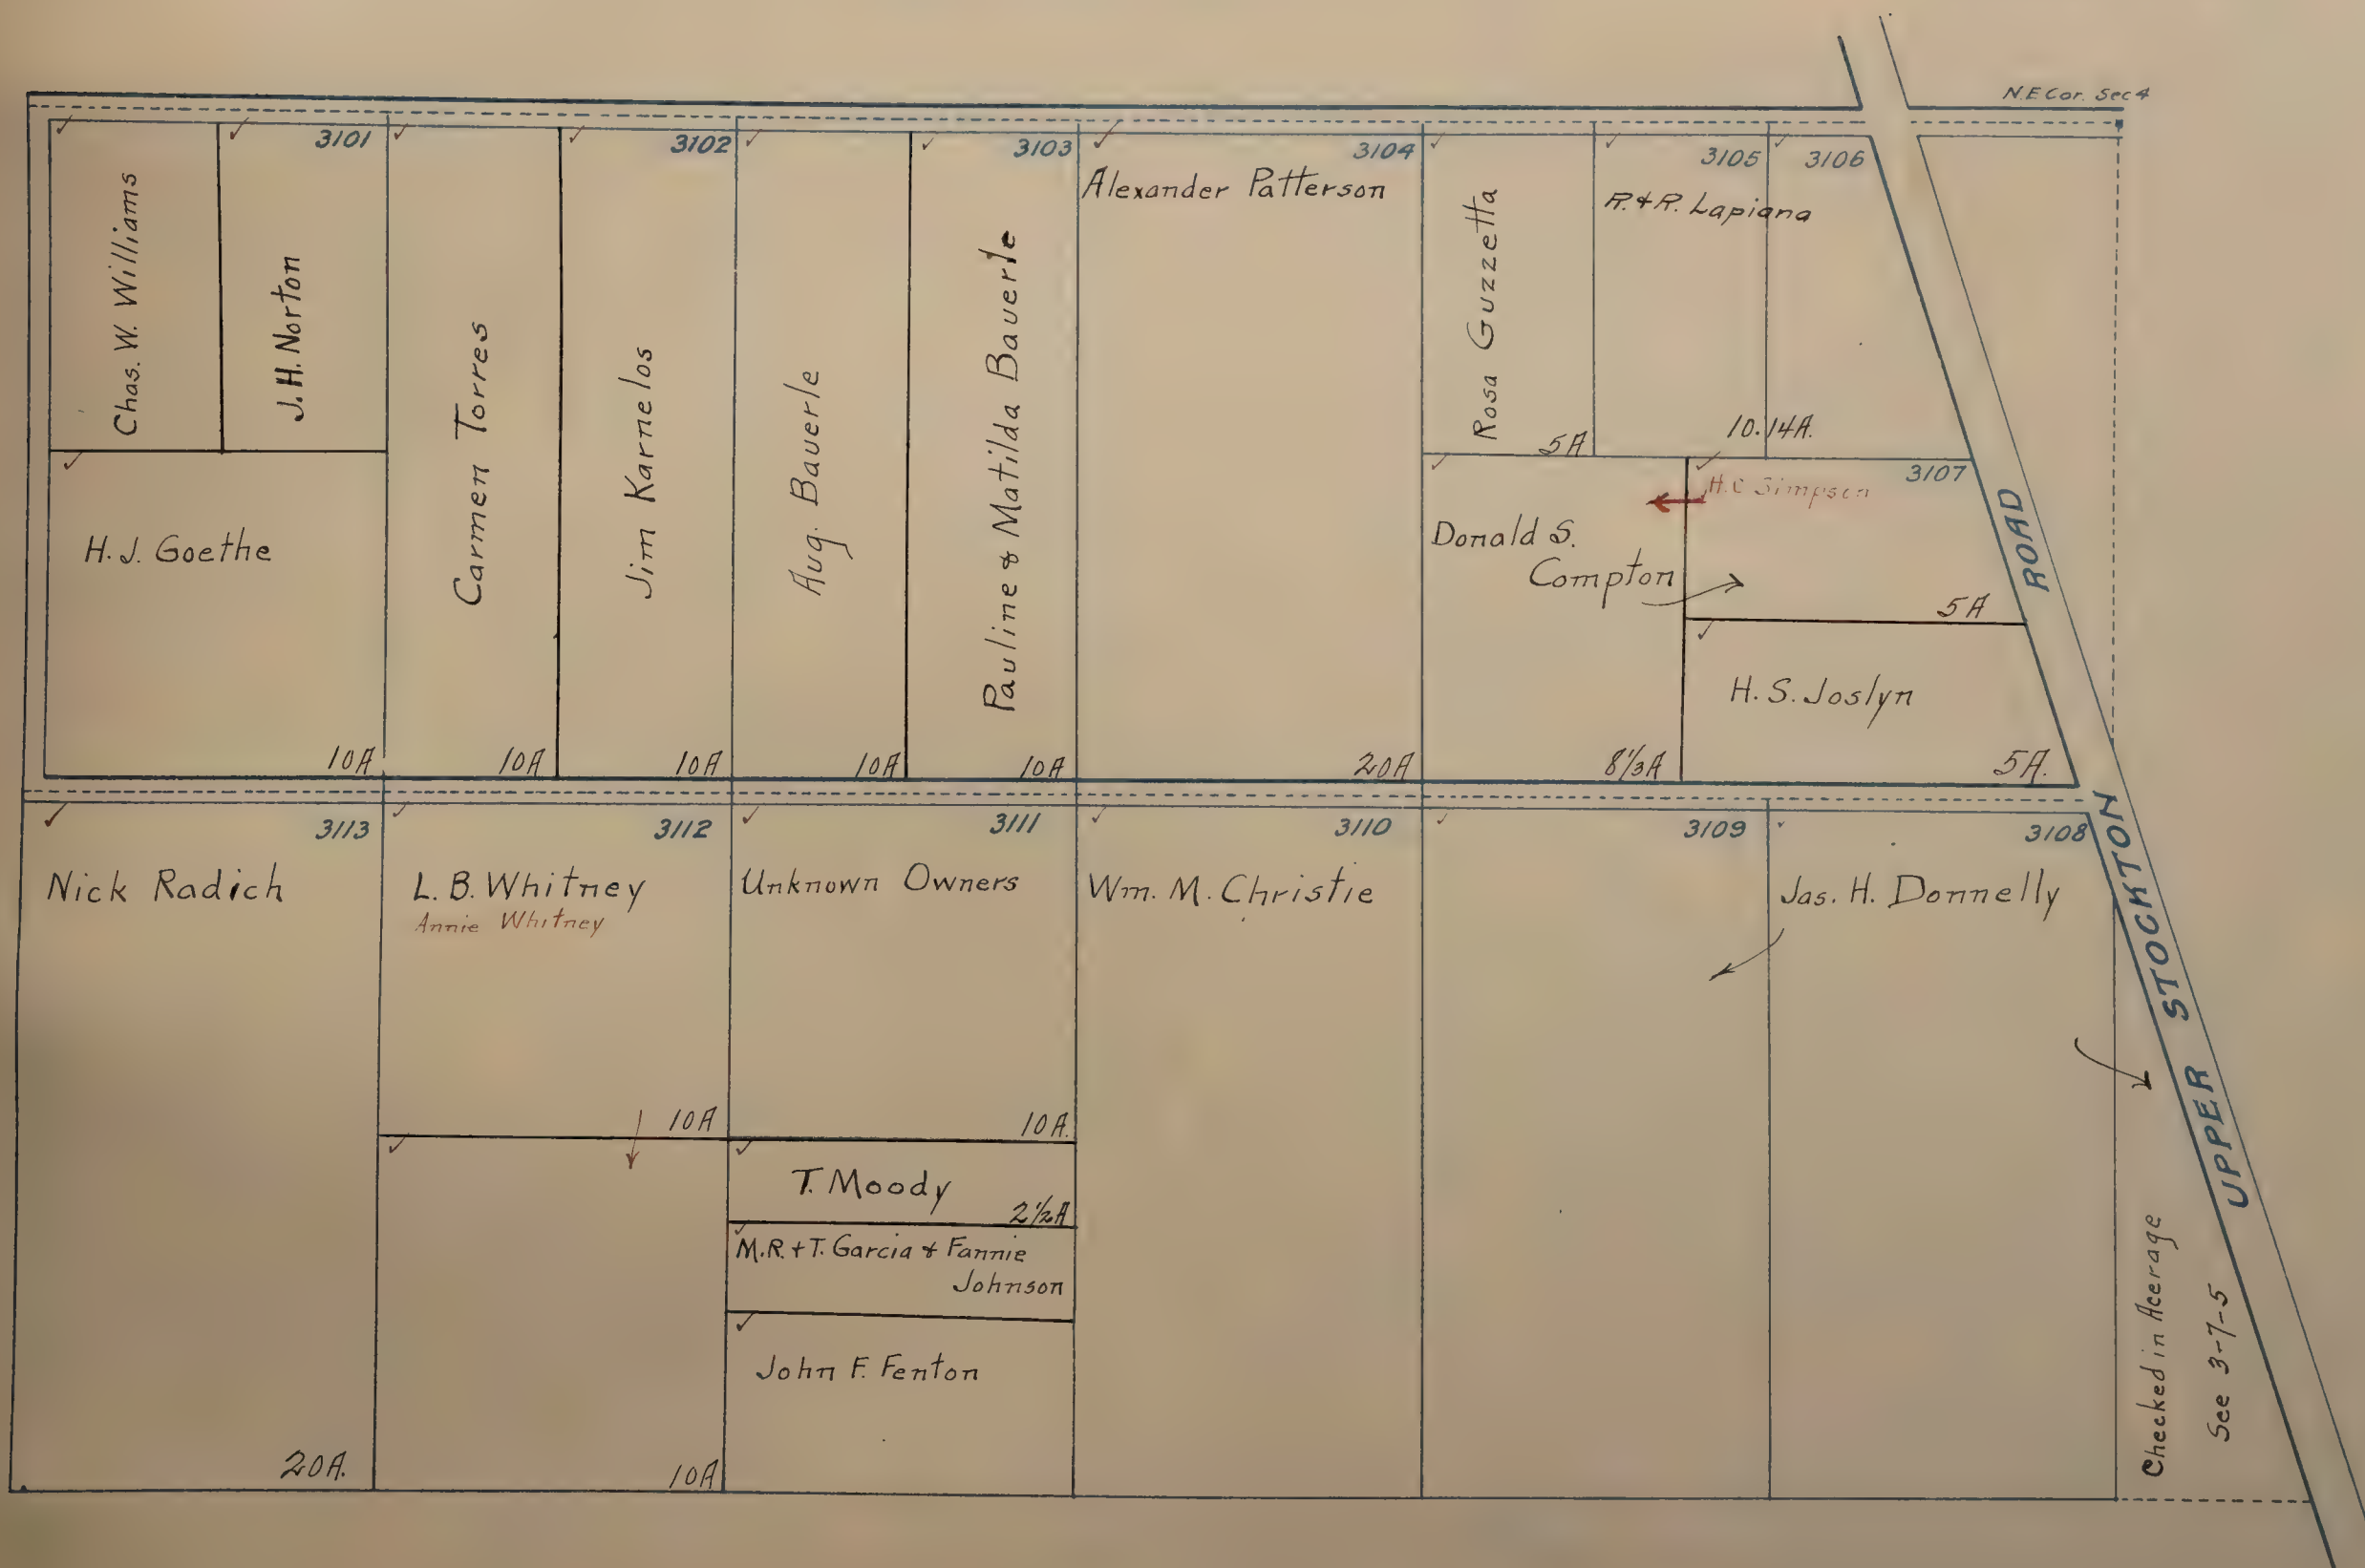


GOETHE COLONY ✓ Nº 32

N½ SEC. 6 T. 7 N. R. 6 E.

Scale 6 chains = 1 inch

Enterprise S.D.

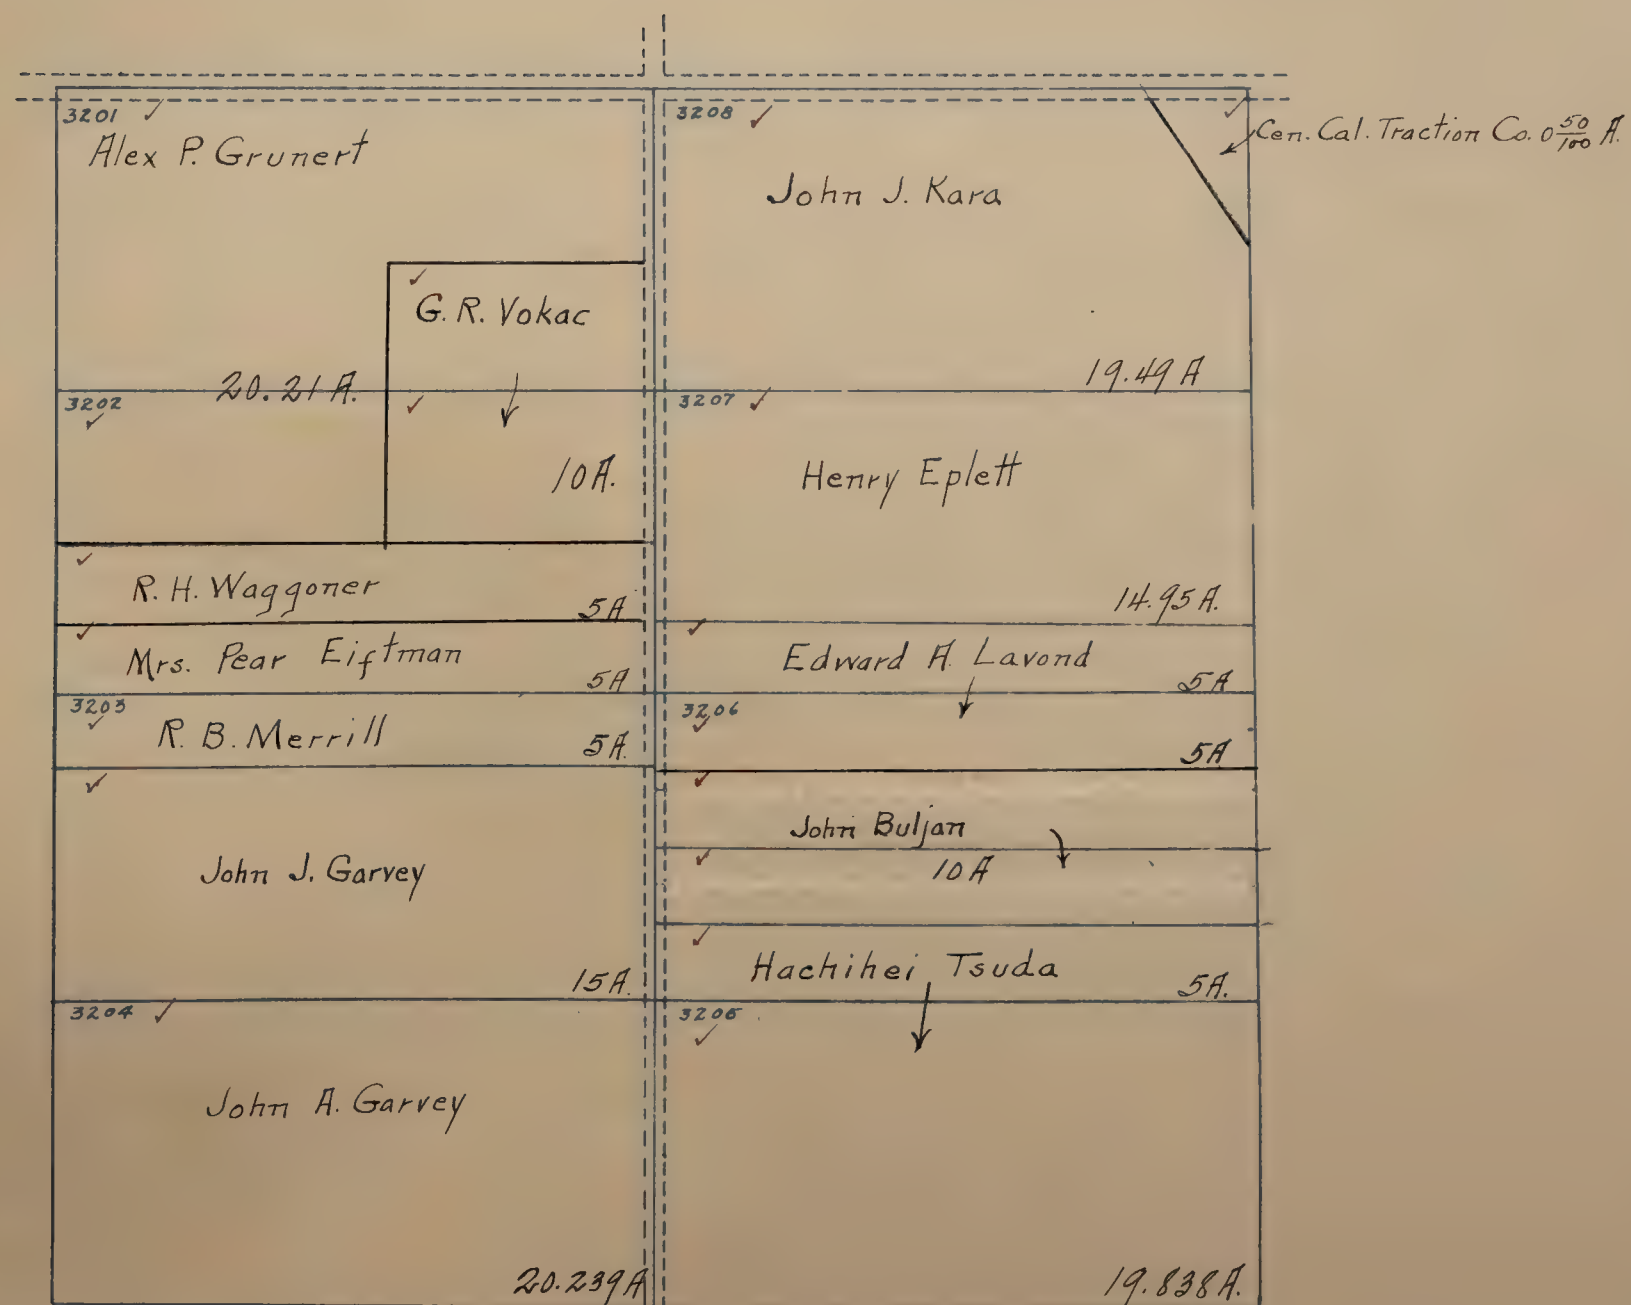

GOULD
OR
BROOKE REALTY CO. SUBD. N^o 112
LOCATED IN THE
N.E. 1/4 of Sec. 19, T8N R. 5E.
Scale: 75' = 1"

Pacific S.D.

Blanks to Geo. A. Richardson

AVENUE

A

1' O.B. Davis	5' Ethel A. Hunt	9' D.M. Young	13' Jas. Waddell	17' Mora P. Herbert	21' Geo. A. Herbert
2' P.S. Driver					
3' B.F. Driver					

ALLEY

1' Geo. H. Warner	5' E.P. McCurdy	9' Henry Bush	13' Ross & Silverstone
2'			
3'			
4'			
6'			
7'			
8'			
10'			
11'			
12'			

B

14'	18' Alex R. Baim	22' C.C. Folger
15'		
16'		
17'		
19'		
20'		
21'		
23'		

SAN FRANCISCO

1' Wm. H. Laine	5' John S. Tsironis	9' Frank S. Scoggins	13' Frank Brown	17' Geo. W. Herbert	21' Ethel Shogrock	25' Kittle Freund Est.	29' Jno. P. Deveraux
2' A.M. Schneider							
3' Frank J. Coyle							
4' D.M. Young							
6' Tony King							
7' Chan. D. Loney							
8' Jas. Waddell							

STREET

1' L.J. Anderson	5' Lillie J. Anderson	9' W.E. James	13' Annetta Boden	17' Theresa Bush	21' Jas. Tootel	25' C.T. Davis	29' J.E. Tofft	33' Frank S. Scoggins	37' Kondrat S. halag	41' Johana Kraut	45' J. & A. Sestanovich
2'											
3'											
4'											
6'											
7'											
8'											
10'											
11'											
12'											
14'											
15'											
16'											
18'											
19'											
20'											
22'											
24'											

AVENUE

STREET

STOCKTON

F

15' Jas. O'Beirne	19' Ed. E. Koshell	23' Edward Carlsson	27' Alfred Kramm	31' John Webb	35' Mary D. Watkins	39' I.K. Emerson
16'						
17' Eliz. Cole						
18'						

ALLEY

23' Mary L. Maynan	27' Edw. H. Sprague	31' Wm. Gornovsky	35' E.P. McCurdy	39' Rosie V. Rashkie	43' Helena Narbutt	47' Edith P. McCurdy	51' L.Y. Coggins	55' Hoffman & Meredith	59' Hoffman & Birch	63' John & Mary Markof	67' Kate Petterson
24'											
25'											
26'											
28'											
29'											
30'											
32'											
33'											
34'											
36'											
37'											
38'											
40'											
41'											
42'											
44'											
45'											

G

LOS ANGELES

AVENUE

PINE

LOWER

1' I.J. Johnson	5' Wm. J. Gornovsky	9' Charles Barnett	13' Charlotte Jones
2' W.J. Braun			
3'			
4'			

WILLOW

1' Mylo W. Hurto	5' Anna M. Warner	9' W.J. Feeney	13' Mike Khegovich	17' E. Nuding	21' Kosma Simon	25' Laura E. Lovett	29' Spangler & Green
2'							
3'							
4'							
6'							
7'							
8'							
10'							
11'							
12'							
14'							
15'							
16'							
18'							
19'							
20'							
22'							
23'							
24'							

K

12' Clara F. Bodefield	16' Jos. R. & Evelyn M. Hamilton	20' G.C. Simmonds
13' Helen M. Coyne		
14' F. Karasek		
15'		

ALLEY

25' Ida E. Smith	29' W.J. Richards	33' A.E. Frost	37' C. Bierwagen	41' J.L. Finchpaugh	45' C.L. Argues	49' Kath. Maxwell	53' L.W. & A.D. Holmes	57' L.W. Holmes
26'								
27'								
28'								
30'								
31'								
32'								
34'								
35'								
36'								
38'								
39'								


AVENUE

OAKLAND

GOULD
OR
BROOKE REALTY CO. SUBD. N^o 112 ✓
LOCATED IN THE
N.E. ¼ of Sec. 19, T.8N., R.5E.
Scale: 75' = 1"

Pacific S.D.

Blanks to Geo. A. Richardson

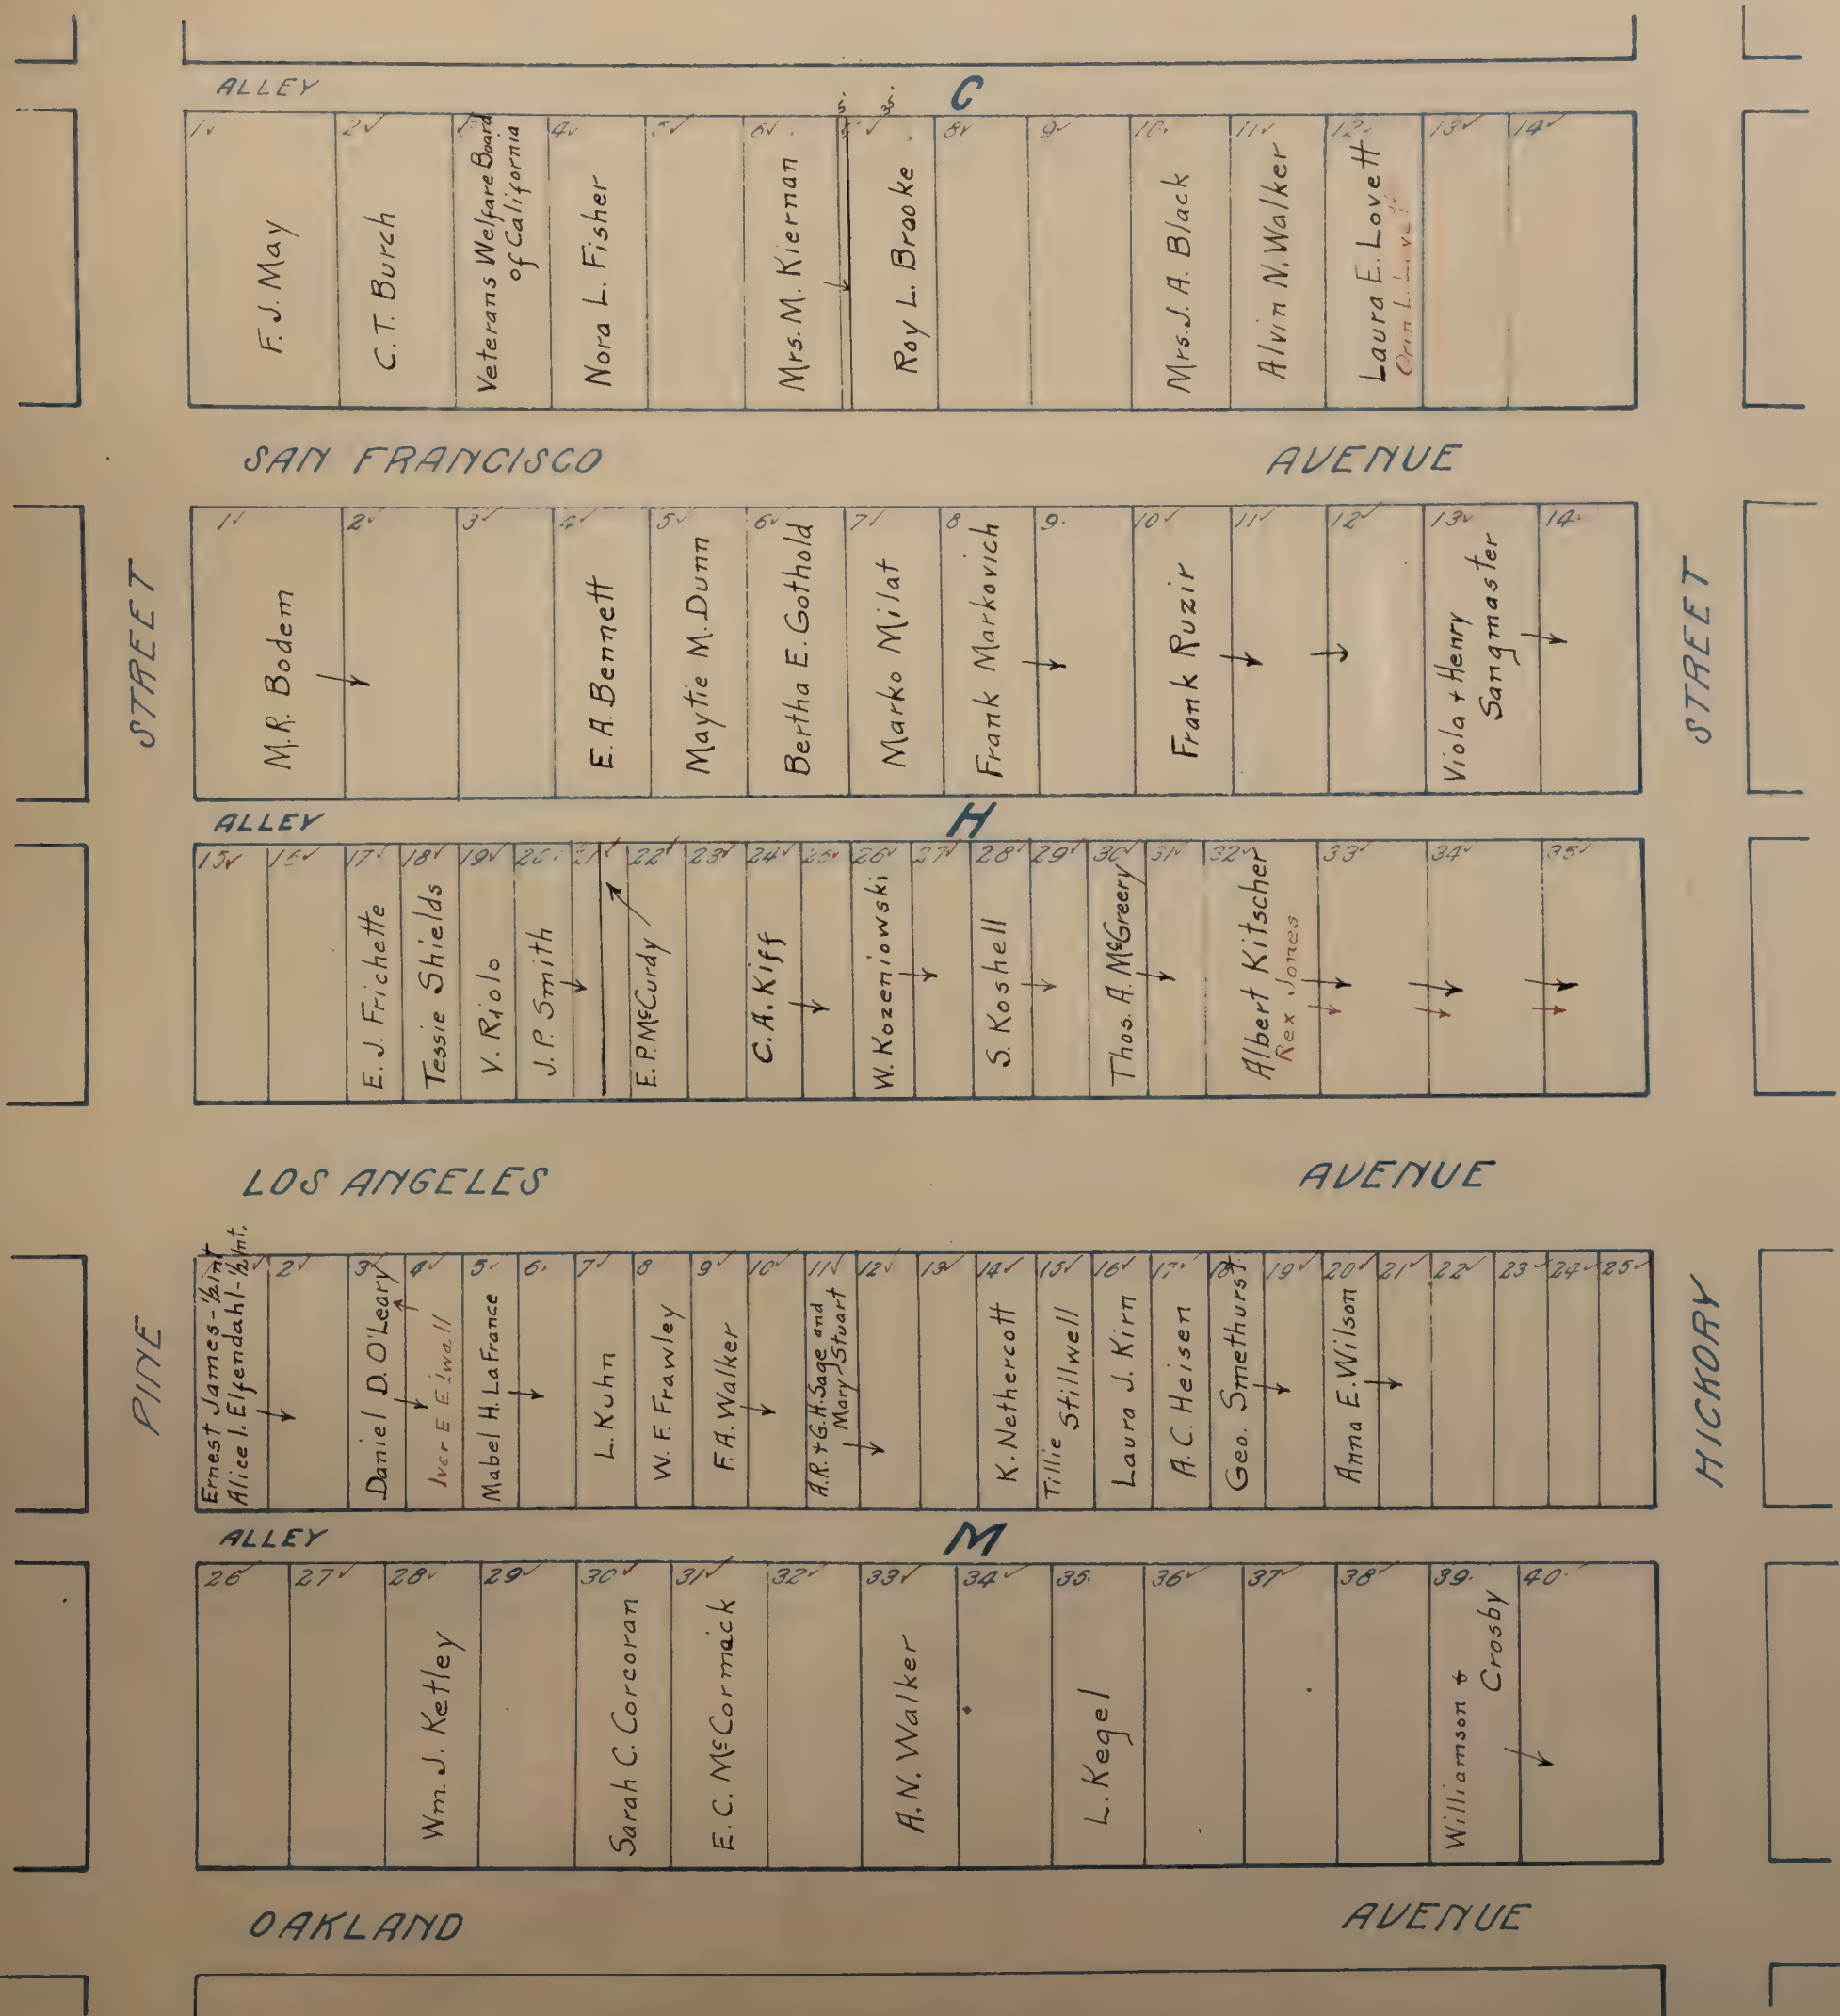

GOULD
OR
BROOKE REALTY CO. SUBD. N^o 112
LOCATED IN THE
N.E. 1/4 of Sec. 19, T.8N., R.5E.
Scale: 75' = 1"

Blanks to Geo. A Richardson

Pacific S.D.

STREET

D

1	2	3	4	5	6	7	8	9	10	11	12	13	14	15
Togomi + Arae				Isabelle Stickney	Laura E. Lovett Clara L. Lovett	Clarence E. Barker		C. Vost	Tibuasio Ochoa	Nora Jackson	Cath. P. Walker			

SAN FRANCISCO

AVENUE

1	2	3	4	5	6	7	8	9	10	11	12	13	14	15
State of Calif.			A. Ostajia		A.C. Heisen	C. Vost	J. Jurjevich		H.B. Taylor					

STREET

E

1	2	3	4	5	6
Paul Bernardis	Margt. Lubetich	Minnie Lubetich	Tony Ruscich		

AVENUE

1	2	3	4	5	6
			G.N. + C.H. Radonich + Laura M. Schacht		

HICKORY

I

16	17	18	19	20	21	22	23	24	25	26	27	28	29	30	31	32	33	34	35	36	37	38	39
Peter Masloff				B.G. Ledwell				W.E. Peck		Hedley Northey		H.A. Christofferson	Frank Kelly	Howard G. Earlem		Gottlob Kurtz		G.C. Simmonds		Harry Schauffles			

LOS ANGELES

AVENUE

1	2	3	4	5	6	7	8	9	10	11	12	13	14	15	16	17	18	19	20	21	22	23	24
Mrs. A.A. Restano			Lawrence W. Bayer			Belle Frederick				Robt. L. Jones		J.F. Silva		Minnie F. Storch	Chas. Halstead	Sybil Pollen	Eliz. J. + Nellie Phillips		Lillian Nicolaus				

CHESTNUT

J

1	2	3	4	5	6	7
	Edna Niles		J. F. Noce			
			E.P.M. Curdy			
						Anna May
						Cecelia Henning

SACRAMENTO

1	2	3	4	5	6	7
			Mrs. M.H. Ballagh			
			Mrs. M.A. Ballagh			

HICKORY

N

25	26	27	28	29	30	31	32	33	34	35	36	37	38	39
A. Leoni		Ethel May Ellis E.P.M. Curdy				Wm. W. McClintock			Helen + Mrs. Sol Nathan		Kittie Freund Est. Ethel Shorrock		H. Poffenberger	

OAKLAND

AVENUE


O

16	15	14	13	12	11

GOULD
 OR
 BROOKE REALTY CO. SUBD. N^o 112
 LOCATED IN THE
 N.E. 1/4 of Sec. 19, T. 8 N., R. 5 E.
 Scale: 75' = 1"

Pacific S.D.


Blanks to Geo. A. Richardson

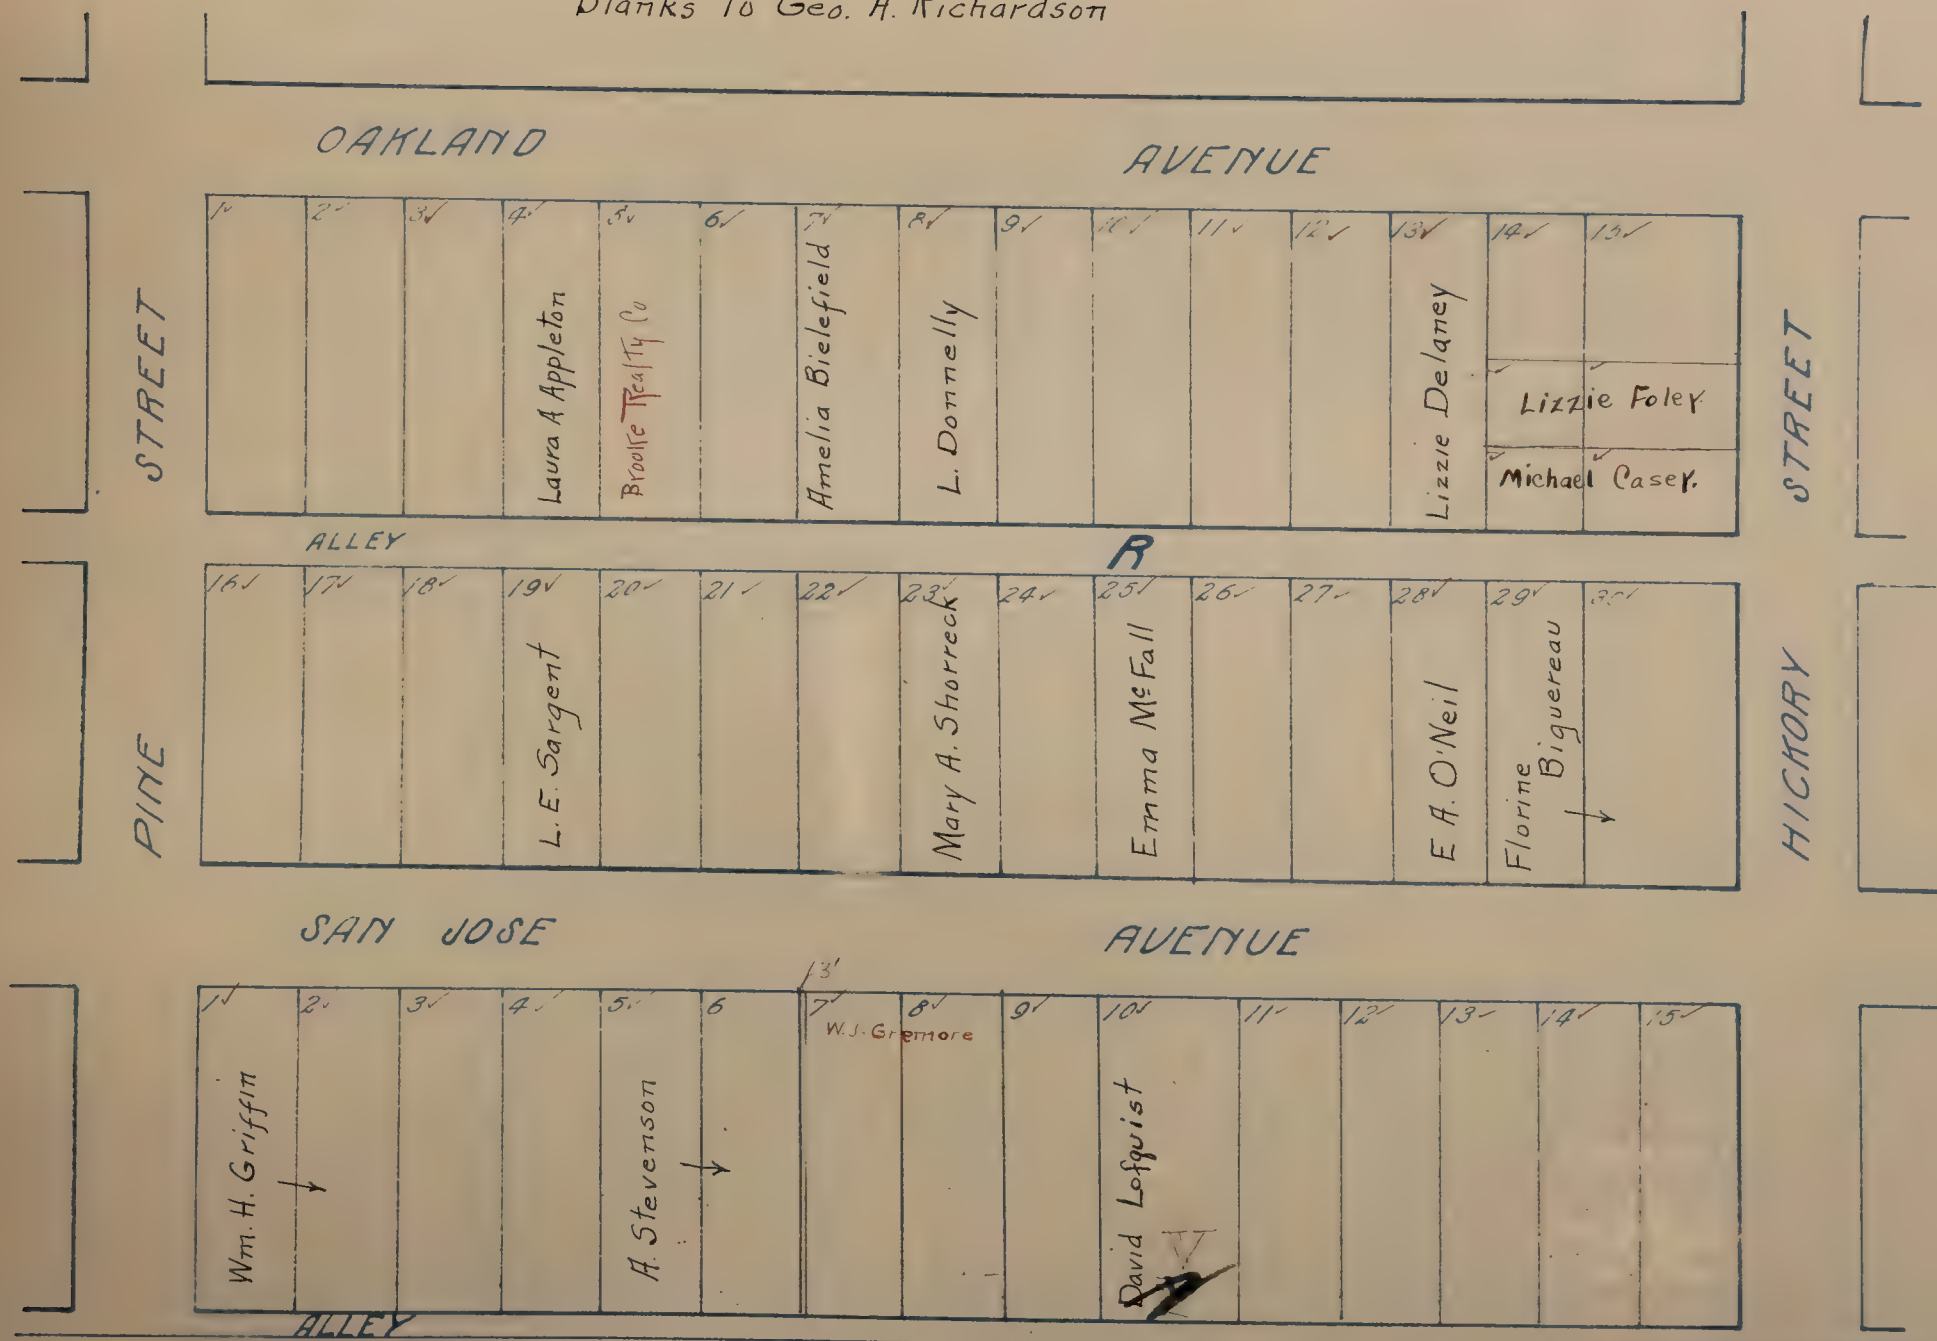

AMENDED MAP
of
GOULD
or
BROOKE REALTY CO. SUBD. N° 115
LOCATED IN THE
N.E. ¼ of Sec. 19, T.8N., R.5E
Scale: 100'-1"

Pacific S.D.

Blanks to Geo. A Richardson

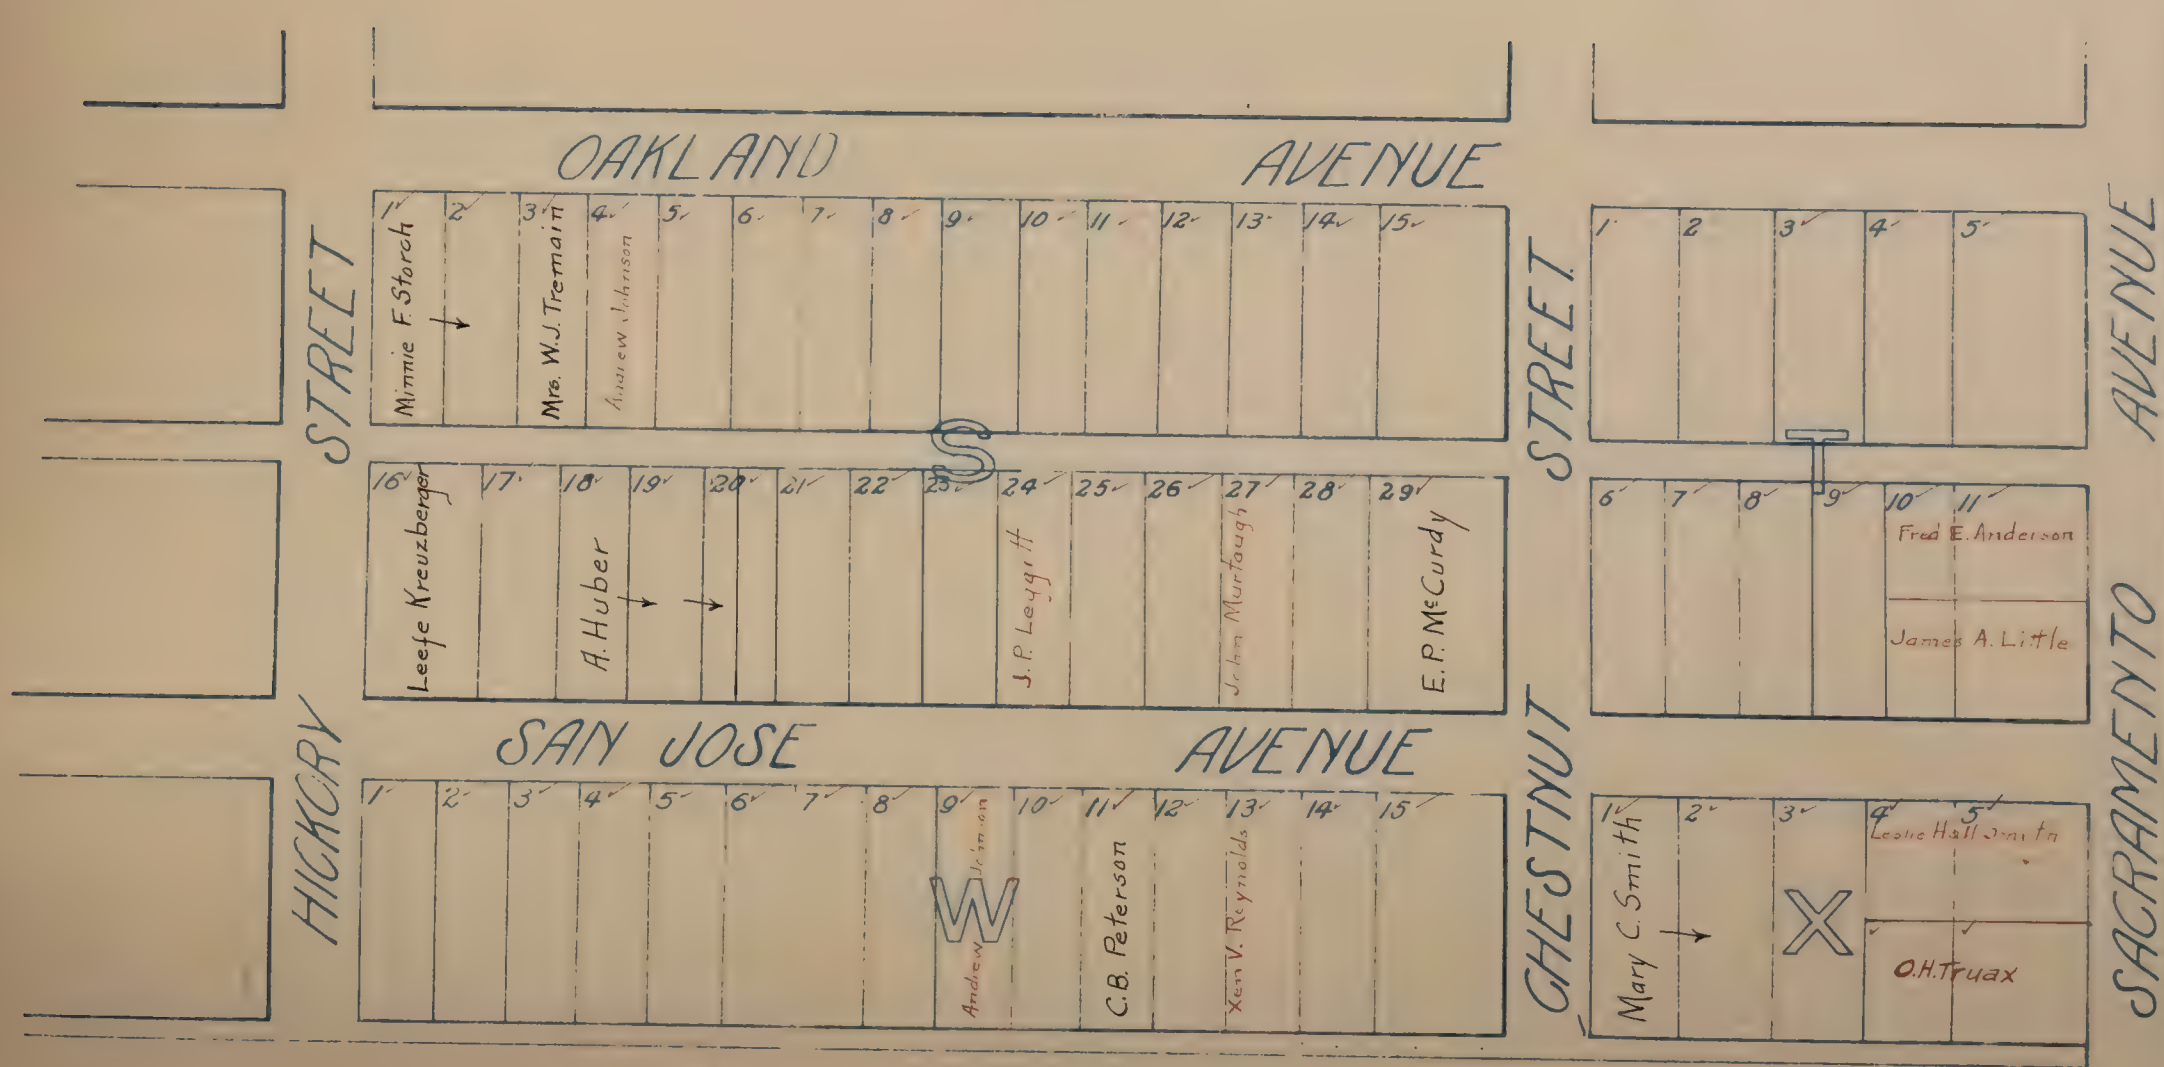

GOWER & WILES SUBD No. 4 ✓

located in


T5N. R6&7E MD3&M

Scale: 1" = 8 Chains

Herald, S.D.

Arno - S.D.

Blanks to Geo. W. Lewis

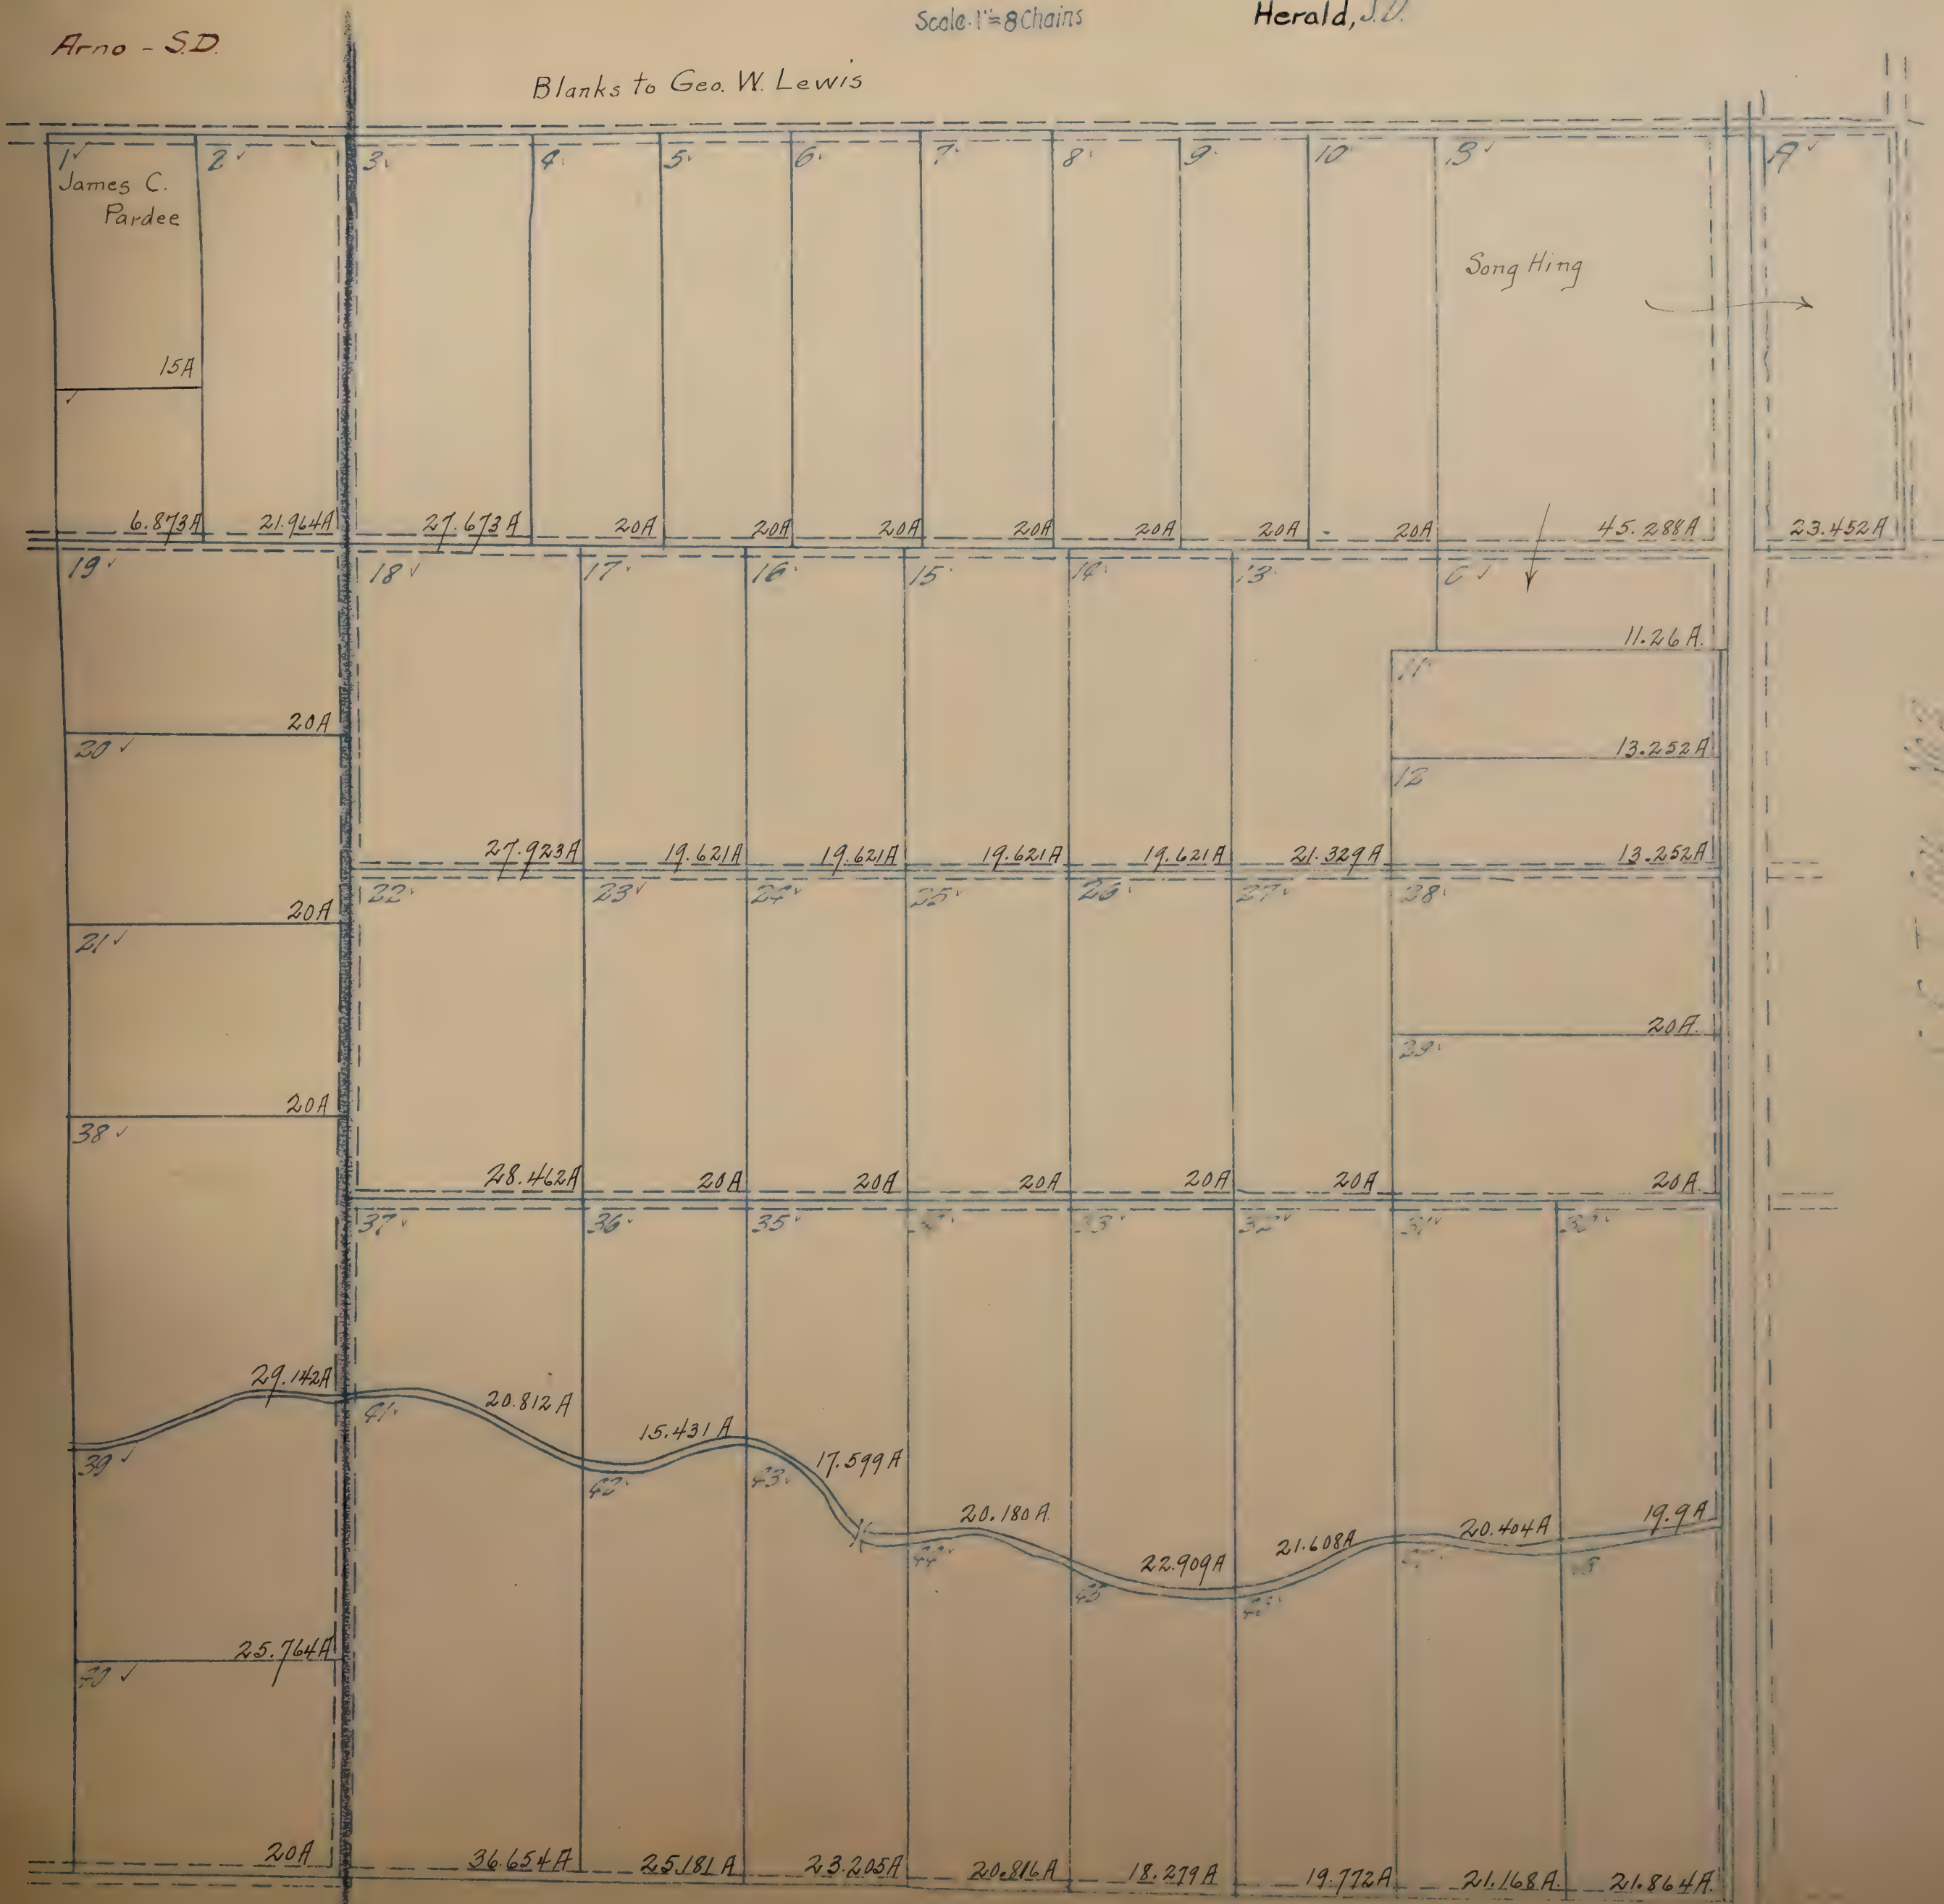

GRANLEES TRACT ✓

located in
N.E. 1/4 Sec. 20 T. 8 N. R. 5 E
Scale 1 in = 50 ft.

Fruit Ridge, S.D.

ROOSEVELT				STREET				
4 ^v	3 ^v	2 ^v	1 ^v	STREET	20 ^v	19 ^v	18 ^v	17 ^v
Oscar H. Braugher →					Mary C. Granlees	L. Darling ↓	J. M. O'Keefe Michael O'Keefe	
5 ^v W. E. Trainor					16 ^v Guilio Lera			
6 ^v Mary J. & Andrew M. McCollum					15 ^v A. W. Rudloff			
7 ^v Theresa Gants					14 ^v North Sacramento Land Co.			
8 ^v ↓					13 ^v John R. Johnson			
9 ^v Aguilla Johnson					12 ^v Theodore Erickson E. Hill			
10 ^v ↓ Albert Brooks					11 ^v ↓			

GREENWOOD ✓

Sections 13 & 14 Range 1 Del

1000' x 1000'

All Lots 10 Acres unless otherwise noted.



Arcade
Arden

HAGGIN PARK ✓

located in
secs 47 & 52 Rancho Del Paso
Scale 1" = 400'

Blanks to Sacramento Suburban Fruit Lands Co.

Carmichael, D.

Fruitvale, S.D.



MAP OF SUBDIVISION OF GEORGE HANLON No 1 TRACT

LOCATED IN
RANCHO RIO DE LOS AMERICANOS
SACRAMENTO COUNTY, CALIFORNIA

Blanks To Johann Becker.




MATHER FIELD

NATOMAS CO. OF CALIFORNIA SUBDIVISION No 2

Florin, S.D.

Blanks to Cornelius, Catherine & Matilda Harkins

Blank - Blank and Water

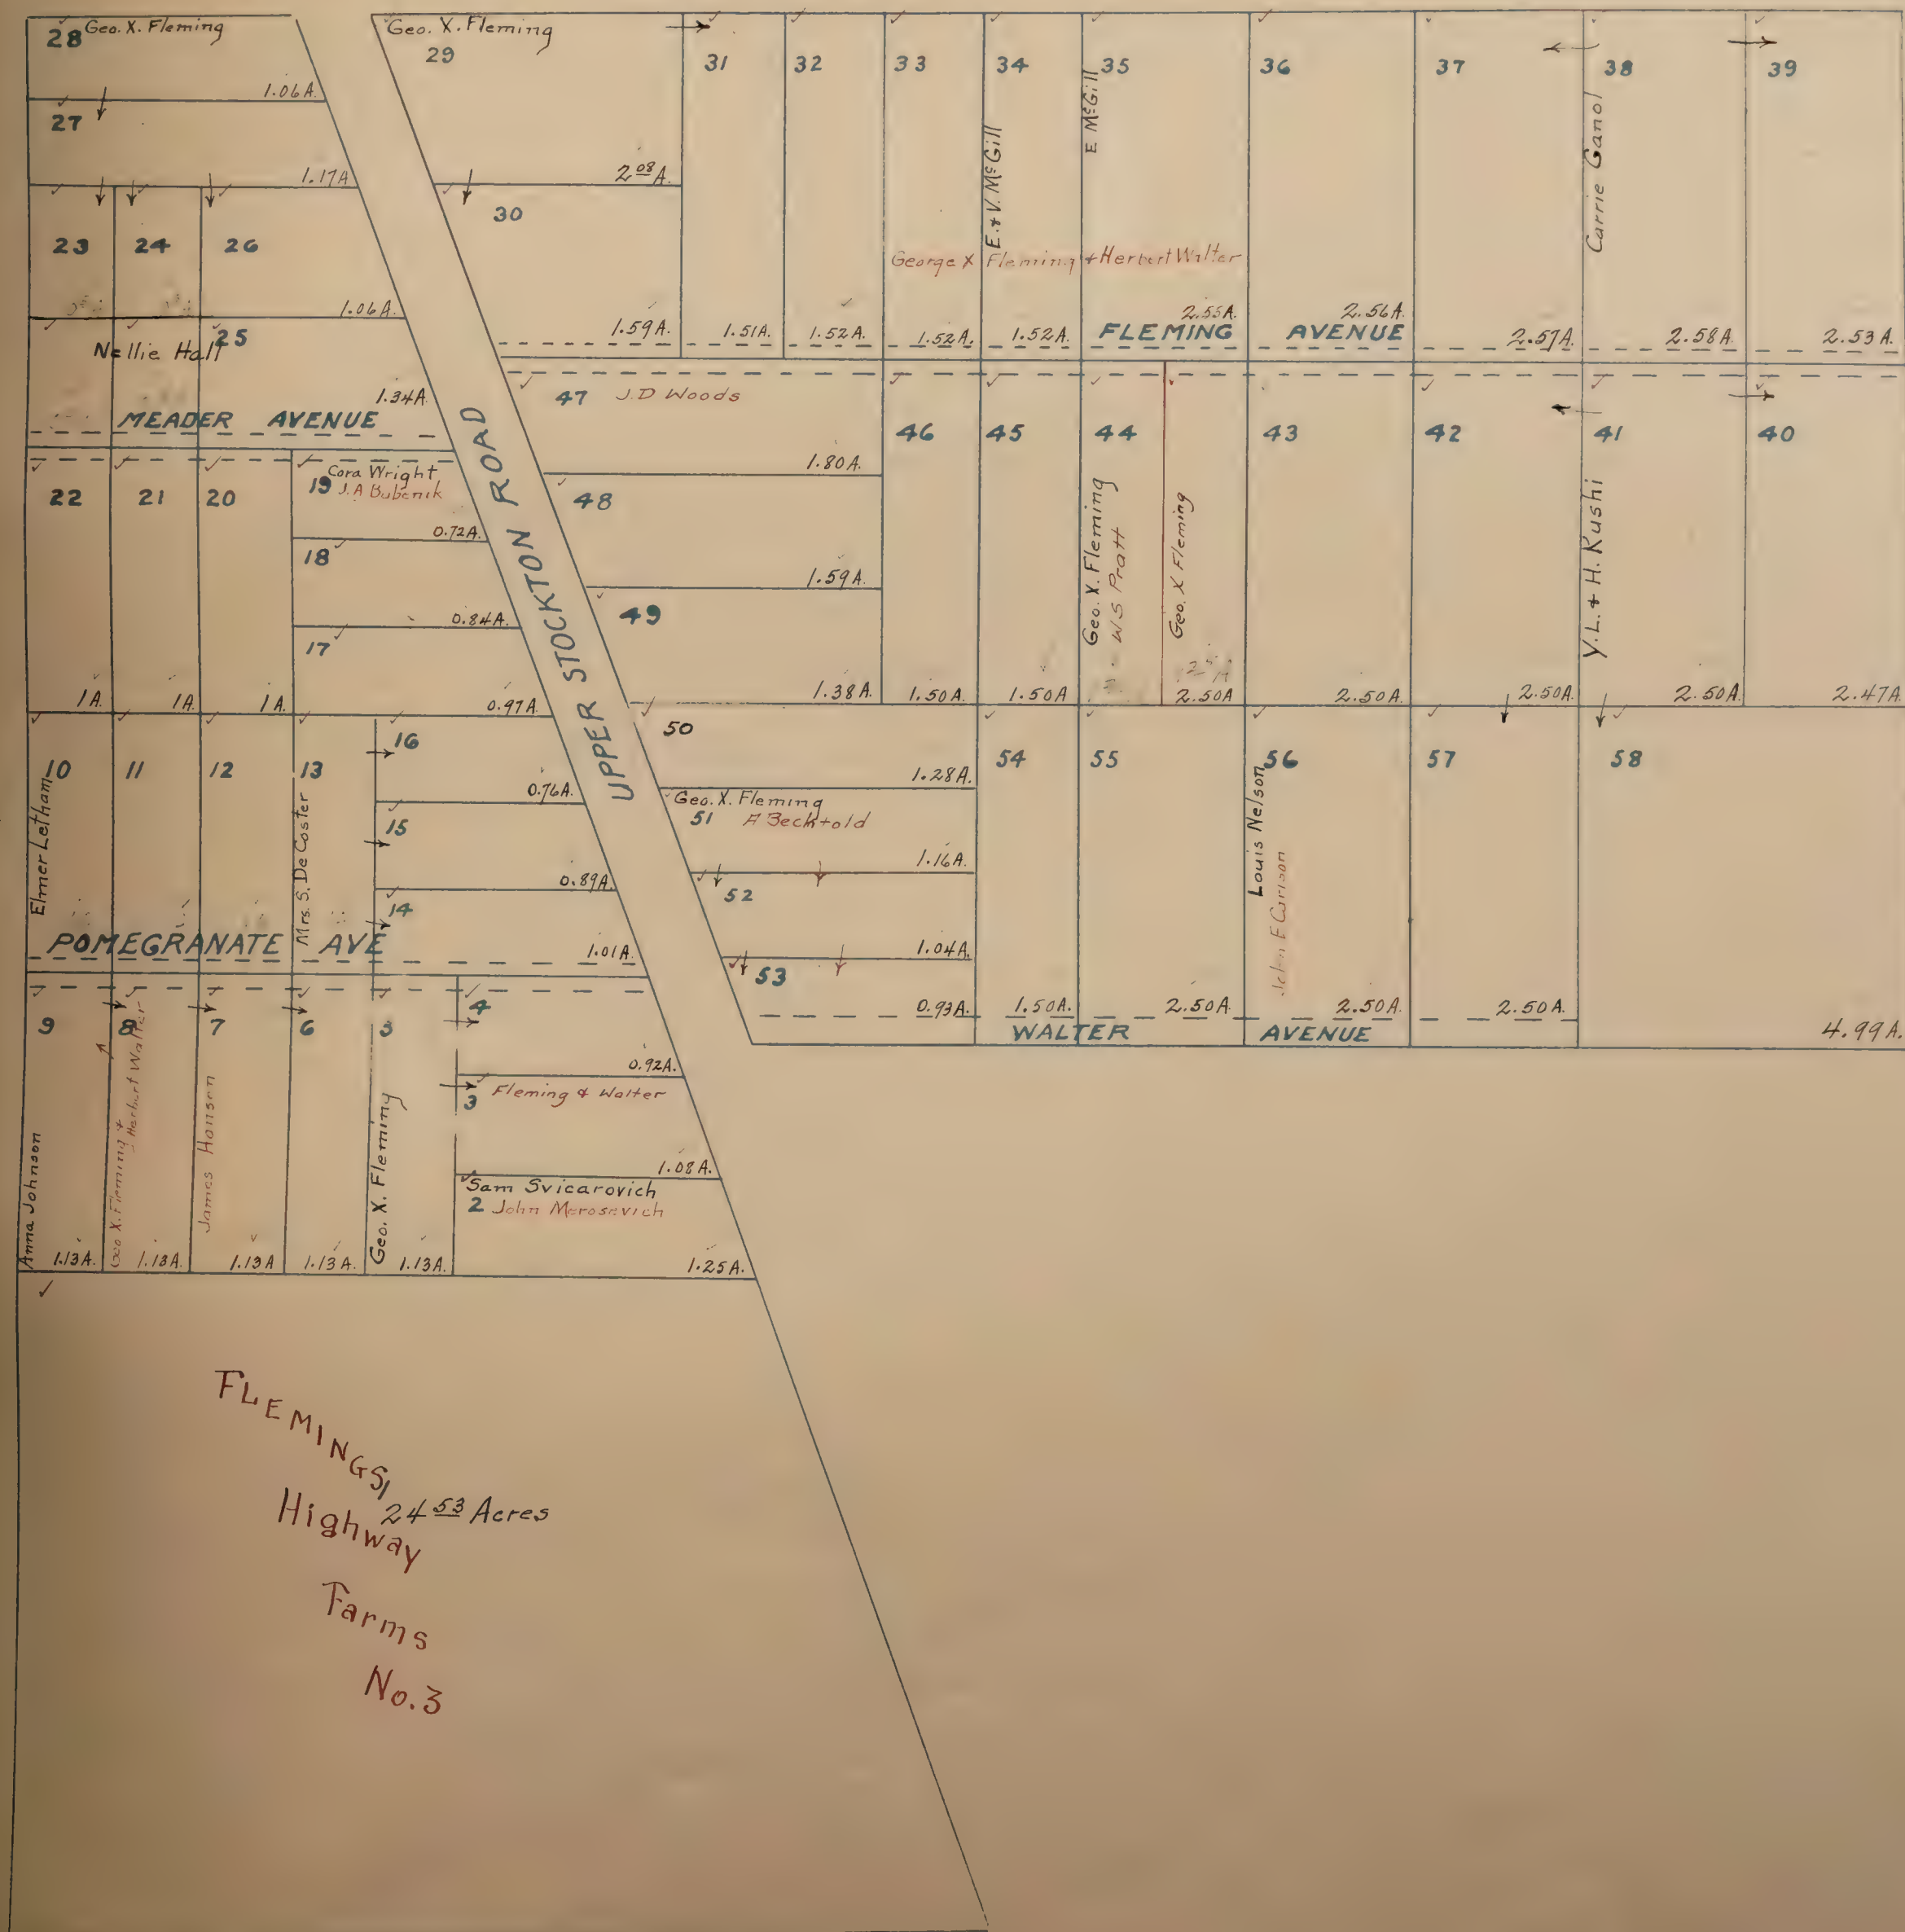


HERALD ✓
LOCATED IN
Sections 7 & 8, T.5N. R.7E.
Scale: 100 ft = 1 inch.

Herald S.D.


Blanks To Herald Realty Co.

Herald

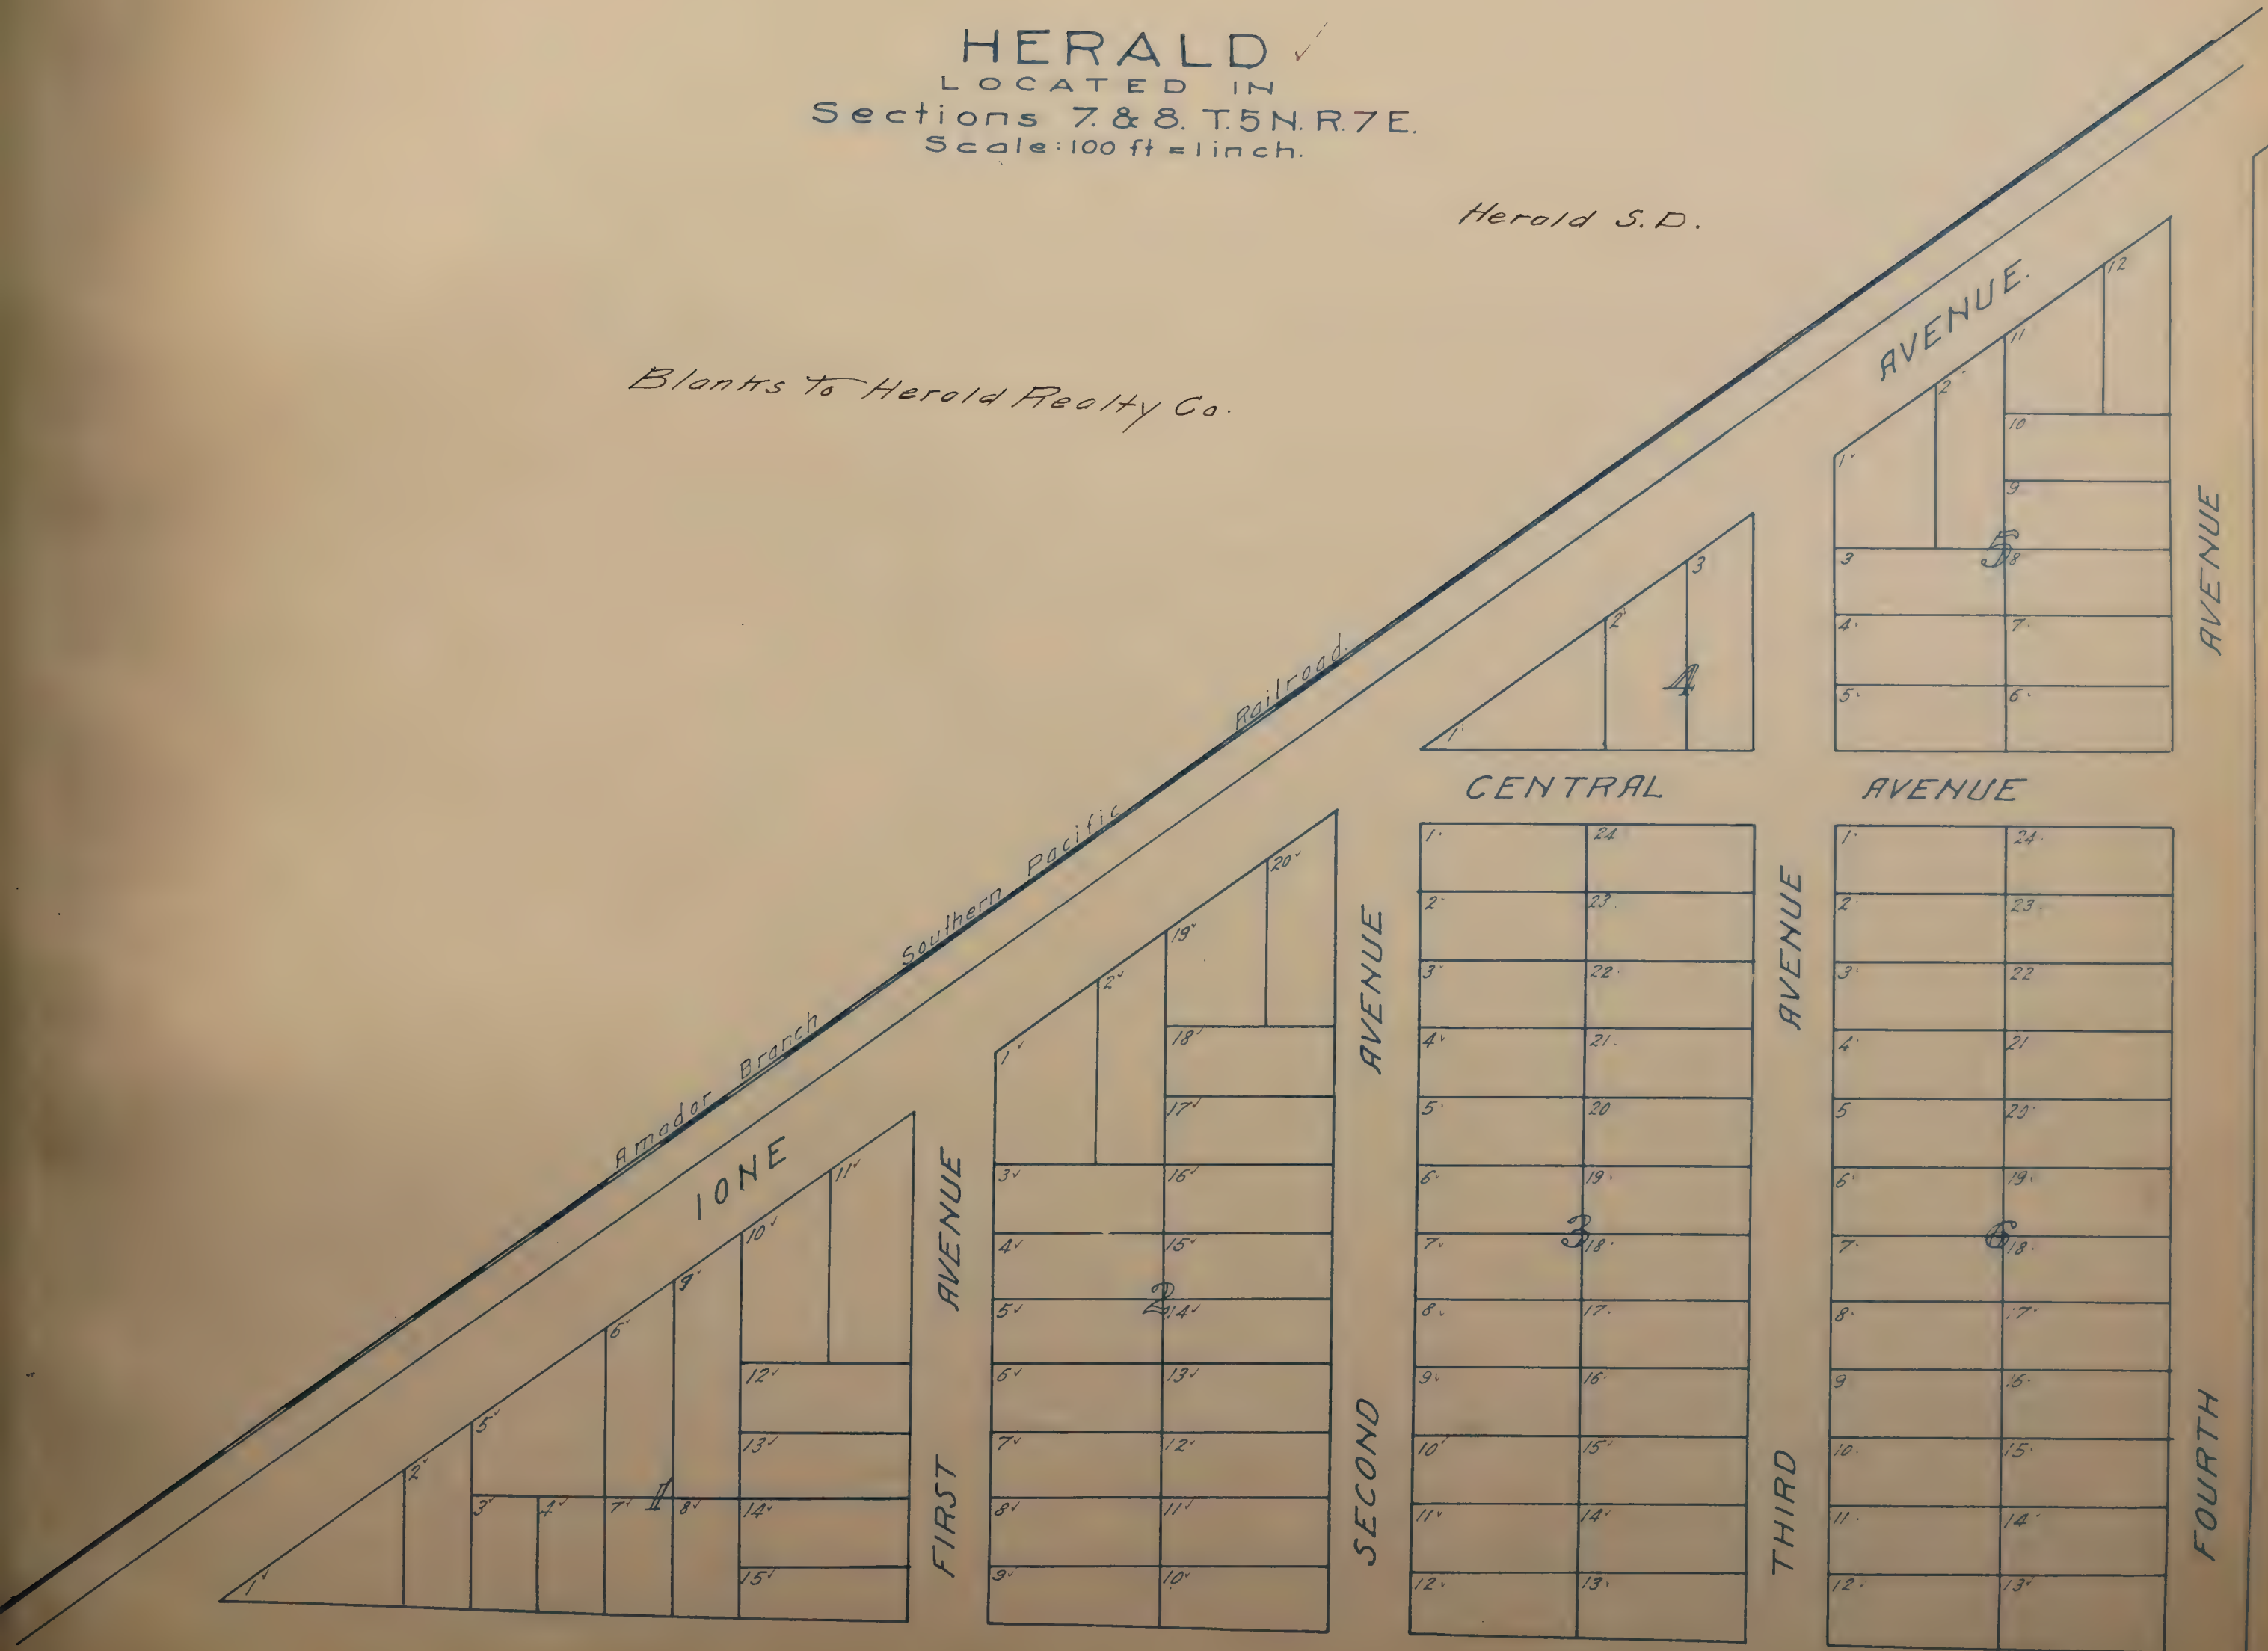


LOCATED IN
Sections 7 & 8. T.5 N. R.7 E. *Herold, S. D.*
Scale: 100 ft. = 1 inch.

Cont'd B/K. 15

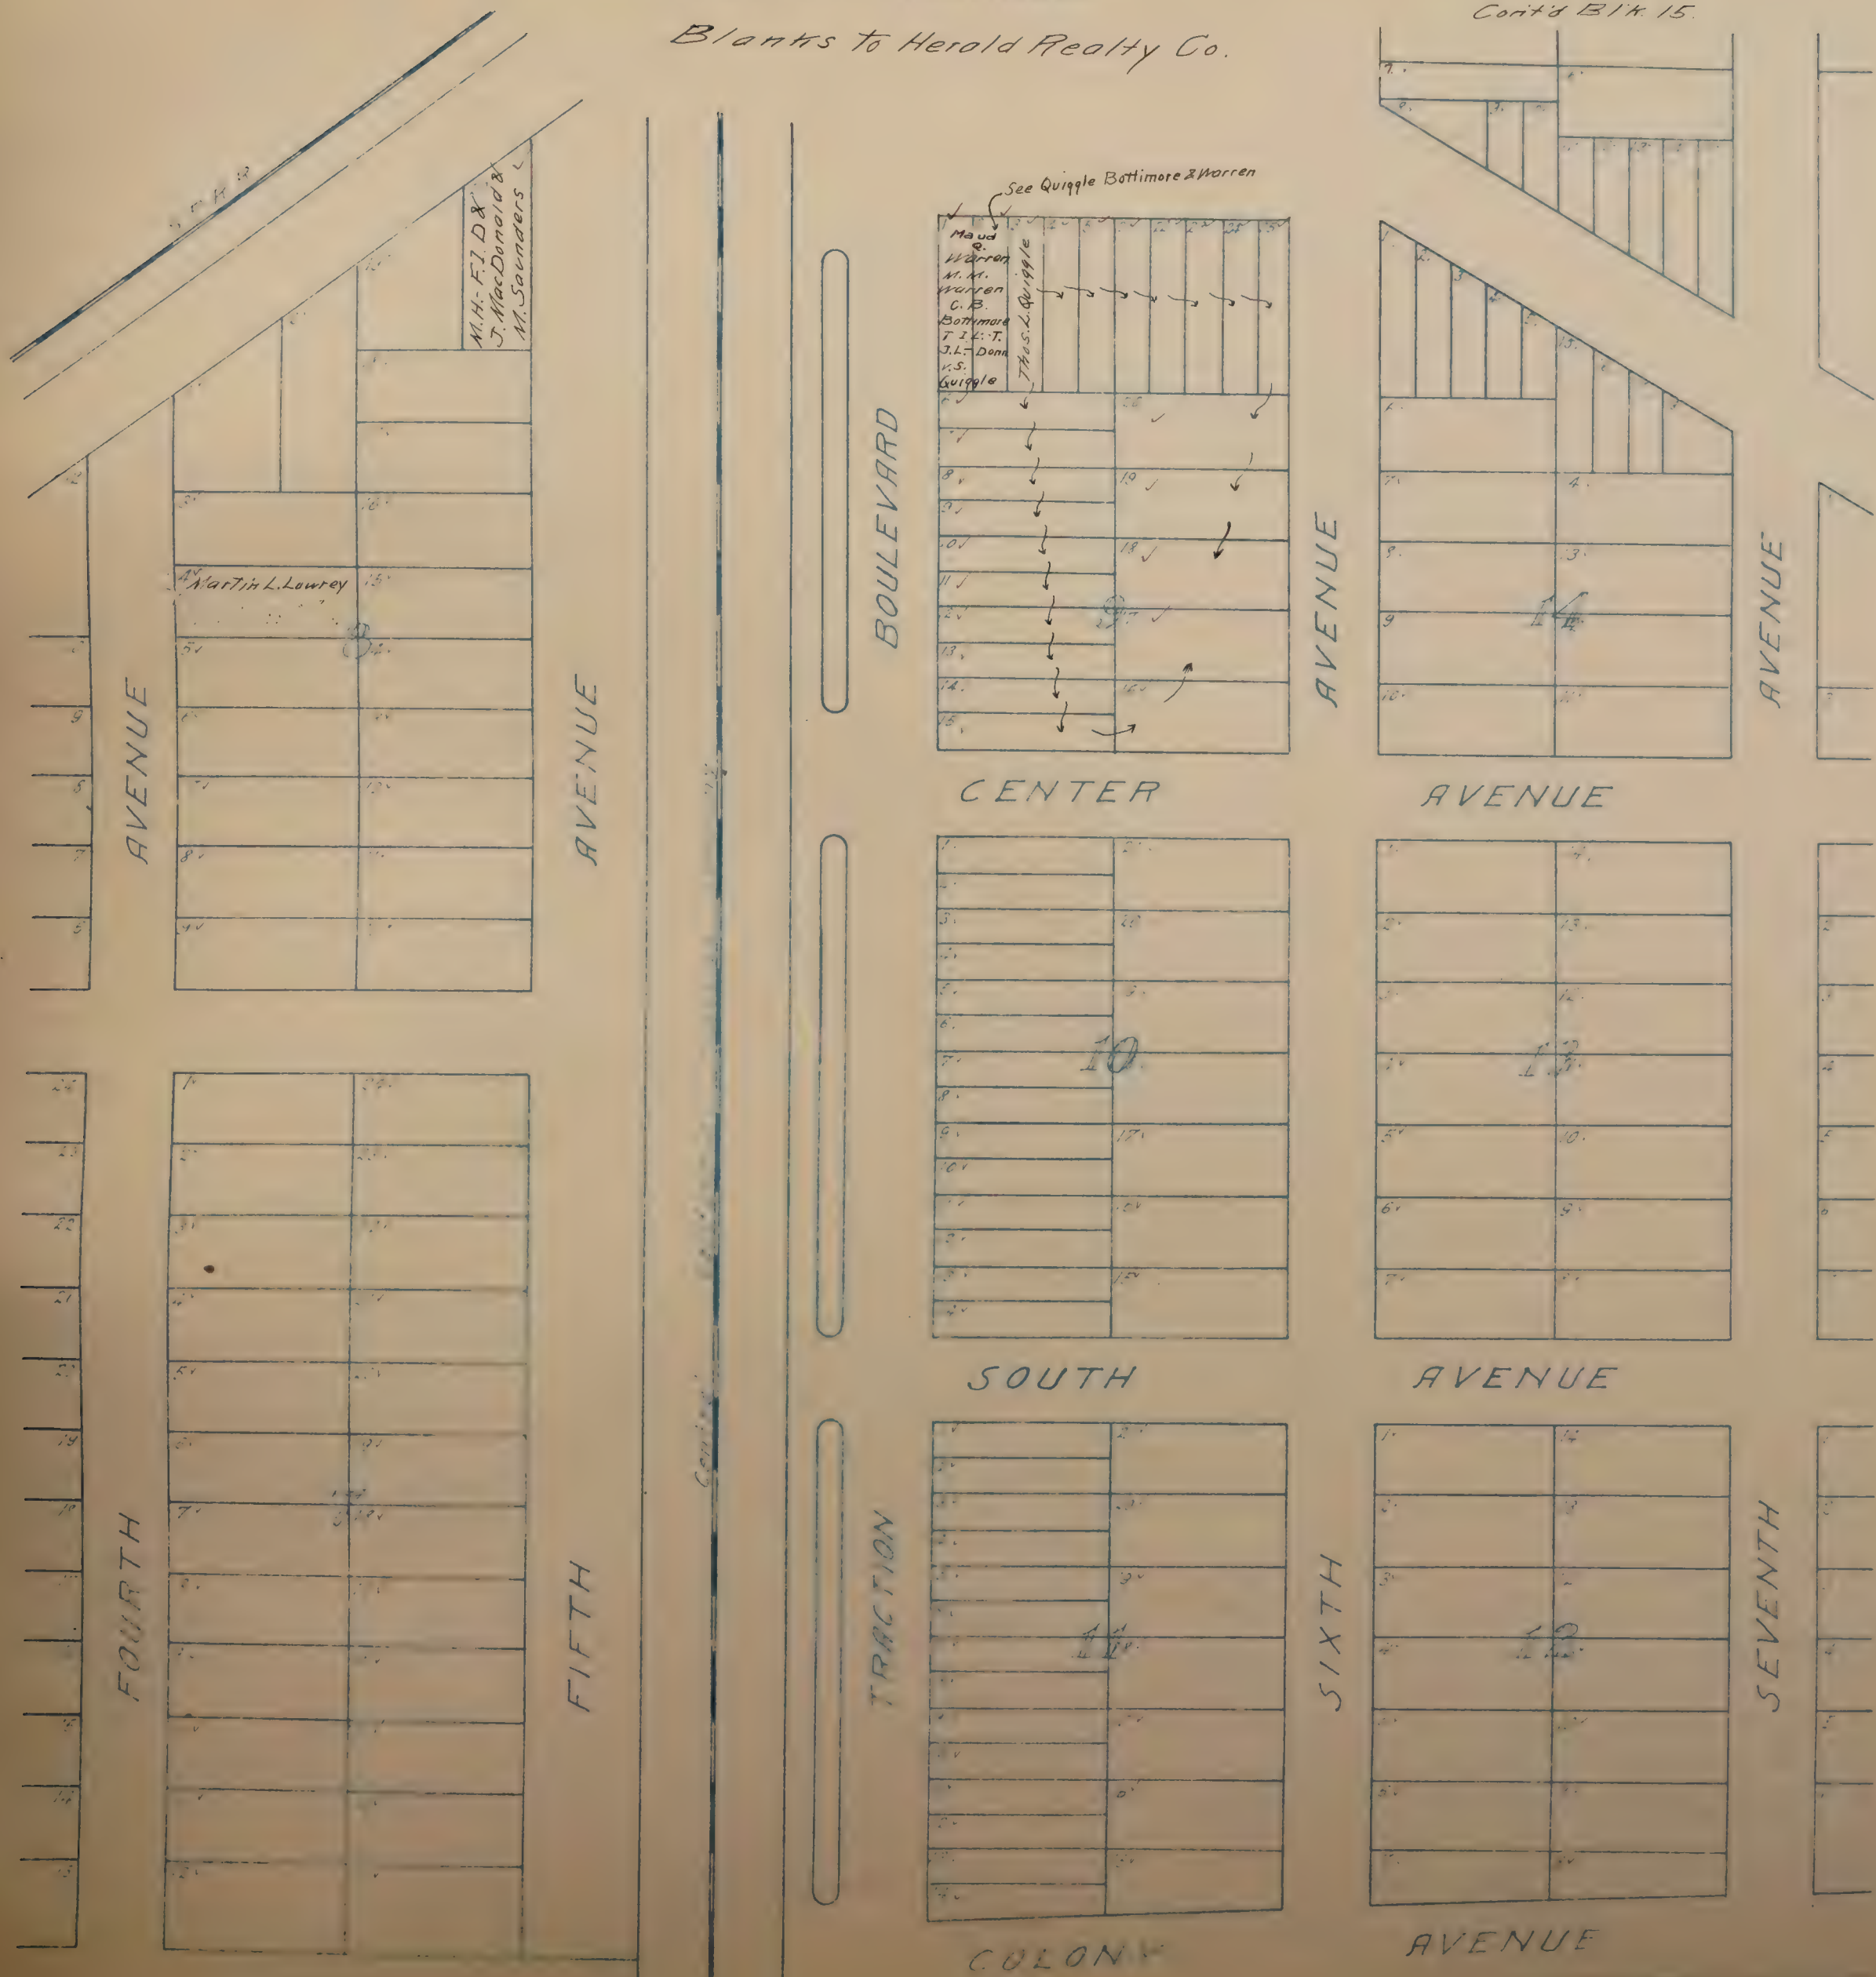

Herald S. D.

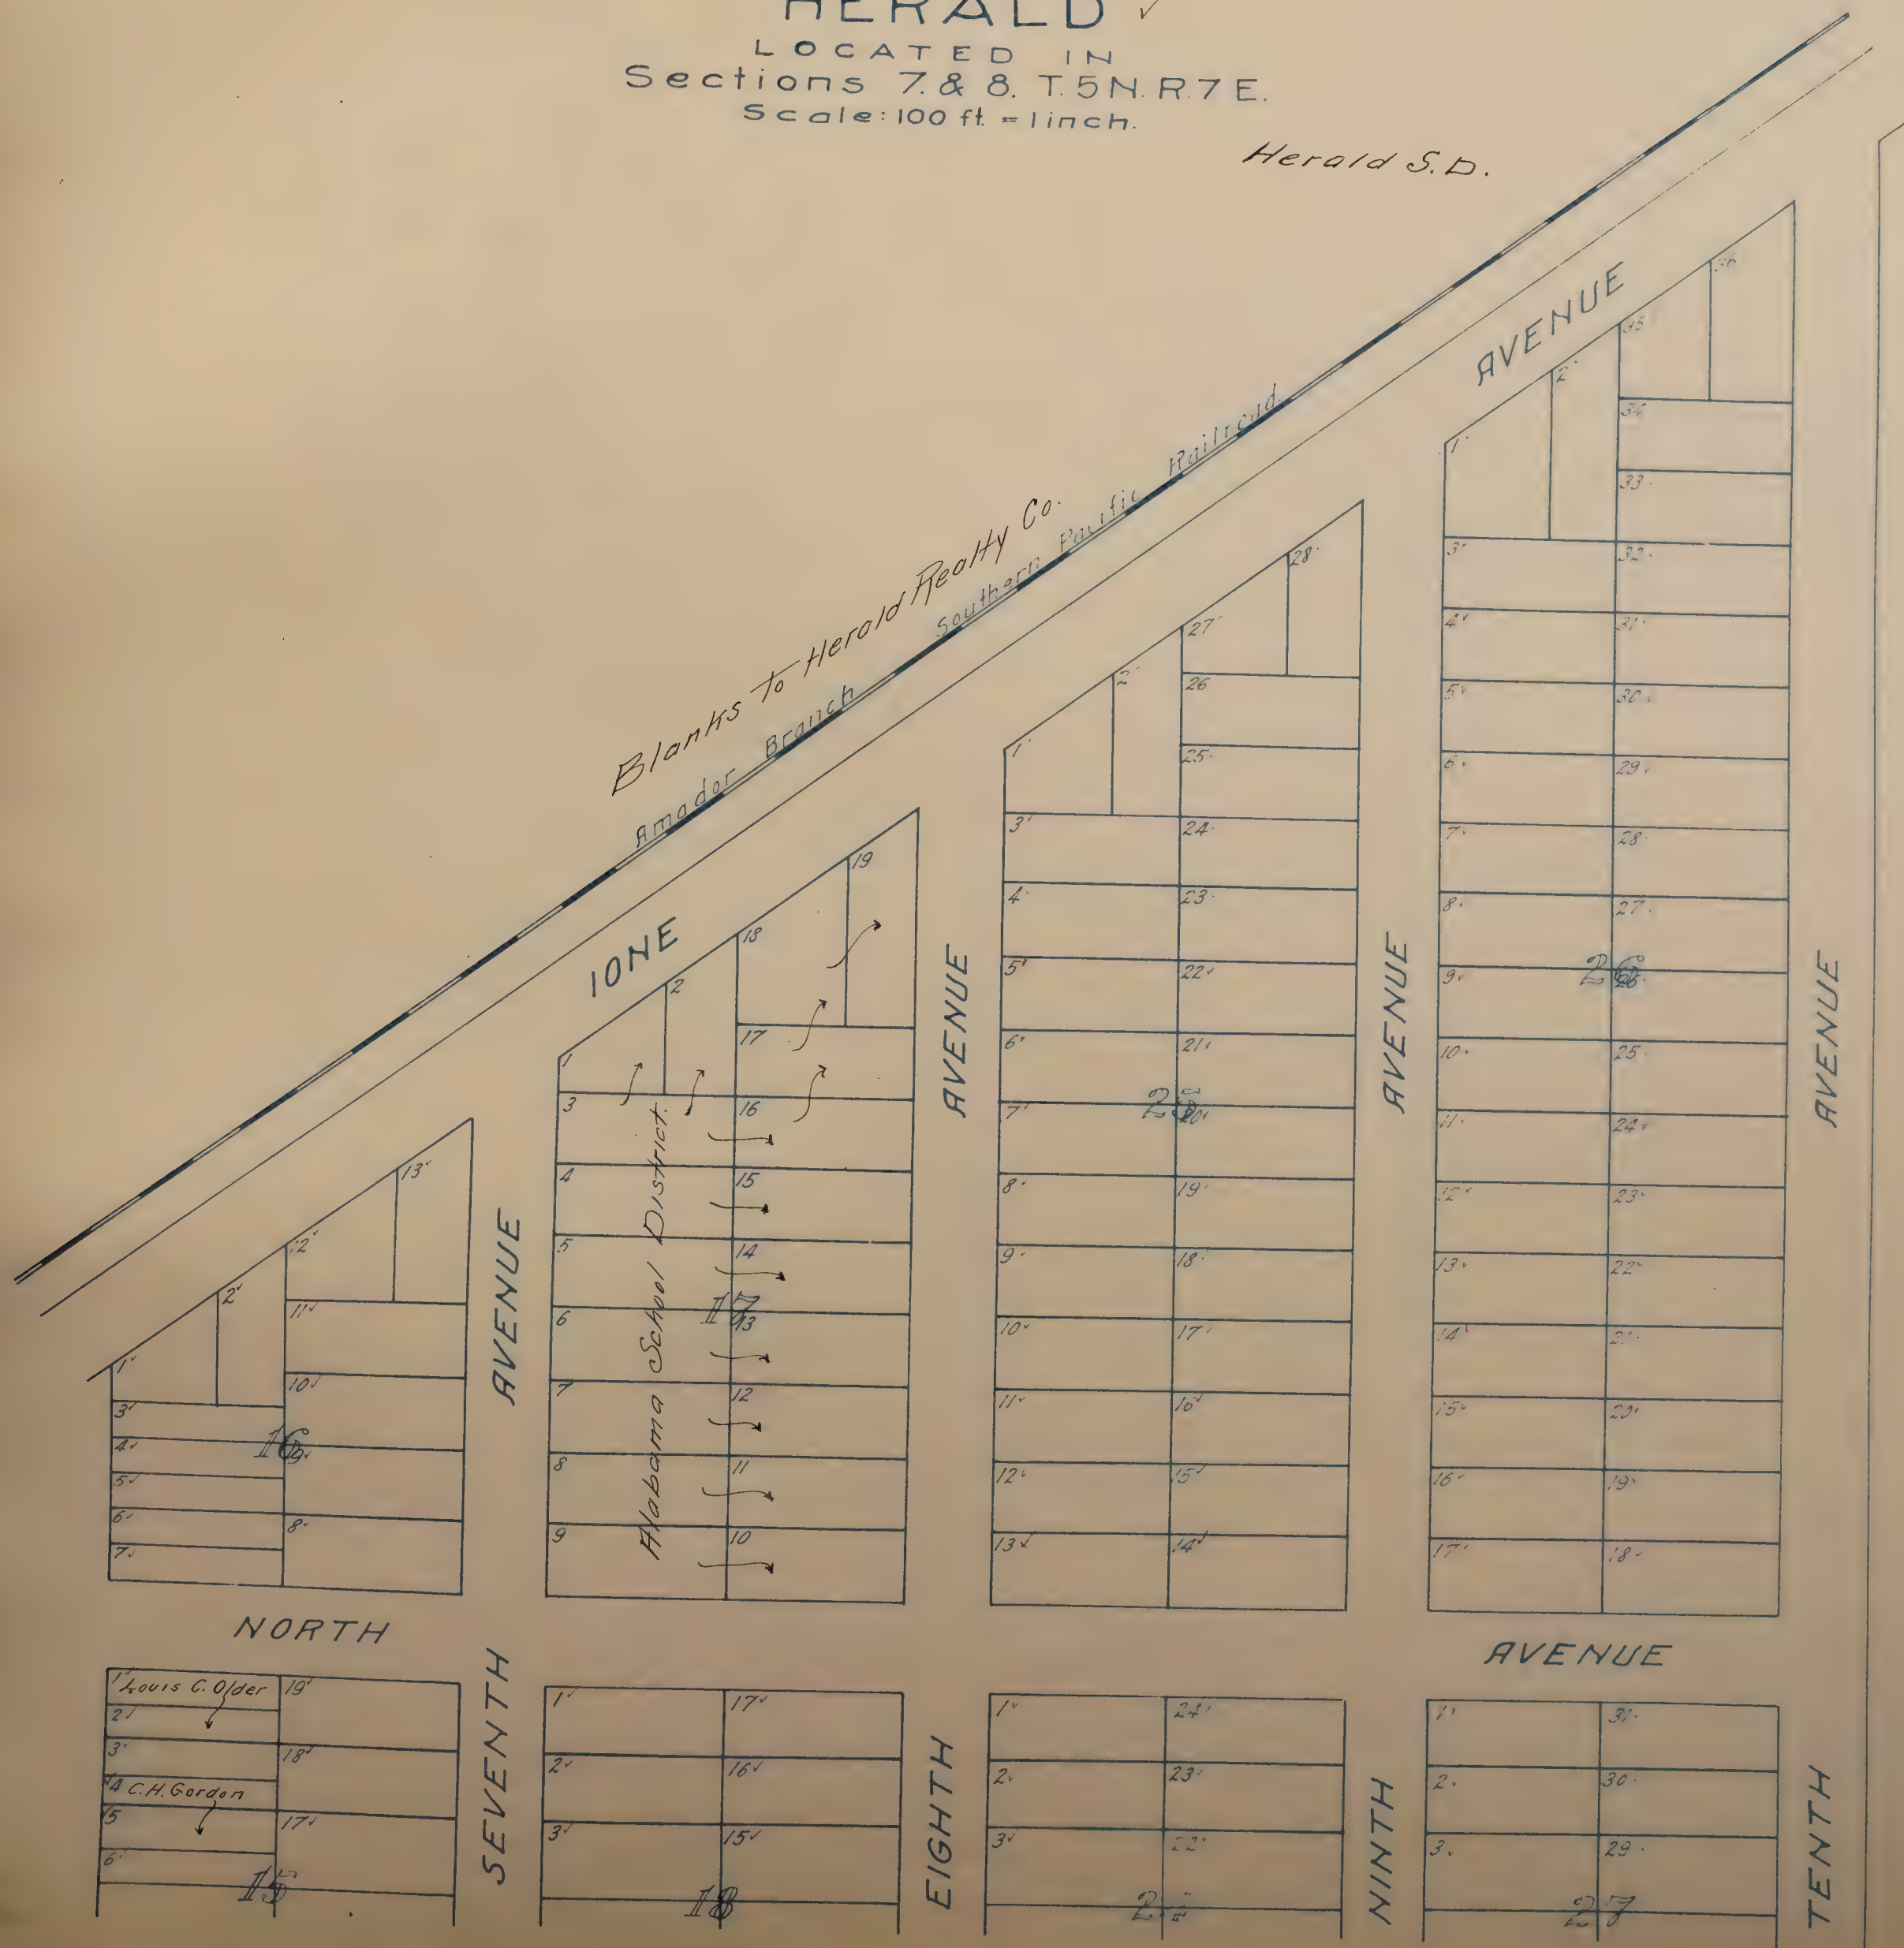

Blotrs to Herald Realty Co.

HERALD ✓

LOCATED IN
Sections 7 & 8 T5N.R7E. Herald S.D.
Scale: 100 ft. = 1 inch.



KATHARINA HERGET ✓


Located in

SEC. 26, T. 9. N. R. 4 E.

Scale: 1 in = 400 ft.

Jefferson S.D.

S. L. S. 423

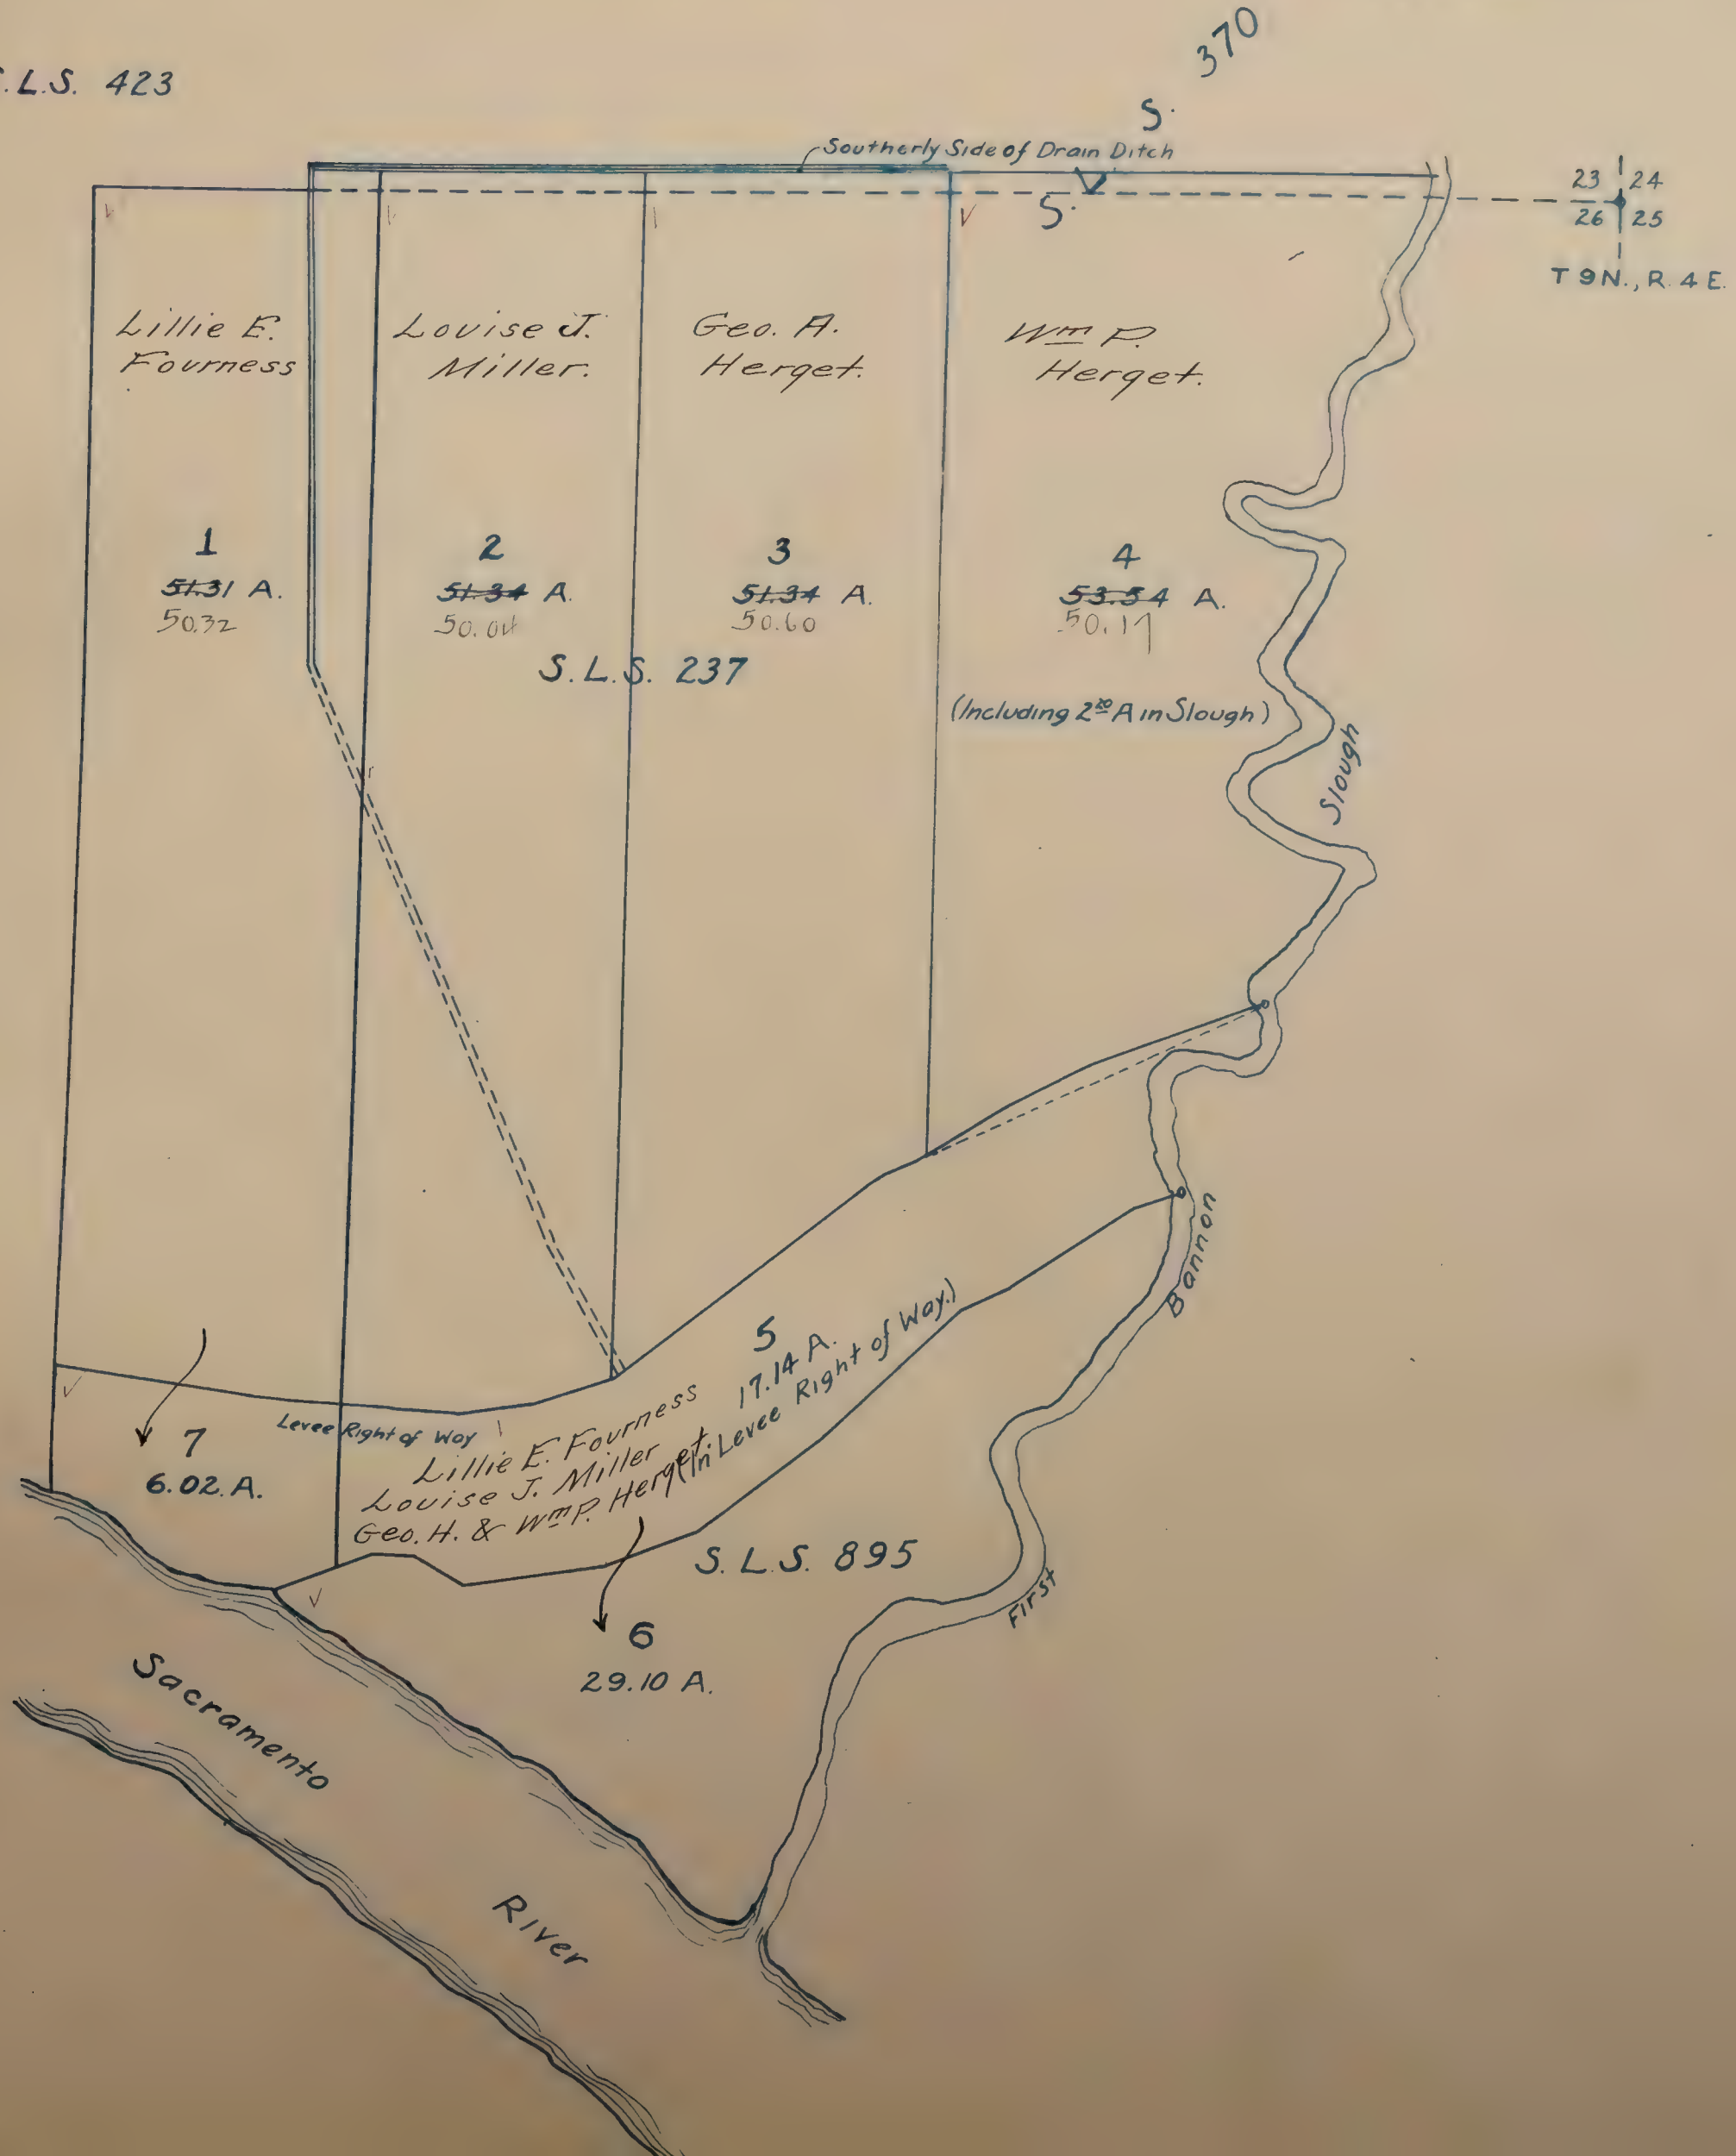


HEWITT SUBDIVISION NO. 1 ✓

located in
Section 22 T.7N.R.5E.
Scale: 1"=400ft.

Section 22

Blanks to Henry Hewitt.

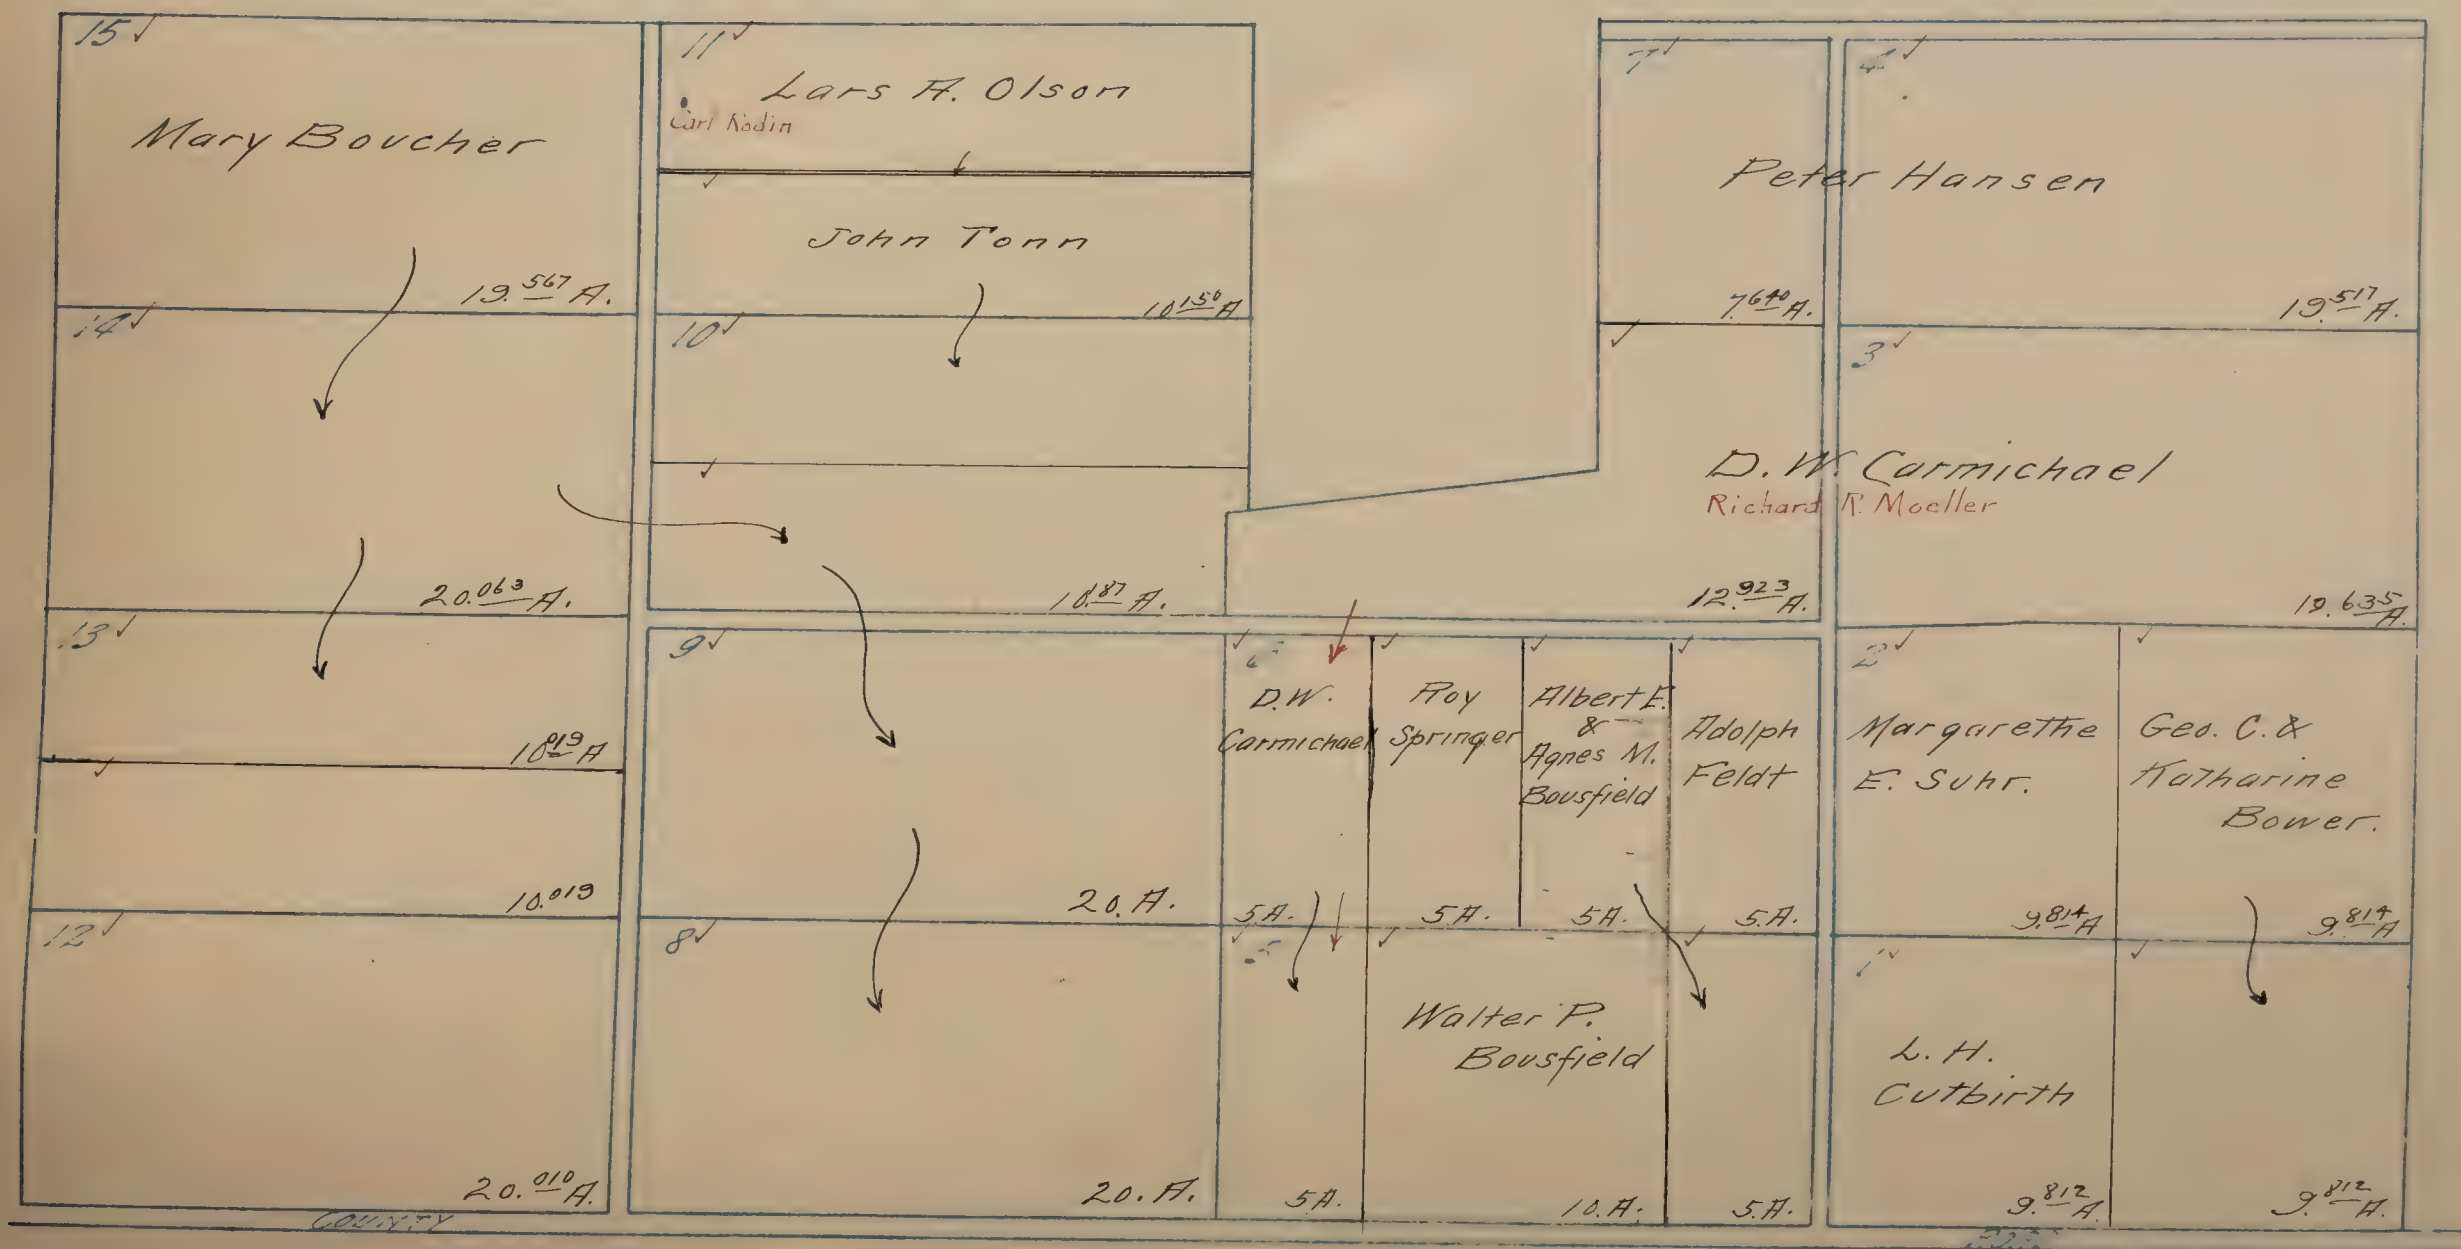

HEWITT SUBD'N. NO. 2 ✓

located in
Sec's 25 & 26 T.7 N. R.5 E.
Scale: 1" = 400 ft.

Elk Grove SD

Blanks assessed to Henry Hewitt.

Hewitt Sub. No. 3.

C.H. - H.H. & A.V.
Ipsen.

9.278 A
10.040 A

10 A.

10.43 A.

8 ✓

7 ✓

Carrie
Ambjor

10.858 A.

10 A.

20 ✓

19 ✓

4 ✓

20.270 A.

19.705 A.

18 ✓

3 ✓

65.813 A.

20.642 A.

19.836 A.

6 ✓

2 ✓

Harold Avery

Sullivan & Smith.
Robert Hughes, Jr.

10 A.

Not in Sub. 2.

5.202 A

19.77 A.


9.902 A.

HEWITT SUBD'N NO. 3 ✓

located in
Sec. 26 T. 7 N. R. 5 E.
Scale: 1" = 300 ft.

Elk Grove S.D.

Blanks assessed to Henry Hewitt.

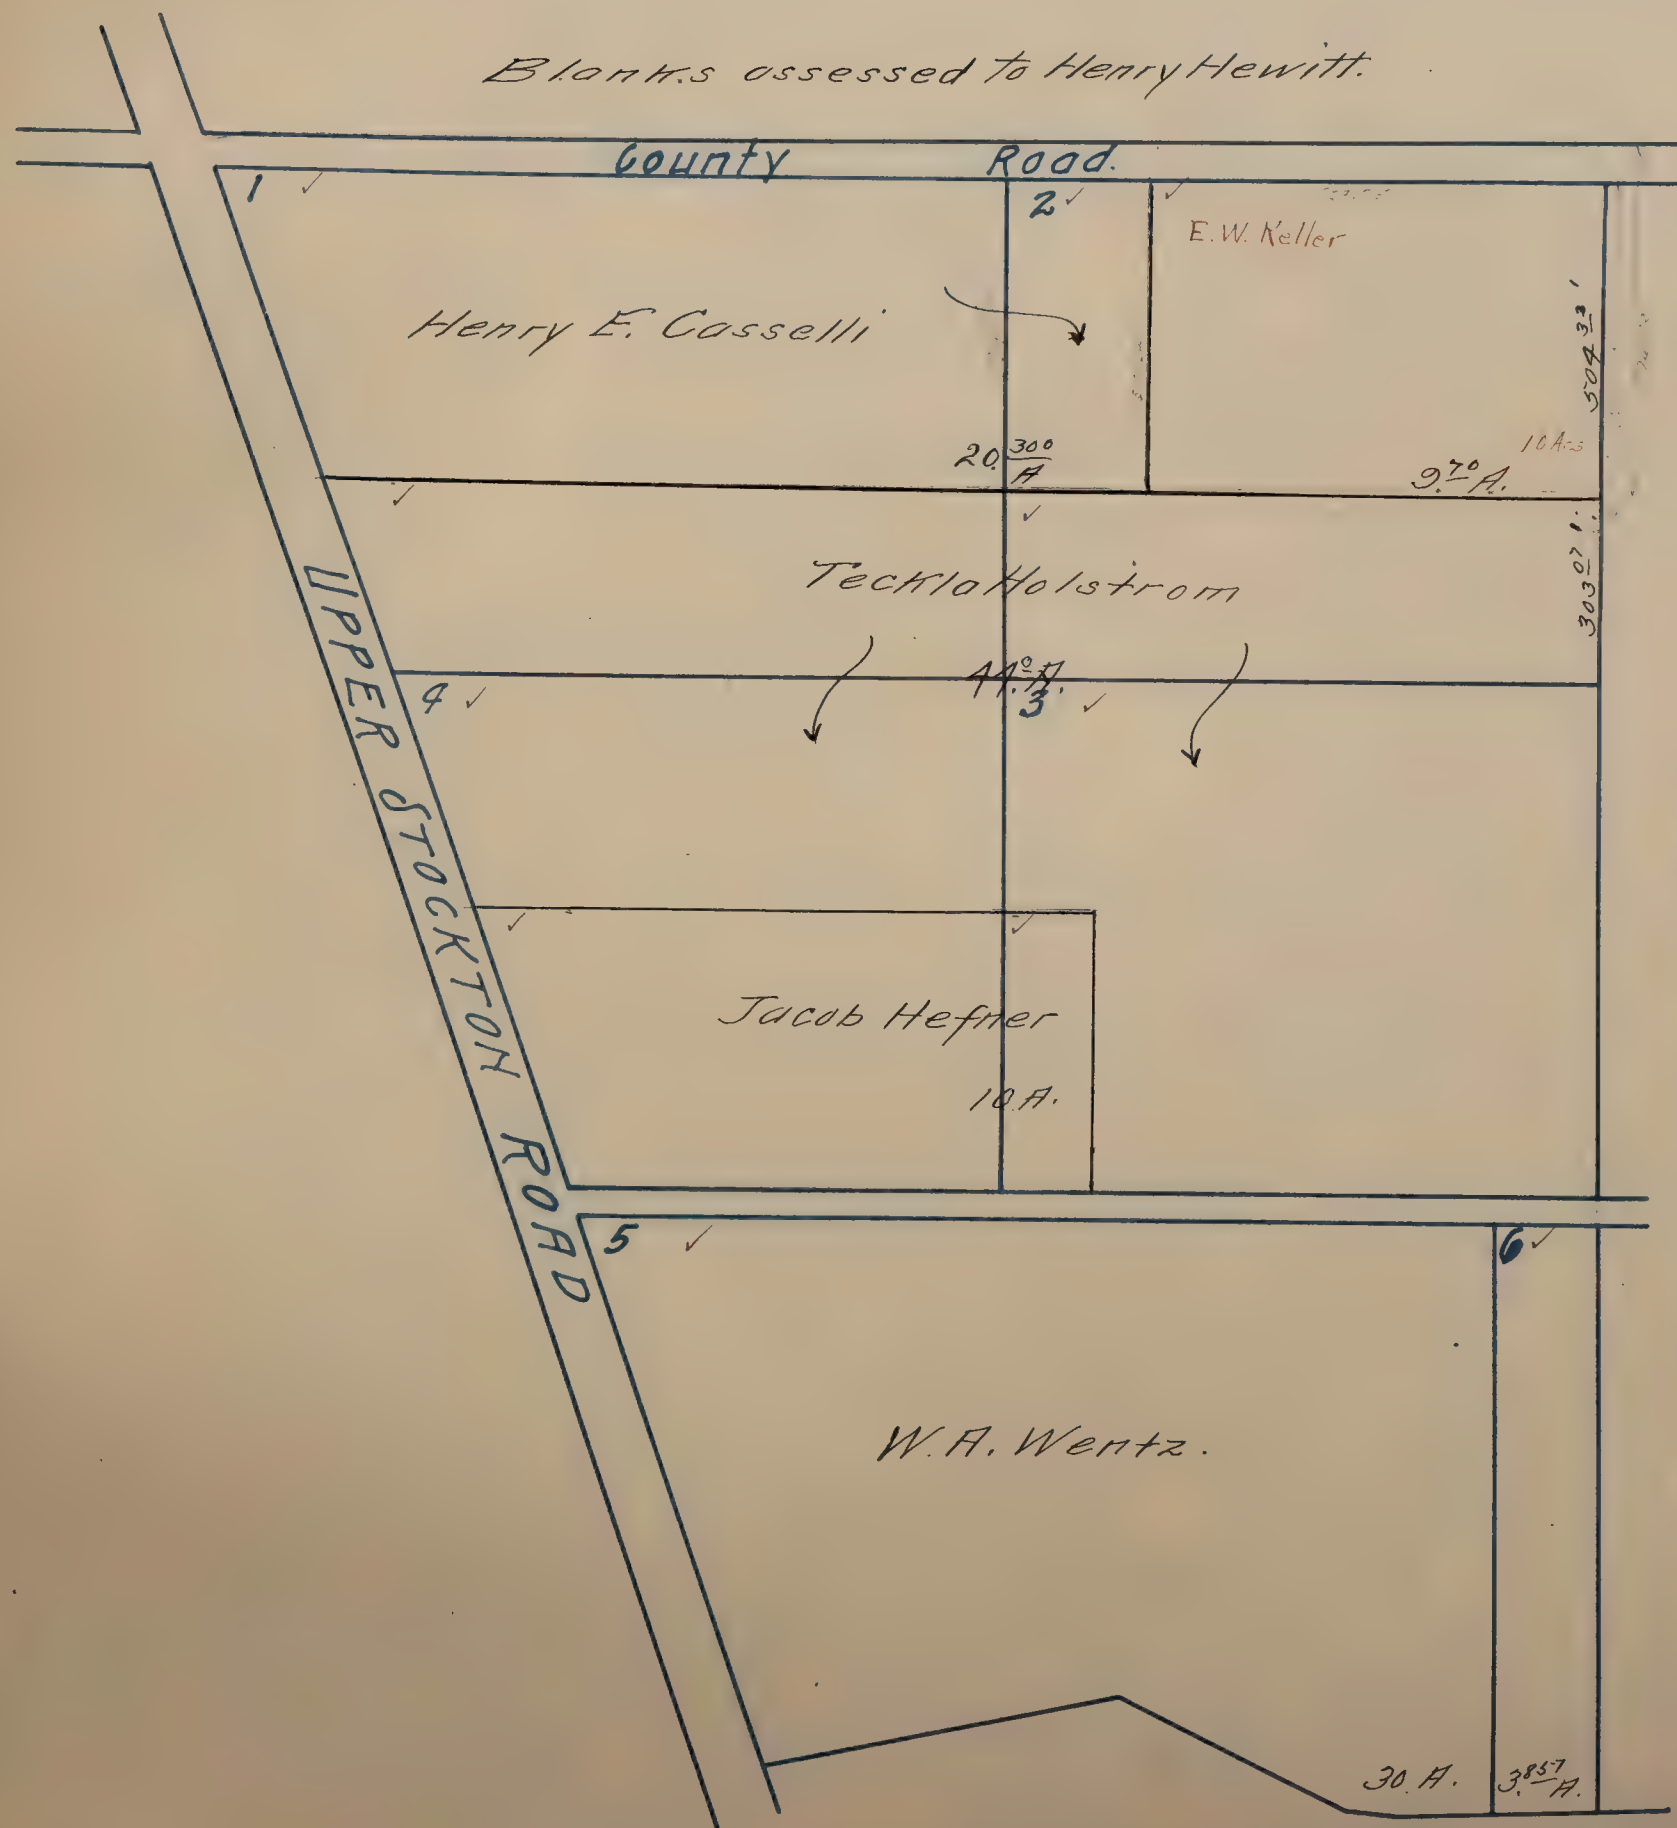

HEWITT SUBD NO. 2


HEWITT SUBD NO. 2.

HEWITT SUBDN NO 4 ✓

located in,
Sec 15 T7N R5E.
Scale 1"=500'

Jackson SW

Blotrs To Henry Hewitt.

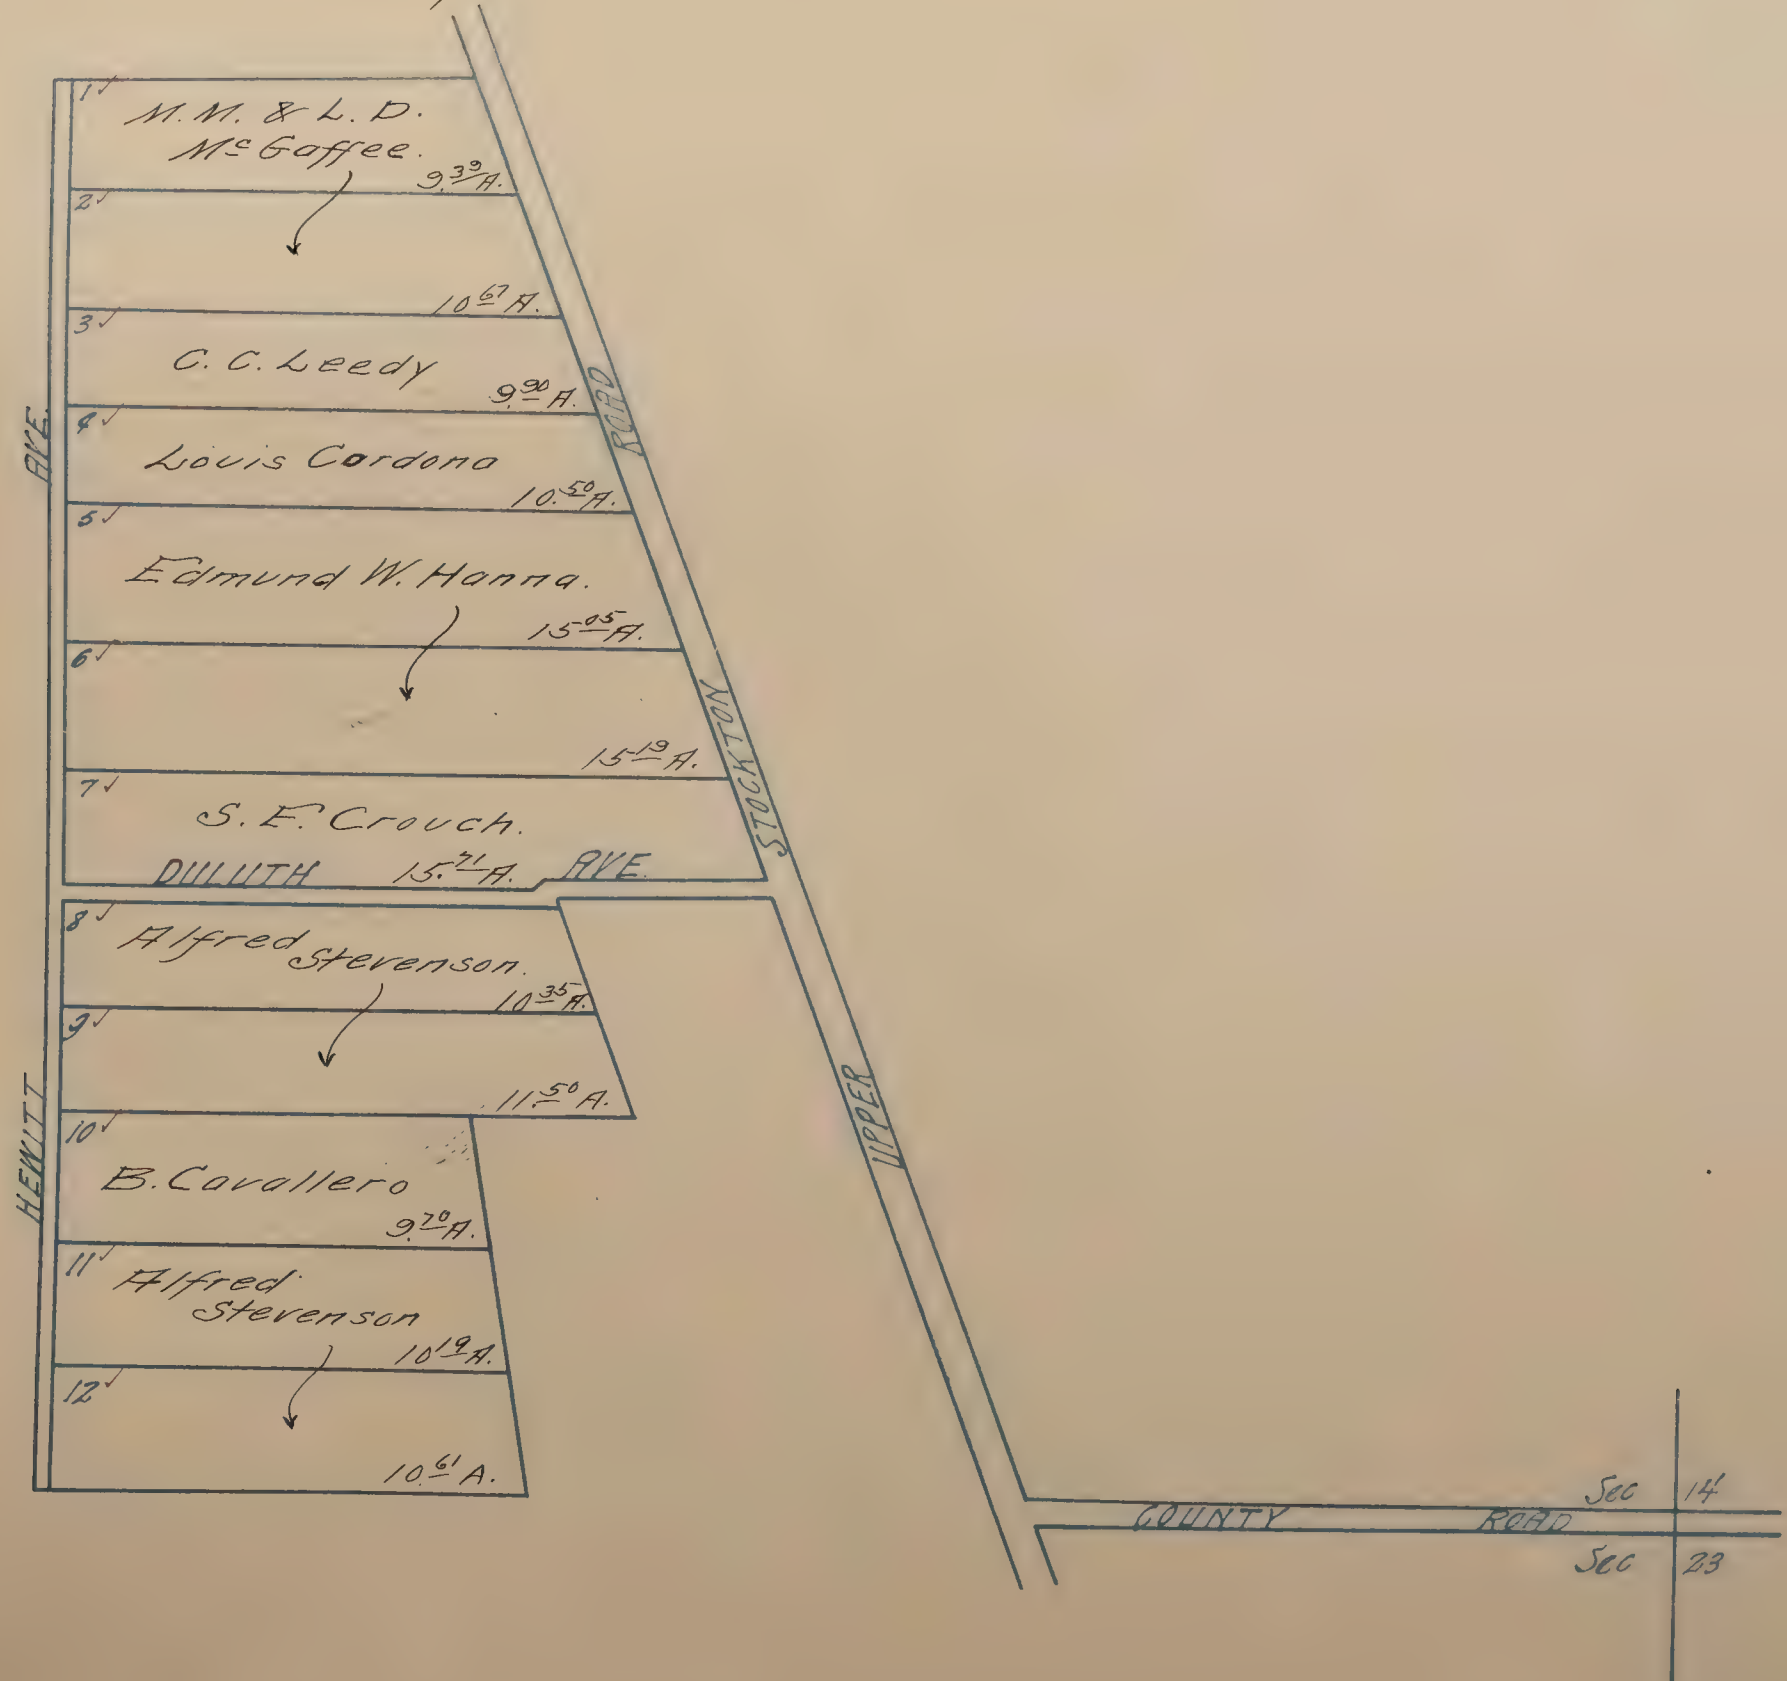

HEWITT SUBDIVISION NO. 5. ✓

LOCATED IN
SEC. 26, T.7N., R.5E. M.D.B. & M.
SACRAMENTO COUNTY, CALIF.

Scale: - 1" = 300'

Elk Grove S.D.



HILLSIDE TERRACE ✓

NE 1/4 Section 20, T8N R8E

Fruit Ridge S.D.

Scale 1" = 40'



HOOD

LOCATED IN

S.L.S No439,235 & 236 Secs 14 & 15 T6NR4E

Scale: 125' = 1" Richland S.D.

SHEET 1

All blanks assessed to Hood Improvement Co.

SACRAMENTO RIVER



SL5 14292300 7500 410 / 6NRA1

SHEET 2



MAIN LINE SACRAMENTO SOUTHERN R.R.

HUNGER TRACT NO.1 ✓

located in
S 1/2 Sec. 20 T. 8 N. R. 5 E.

Scale: 1" =

Blanks to F. J. Hunger.

~~Colony S.D.~~ Large Lots 1 Ac.
Small " 1/2 "

SACRAMENTO HEIGHTS Fruitridge S.D.

FRUIT RIDGE PARK

ROAD

COUNTY

1✓ W.E. Yeaw	2✓ Alfred & Susan G. Naylor	3✓ Frank & Casselli	4✓ J.H. & Kate Crone	5✓ John & L. Dellea	6✓	7✓
PERRY AVENUE						
14✓	13✓ W. & M. Silva	12✓ W. & M. Silva	11✓ C.F. & E.M. Dougherty	10✓ Marvella H. Smith	9✓	8✓
15✓	16✓	17✓	18✓ S. G. Saunders	19✓	20✓	21✓
COLOMA AVENUE						
28✓ James E. Stevens	27✓	26✓	25✓	24✓	23✓ Edward Caselli.	22✓

ISLETON ✓

Scale 50 feet = 1 inch.

SACRAMENTO

RIVER

Isleton S.D.

WHARF

Creamery

PUBLIC SCHOOL

ST.

BLOCK 2

BLOCK 3

4640
Sq. Ft.

SECOND

ST.

ST.

Bank of
Isleton

W.M. Hutton.

O.C. Wilson

Gardiner
Imp't. Co.

Gardiner Imp't.
Co.

BLOCK 5

BLOCK 4

J.C. Crump.

S.M. Dickey

Ivan H.
Hamilton

Jacinto DePonte
Rogue.

THIRD

ST.

C.

Joe M. Borba
"etal"

Gardiner Improvement Co.

BLOCK 6

John Mario
Randall
F. Huntley

Gardiner
Imp't.
Co.

M.E.
Church

Gardiner
Imp't. Co.

Julia
Fernandez

Garret D.
Hart F.
Warren W.
Smith.
Alice M.
Bryan
&
Laura E.
Doty.

Frank
Gomez


Gardiner
Imp. Co.

JACKMAN TRACT ✓

BEING THE
S.W. 1/4 of Sec. 19, T.8N., R.6E

Scale: 400' = 1"

SIERRA S.D.
~~Enterprise S.D.~~

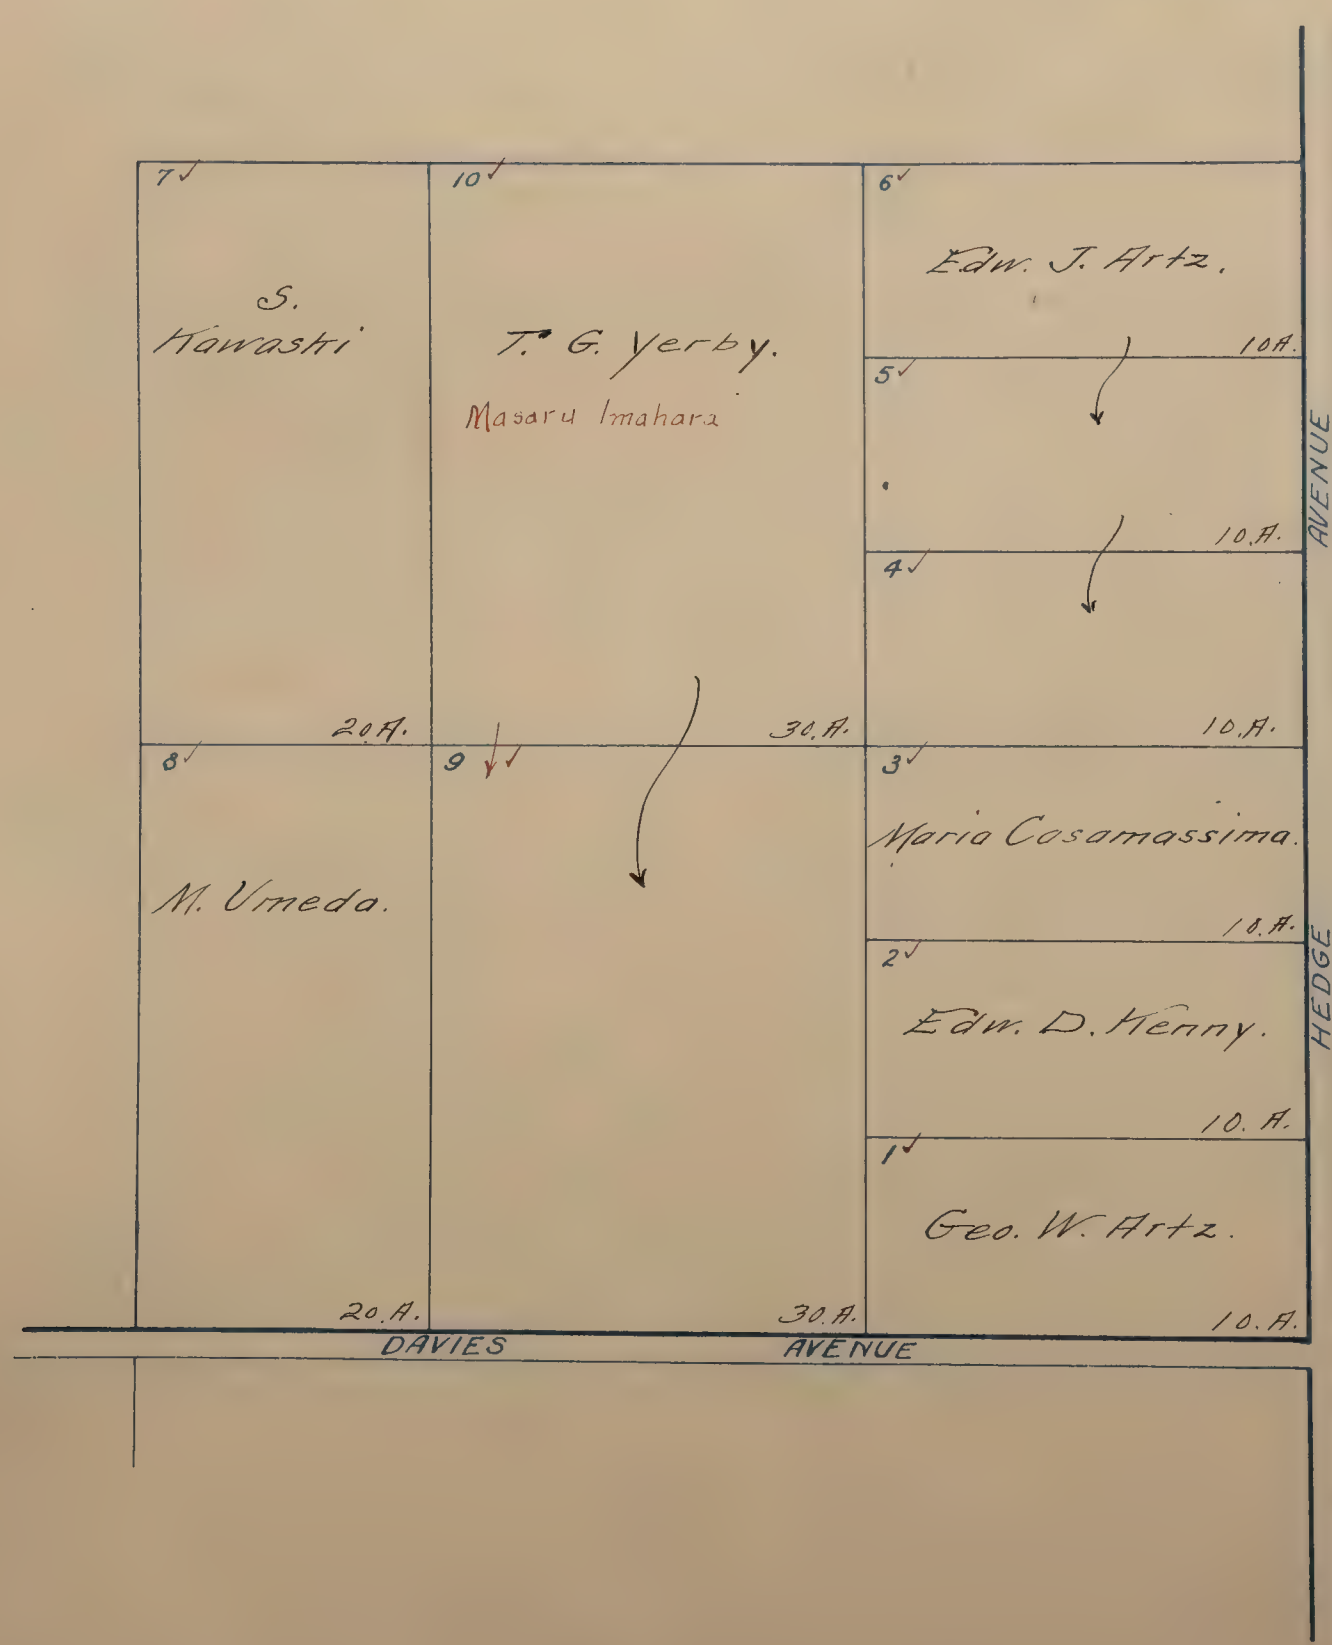


JACKMAN TRACT ✓

BEING THE
S.W. 1/4 of Sec. 19, T.8N., R.6E

Scale: 400' = 1"

SIERRA S.D.
~~Enterprise S.D.~~

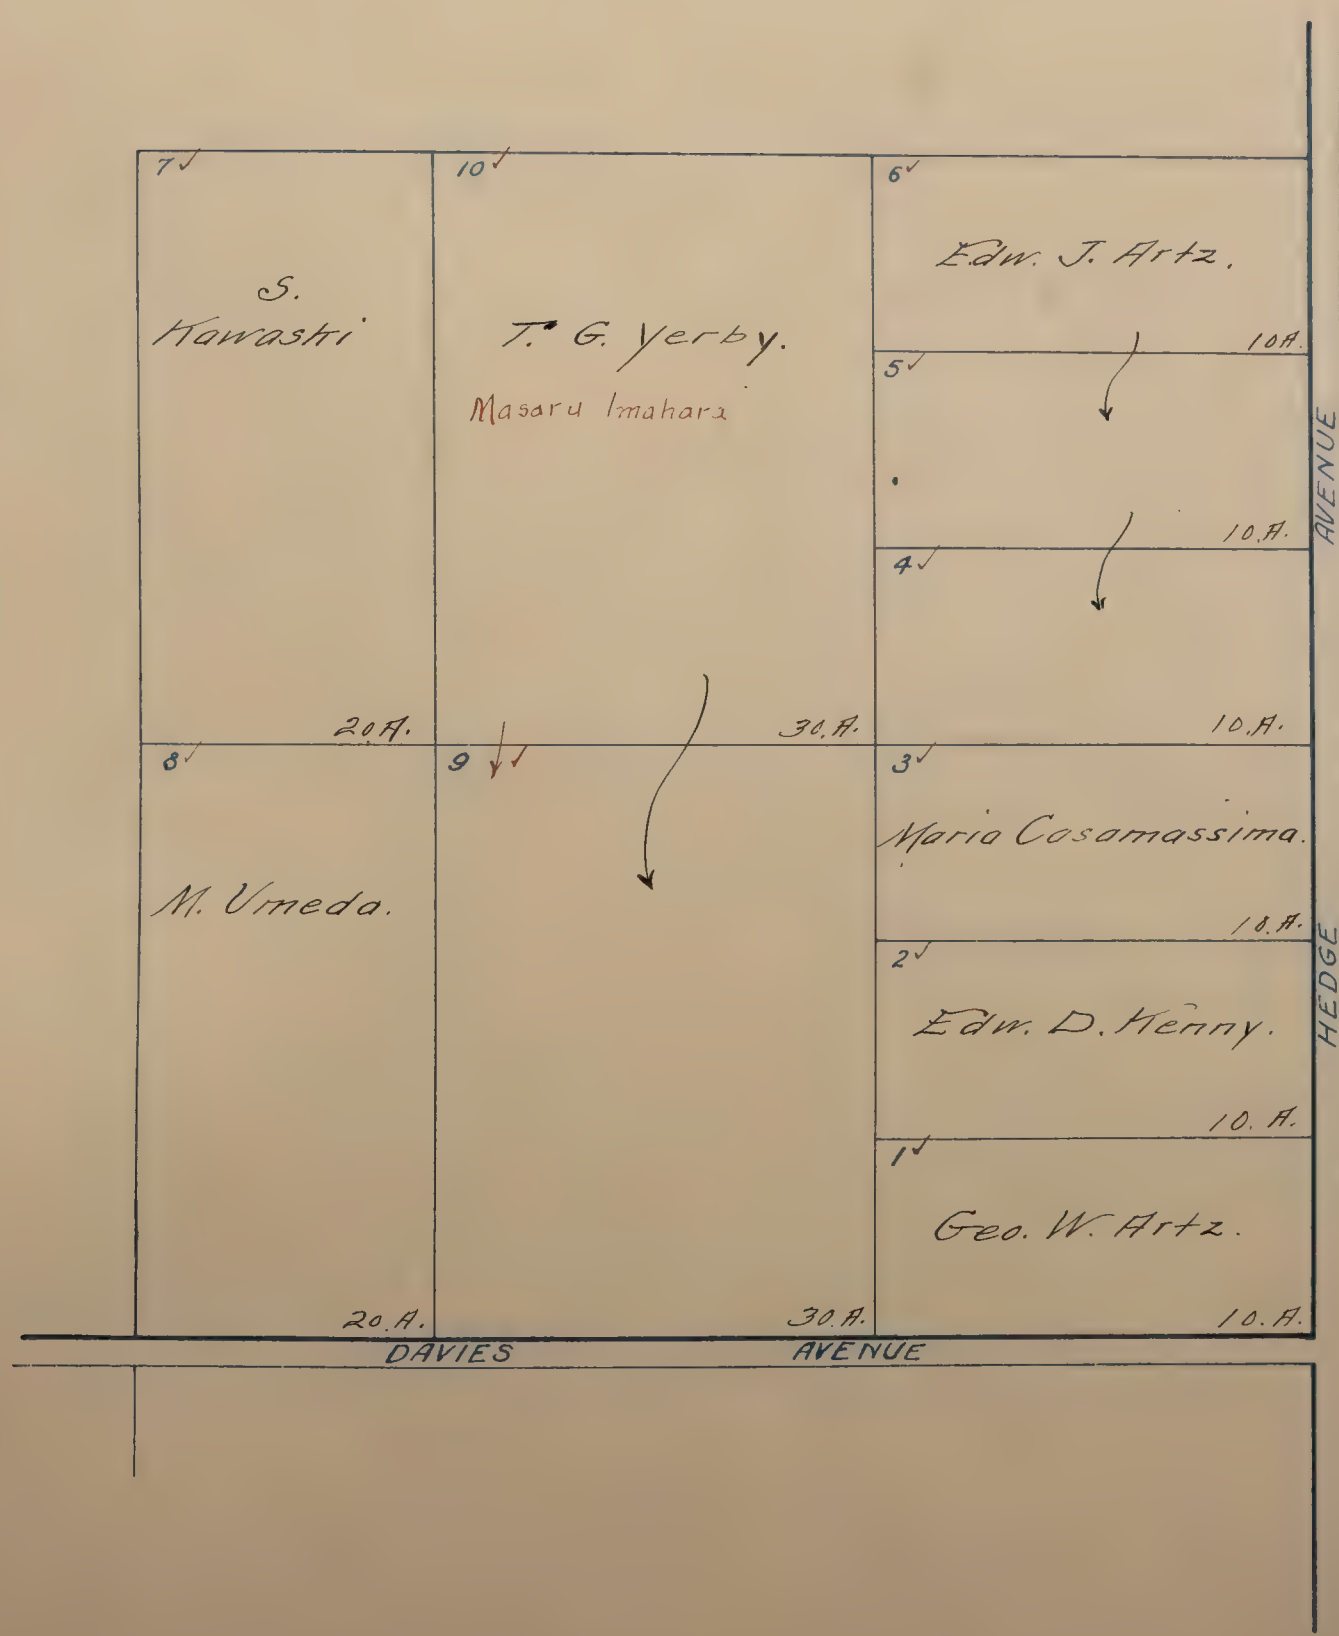

O.B. Jackman
Section 15 T.8N.R.5E. M.D.B.&M.
Scale: 1" = 100'

Junction S.D.

O. B. Jackson.

Parcel - 2
10.92 AC.

O. B. Jackson.

Parcel - 3

6.24 AC.

Alpine Goat Dairy, Inc.

Cesar B. Jackman =

Parcel - 1

9.90 AC.

Geo. F. Evans.

Rodergerdts & Schmidt

~~STREET~~

JENSEN VILLA ✓

LOCATED IN
N.W. 1/4 of Sec. 19, T.8N.R.5E.

Scale: 1"=60'

FRUIT RIDGE, S.D.

Blank's assessed to Annie M. Jensen.

SHOP SITE

WESTERN

AVENUE

A

J. C. Jensen.

B

SUNSET

AVENUE

C

24th STREET ROAD

Western Pacific R.R.

JOHNSON HEIGHTS

LOCATED IN
S 1/2 of Sec. 3. T9NR5E
Scale: 450'=1"

DEL PASO HEIGHTS, S.D.

All Lots 5 Acs. unless otherwise noted.



AMENDED PLAT OF JOHNSON HEIGHTS ✓

LOCATED IN
S ½ of Sec. 3 - T.9N.R.5E.
Scale: 450' = 1"




KENNEDY ACRES

BROOKE REALTY CO'S SUBDIVISION 107.

Scale 200feet=1inch

WASHINGTON S.D.

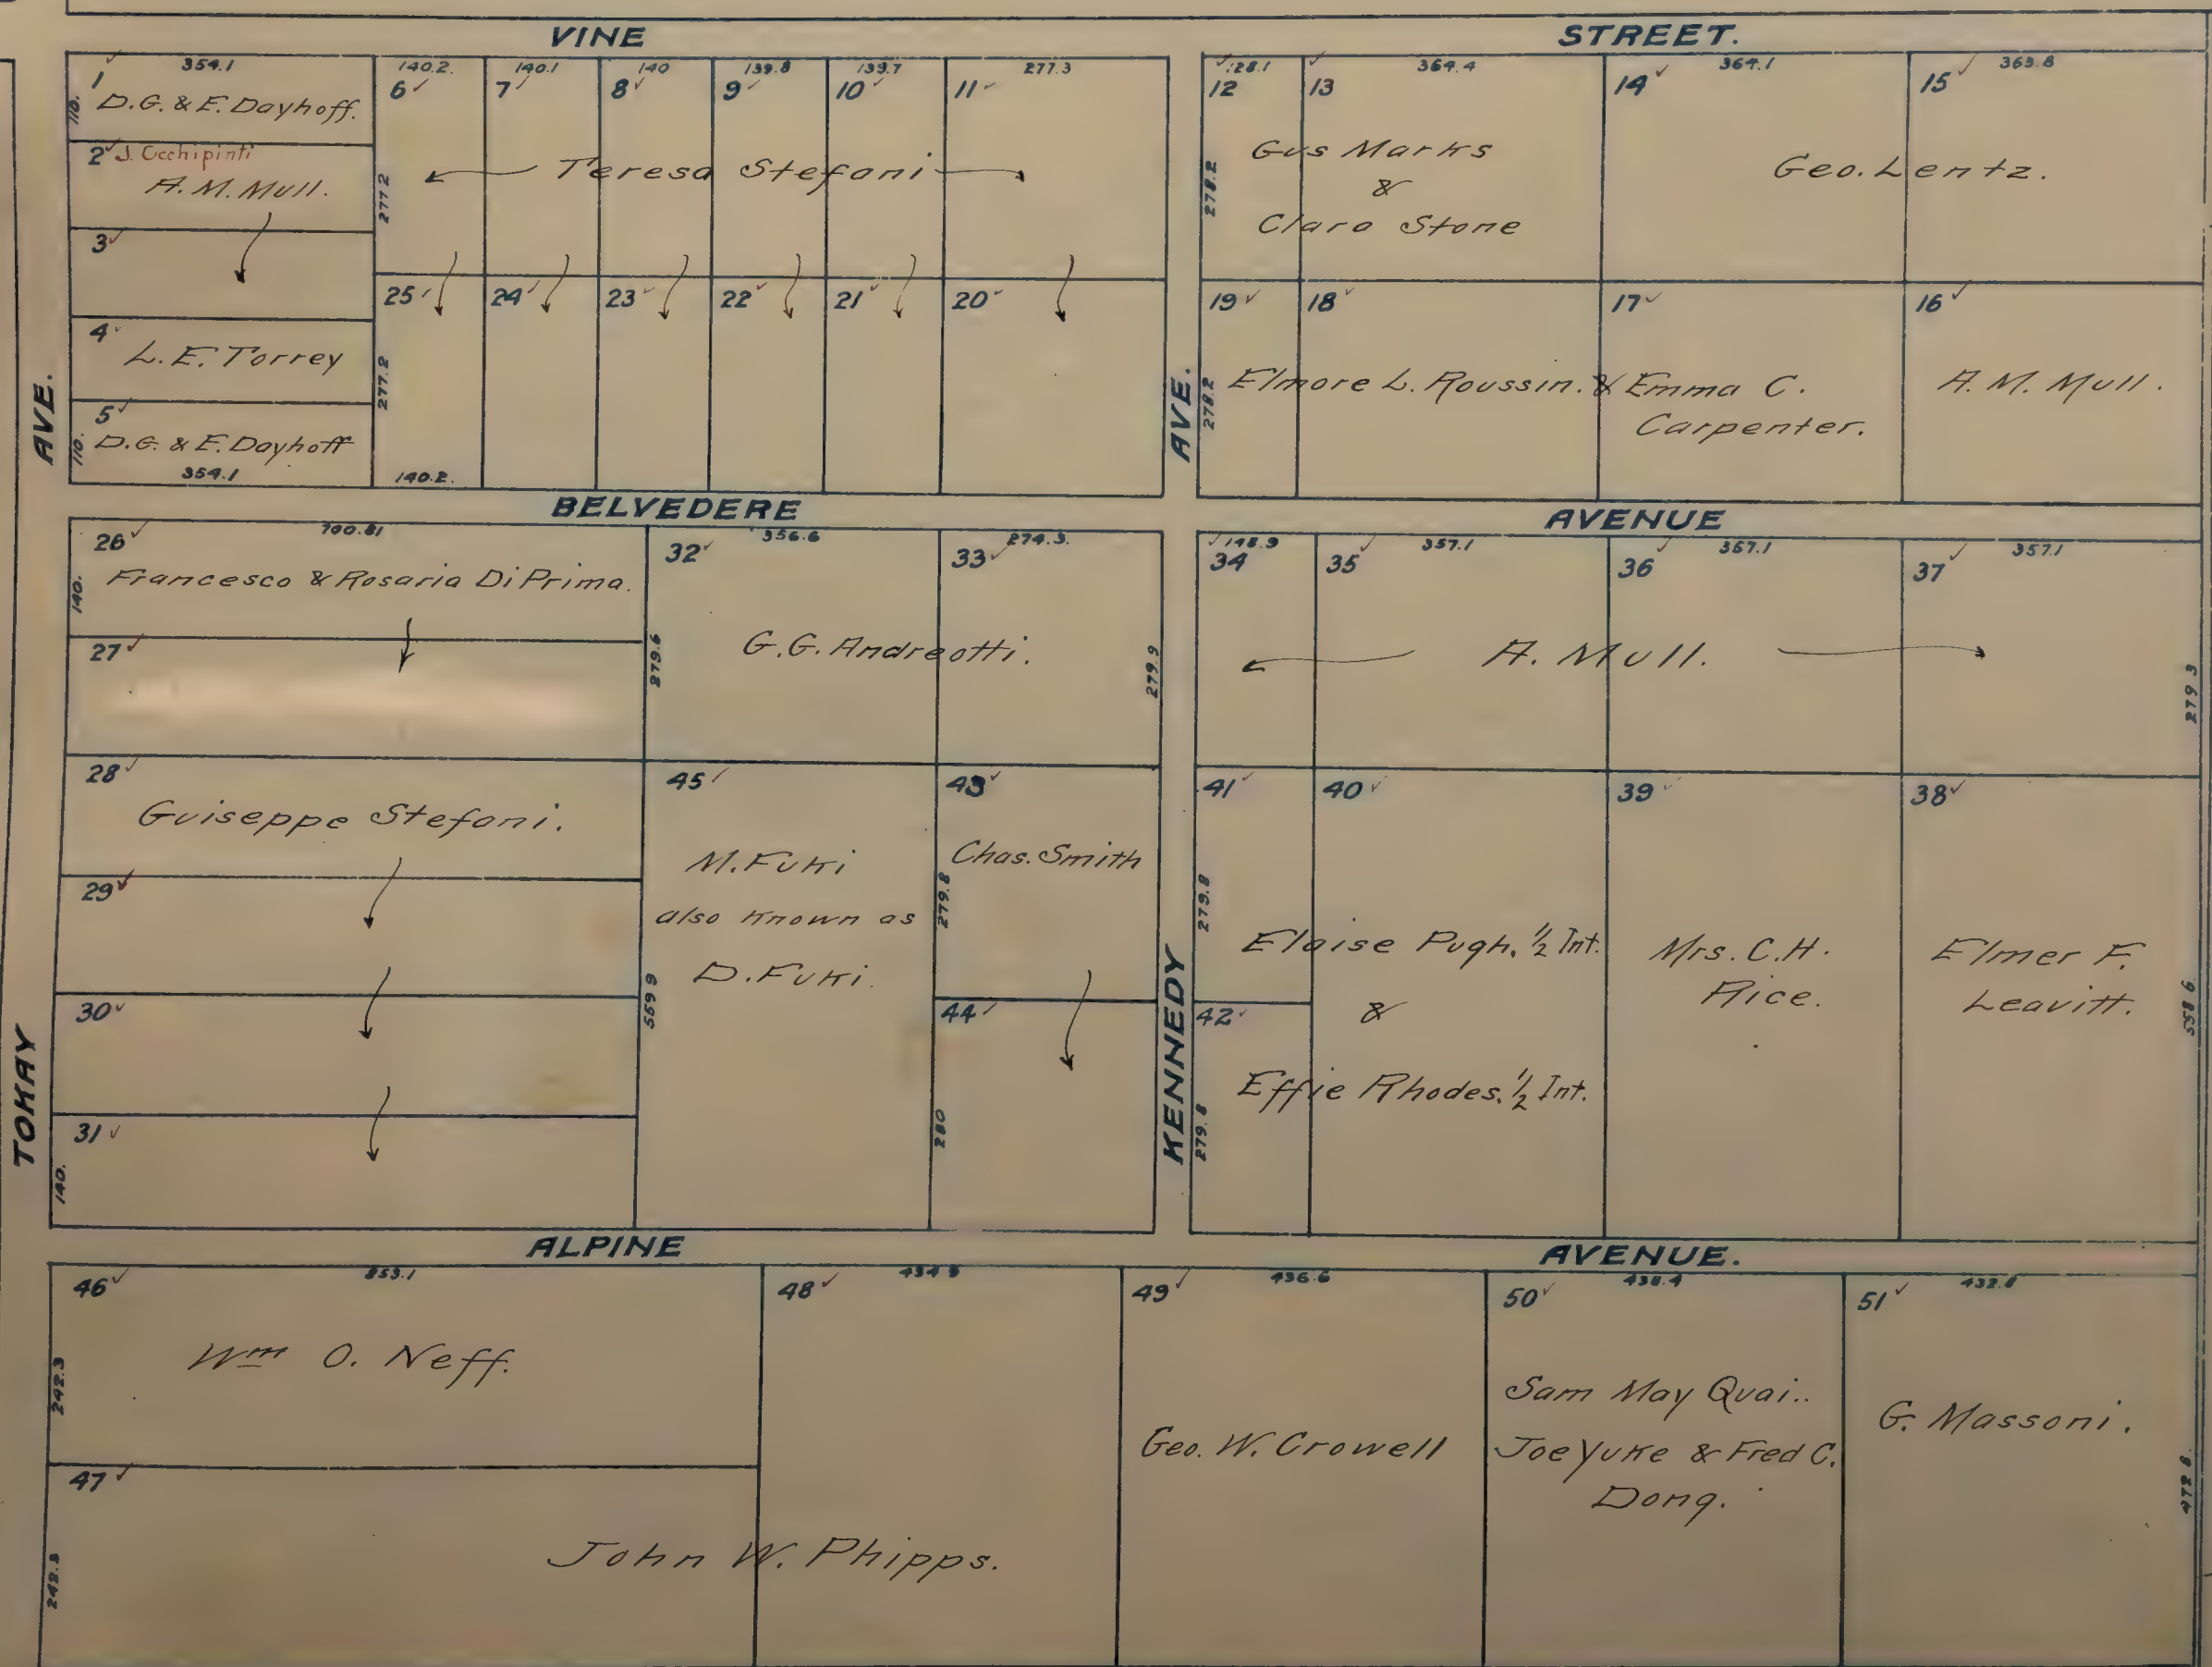

KIESSIG TRACT

LOCATED IN
NW 1/4 of NE 1/4 of Sec. 31 T8N.R.5E.

~~Enterprise S.D.~~

PACIFIC S.D.

COUNTY		ROAD	
1. ✓	2. ✓	3. ✓	4. ✓
H. J. Jones.	Ralph H. Stephens	H. J. Jones.	F. L. Dean. Marie Bartock
KIESSIG		AVENUE	
8. ✓	7. ✓	6. ✓	5. ✓
Henry Kiesel. Hattie Woods & Wm L. Still	Etta L. Sherer →		


KILDONAH OAKS ✓

located in
Section 22 T7N R.6E.
Scale: 1"=300ft.

Pleasant Grove SD.

Blanks To Susan C. Alltucker.

This prop now in storage
See Map 22-7-C

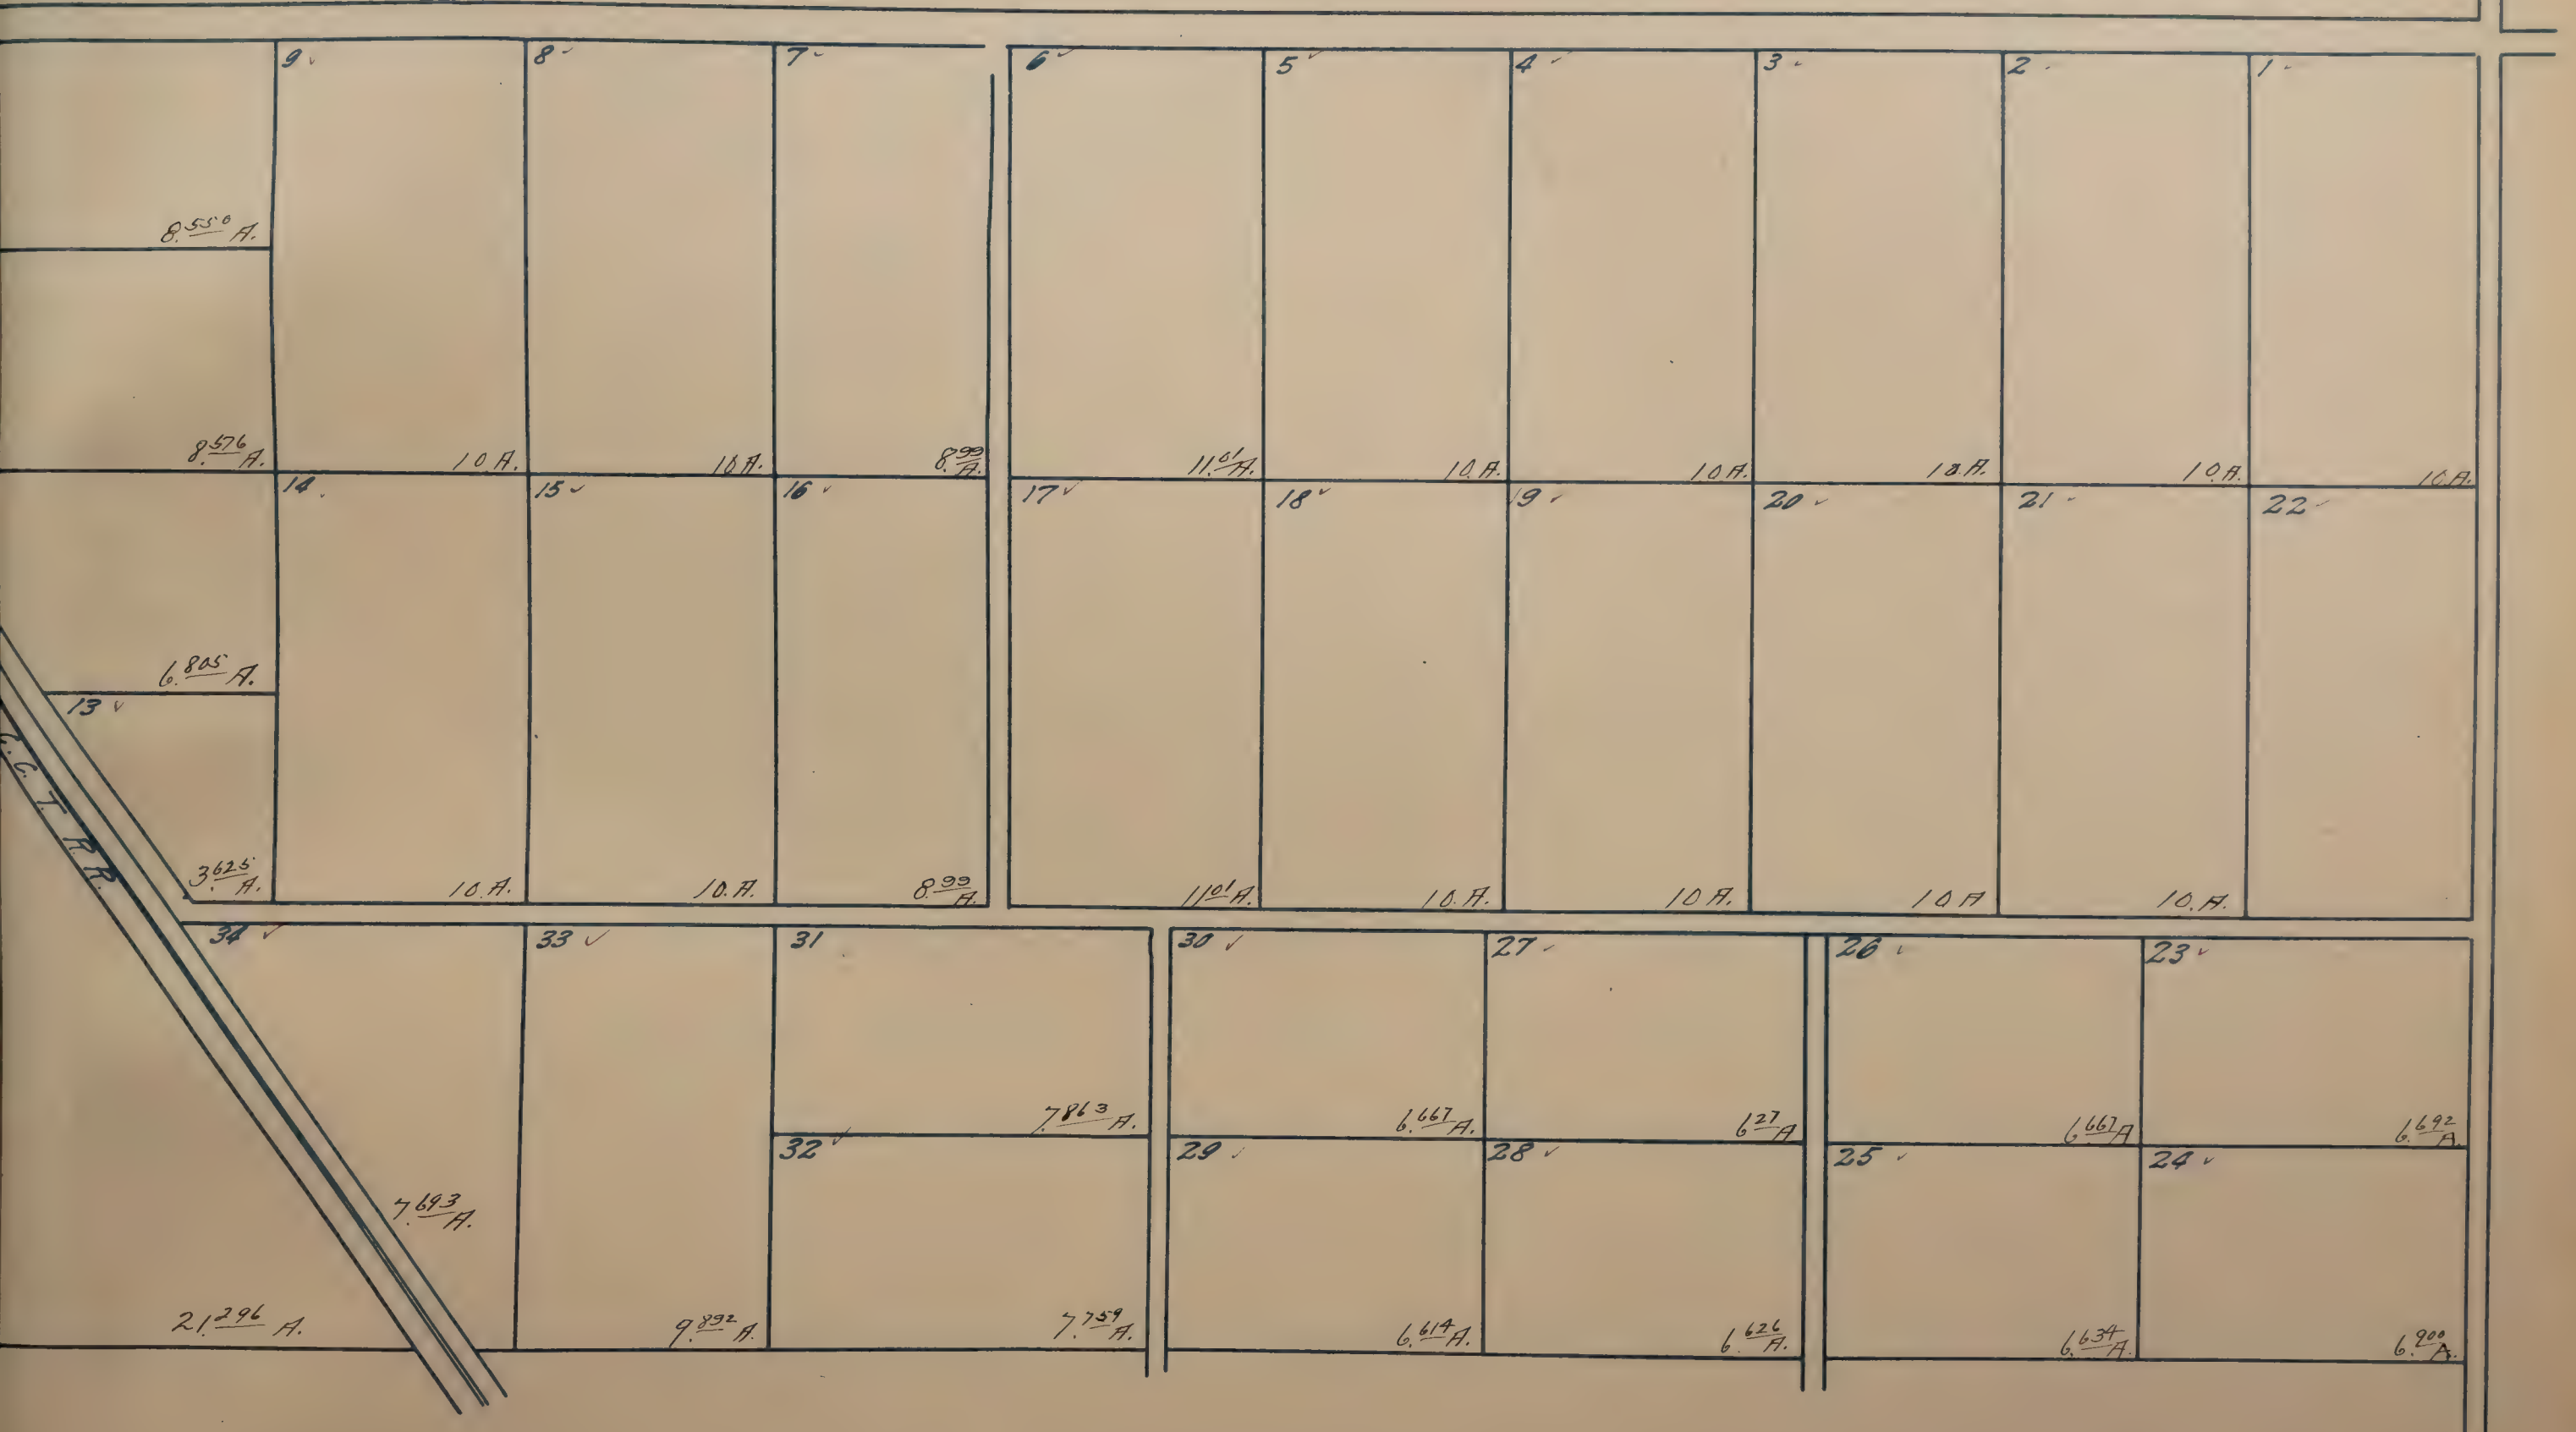


LAKE HOUSE ACRES ✓
OR
BROOKE REALTY CO'S. SUBDIVISION NO 113.
LOCATED IN THE
N.E. ¼ of Sec. 33, T.8N., R.5E.
Scale: 200' = 1"



30

AMENDED MAP OF
LAKE HOUSE ACRES
OR
BROOKE REALTY CO'S. SUBDIVISION NO. 125.
LOCATED IN THE
N.E. 1/4 of Sec. 33, T.8N., R.5E.
Scale: 200' = 1"

Blanks assessed to John, Jacob, Frank, Julius,
Louis & Albert Young, & Bertha Schraft.

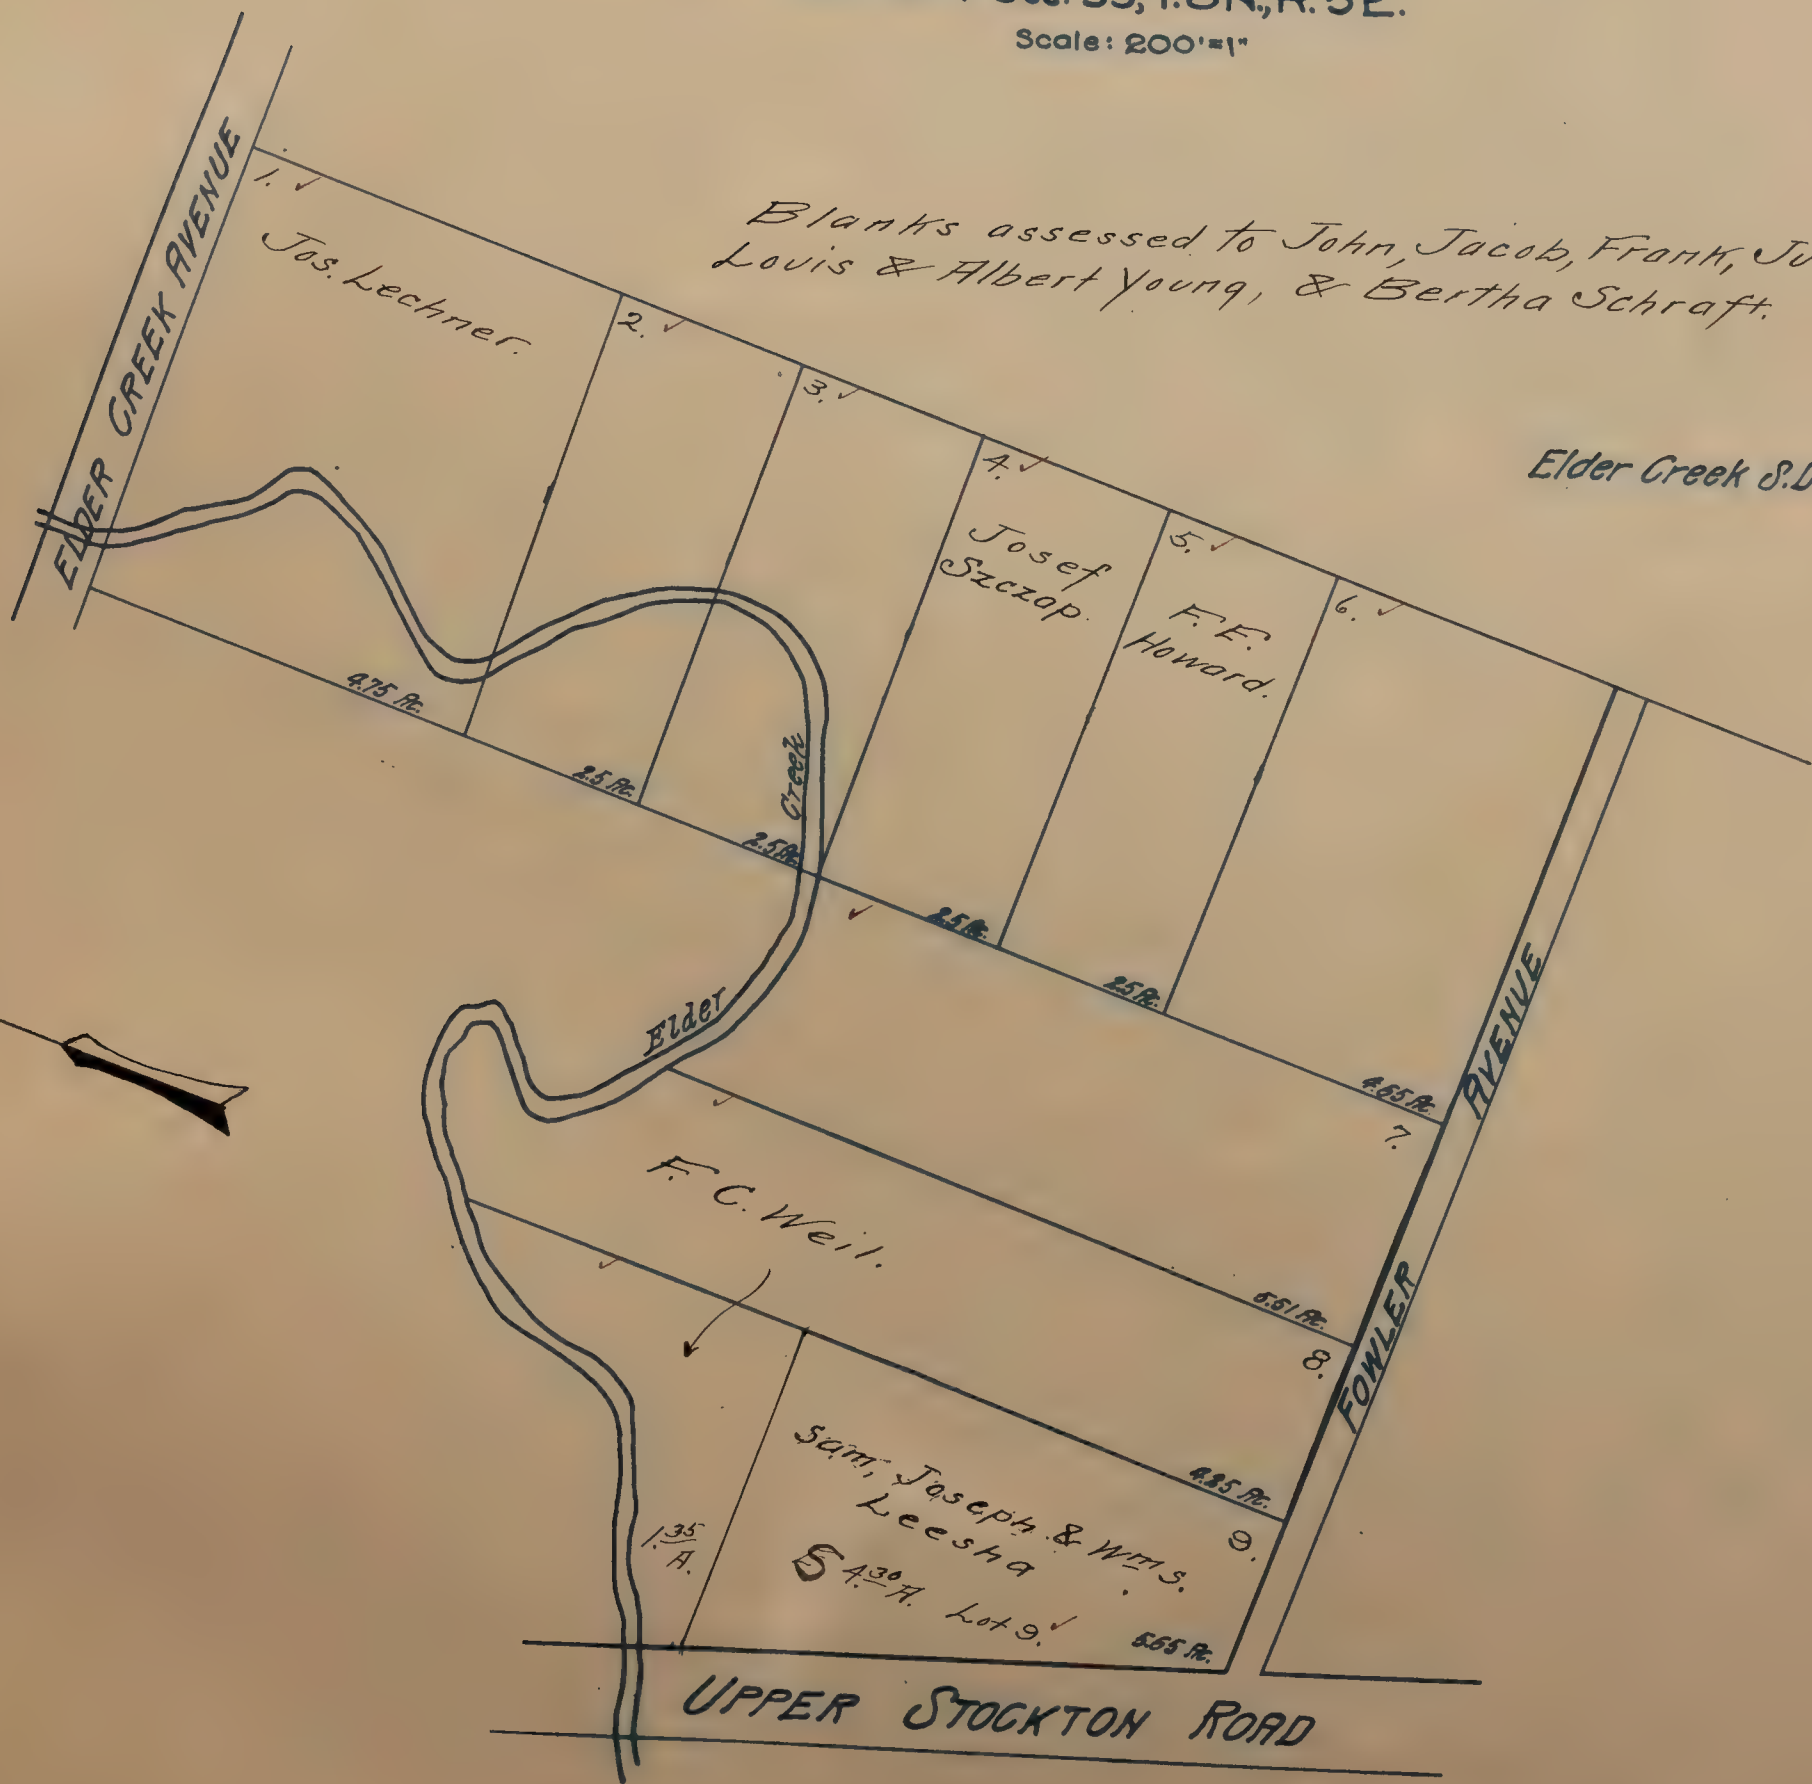

LAUREL HIGHTS ✓

BEING
Lot 37, Block 27 in the LOUISIANA TRACT
LOCATED IN THE
N.E 1/4 of Sec. 19 T. 8 N., R. 5 E.
Scale: 30' = 1"

~~Gatberg~~ 20
Fruit Ridge S.D.

LAUREL

AVENUE

HICKORY STREET

1' ✓ F.H. Crosby.	2' ✓ F.M. Tenbrook	3' ✓ Susan C. Hendrix.	4' ✓ F.M. Harlan	5' ✓ F.H. Crosby.	6' ✓ W.S. Ives	7' ✓ Elliott Cooper.	8' ✓
----------------------	-----------------------	---------------------------	---------------------	----------------------	-------------------	-------------------------	------

LEMON HILL ANNEX ✓

N. ½ of S.W. ¼ SEC. 27 T. 8 N. R. 5 E.

Scale 4 chains = 1 inch.

Elder Creek S.D.


1✓ P.J. Fitzsimmons S.A.	2✓ Rose Rio 1. H. A.A.	3✓ Toraro Cuccia S.A.	4✓ J. W. Reddick	5✓ J. H. Sellers	6✓ Martin Sapunar S.A.	7✓ V. Taveria	8✓ Wm L. Randolph.
16✓ Bell M. Goldstein →	15✓	14✓	13✓	12✓ Attilio Lazzarini Albert Lazzarini	11✓ R. Berriesford S.A.	10✓ Julio Costa	9✓ C. M. Goethe.

LEMON HILL TRACT ✓

S. ½ SECTION 28 T. 8 N. R. 5 E.

Scale 4 chains=1 inch.

Elder Creek S.D.

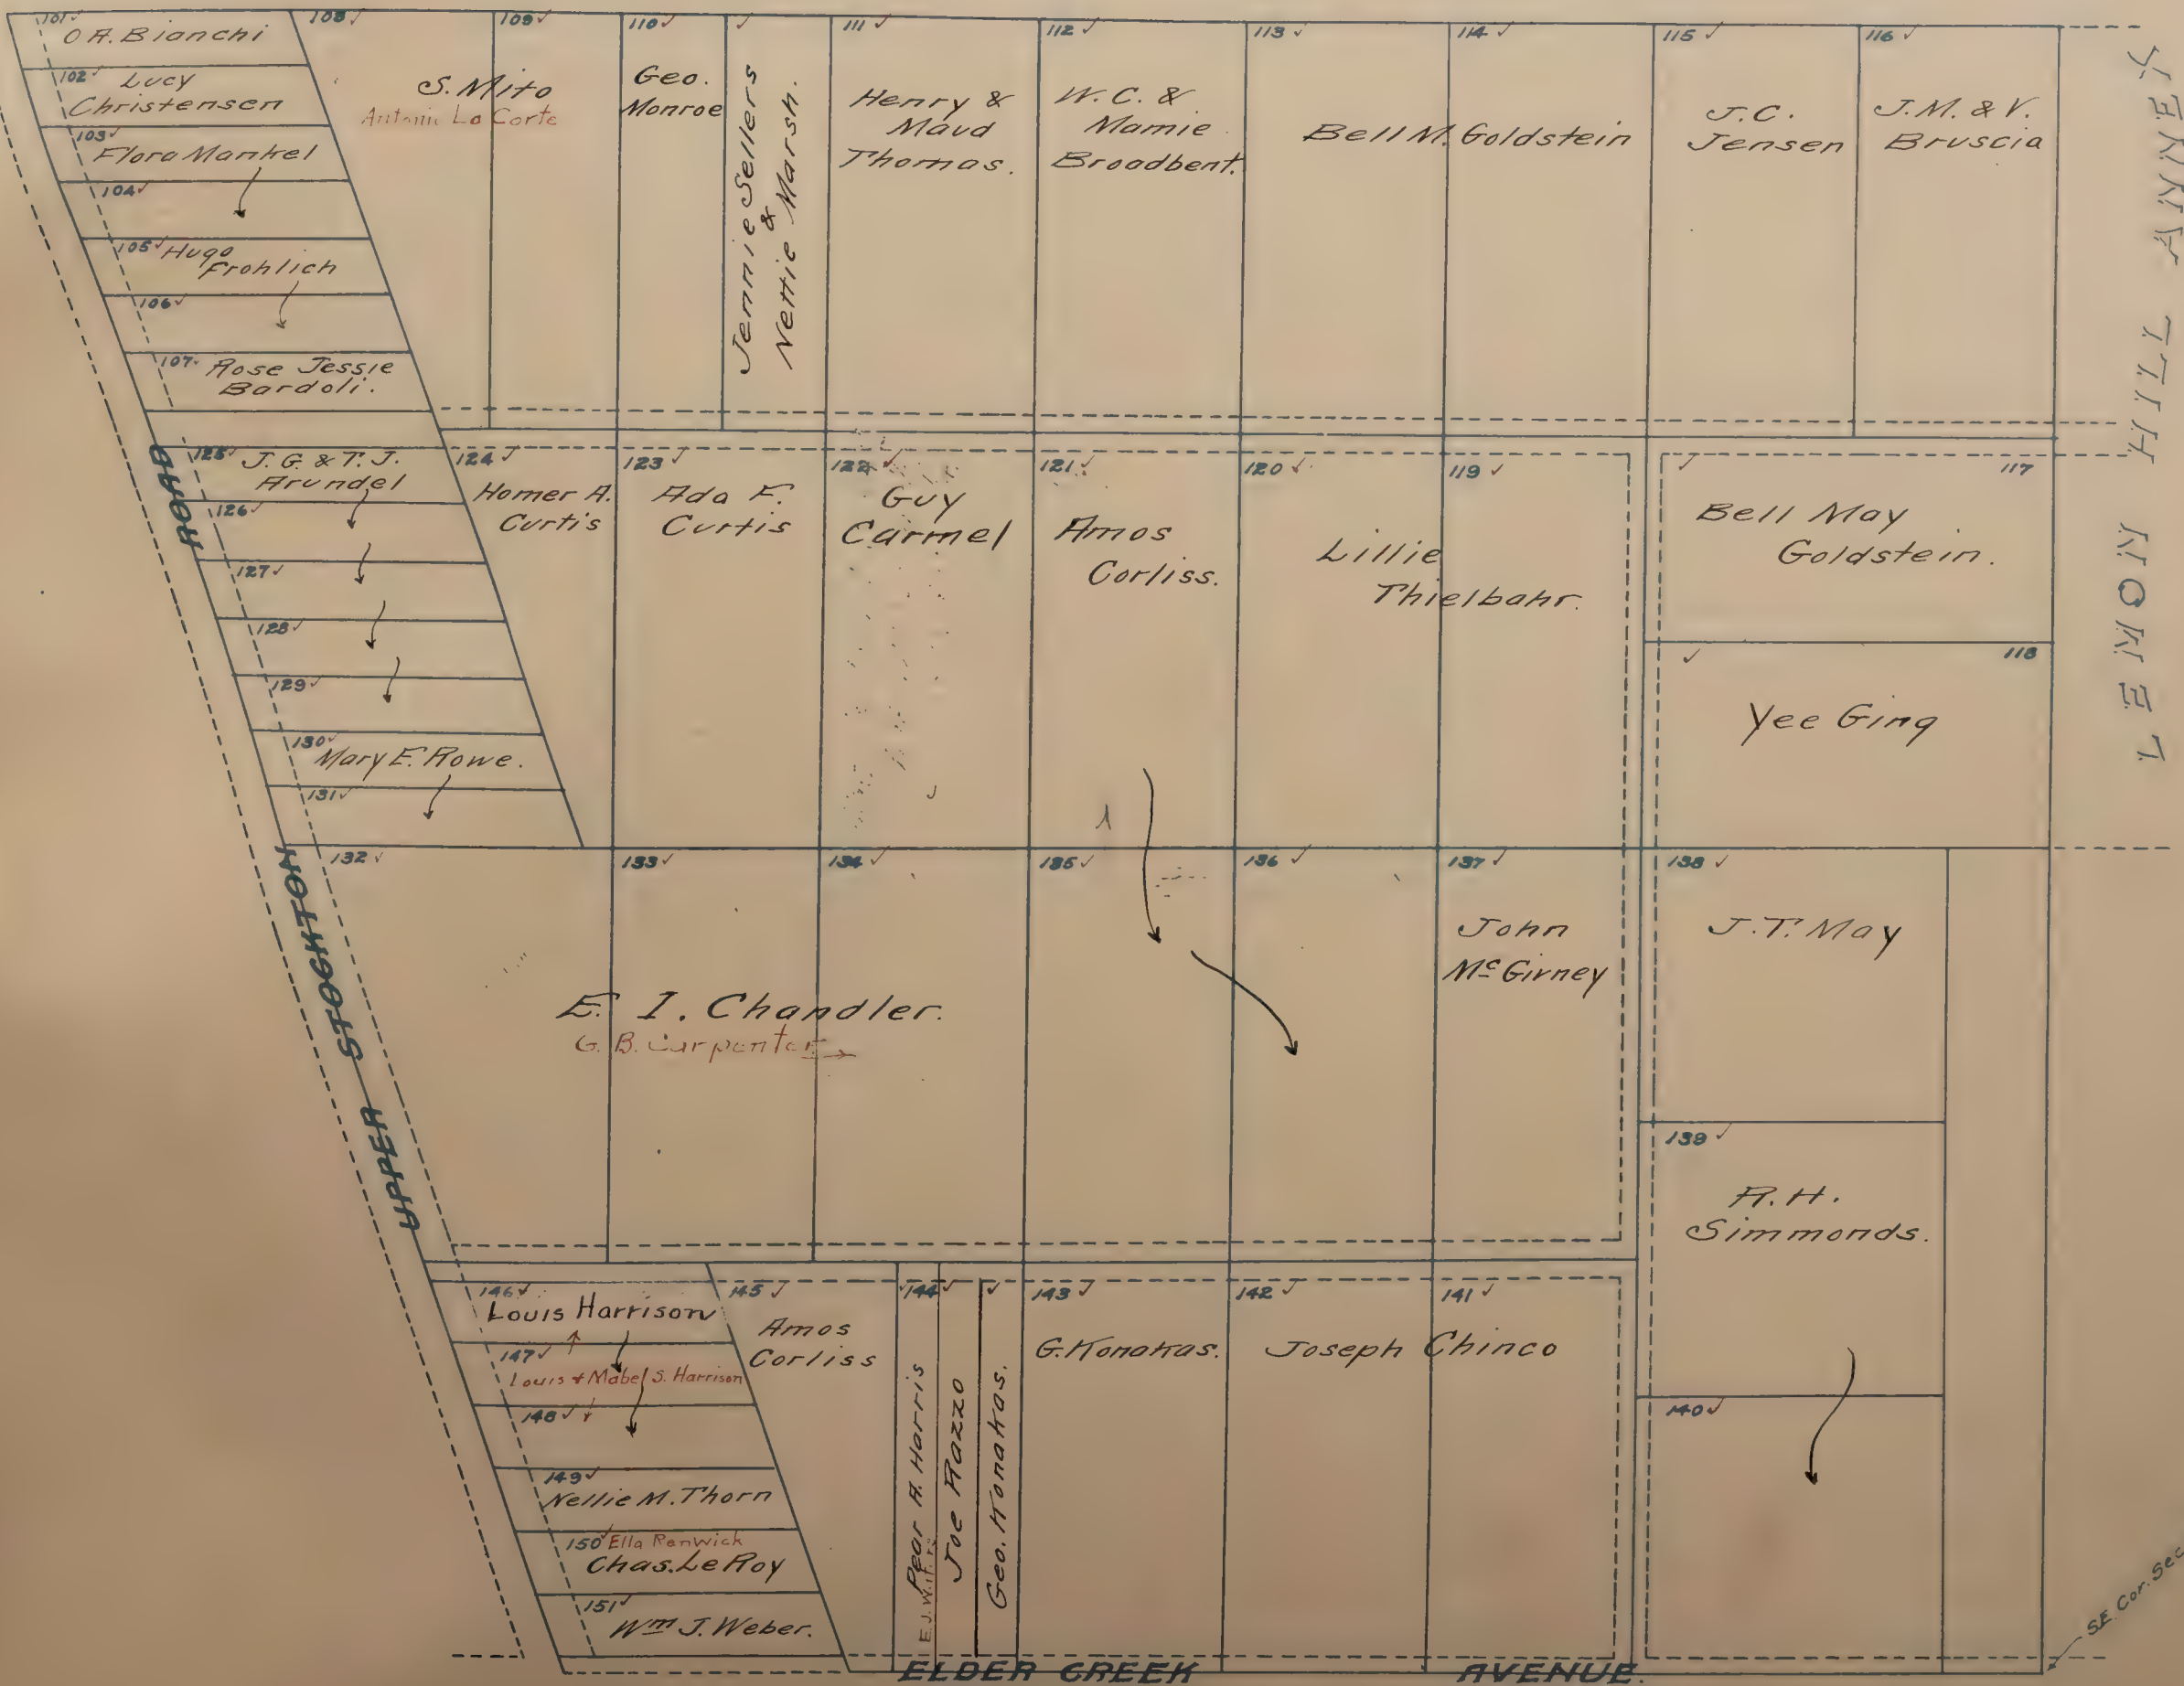

LE MORRIS SQUARE ✓
located in
Section 15 RANCHO DEL PASO
Scale: 1"=40'

NORTH SACRAMENTO S. D.

Blanks to John J. Mahan.

EL CAMINO

AVE

1✓	2✓	3✓	4✓	5✓

Alley

6✓	15✓
7✓	14✓
8✓	13✓
9✓	12✓
10✓	11✓

AVE

OLIVE

16✓
17✓
18✓
19✓
20✓
21✓
22✓
23✓

15

17th

L.M. LINCOLN EST.

located in
Sections 14-23 T.8N.R.4E.
Scale 1"=200 ft.

Sutter SD.

Checked in Sec. 14 & 23. - 8-4.

17.13 Acs.

Estate
17.13 Acs.

L.M. Lincoln
17.13 Acs.


E.R. Edwards
130.2 Acs.


LINDA VISTA SUBDN. NO. 1

located in
Sub 2, 3 & 8 North Sacramento
Rancho Del Paso
Scale 1"=100'

Aracade S.D.

SUB. NO. 3
BLOCK 8

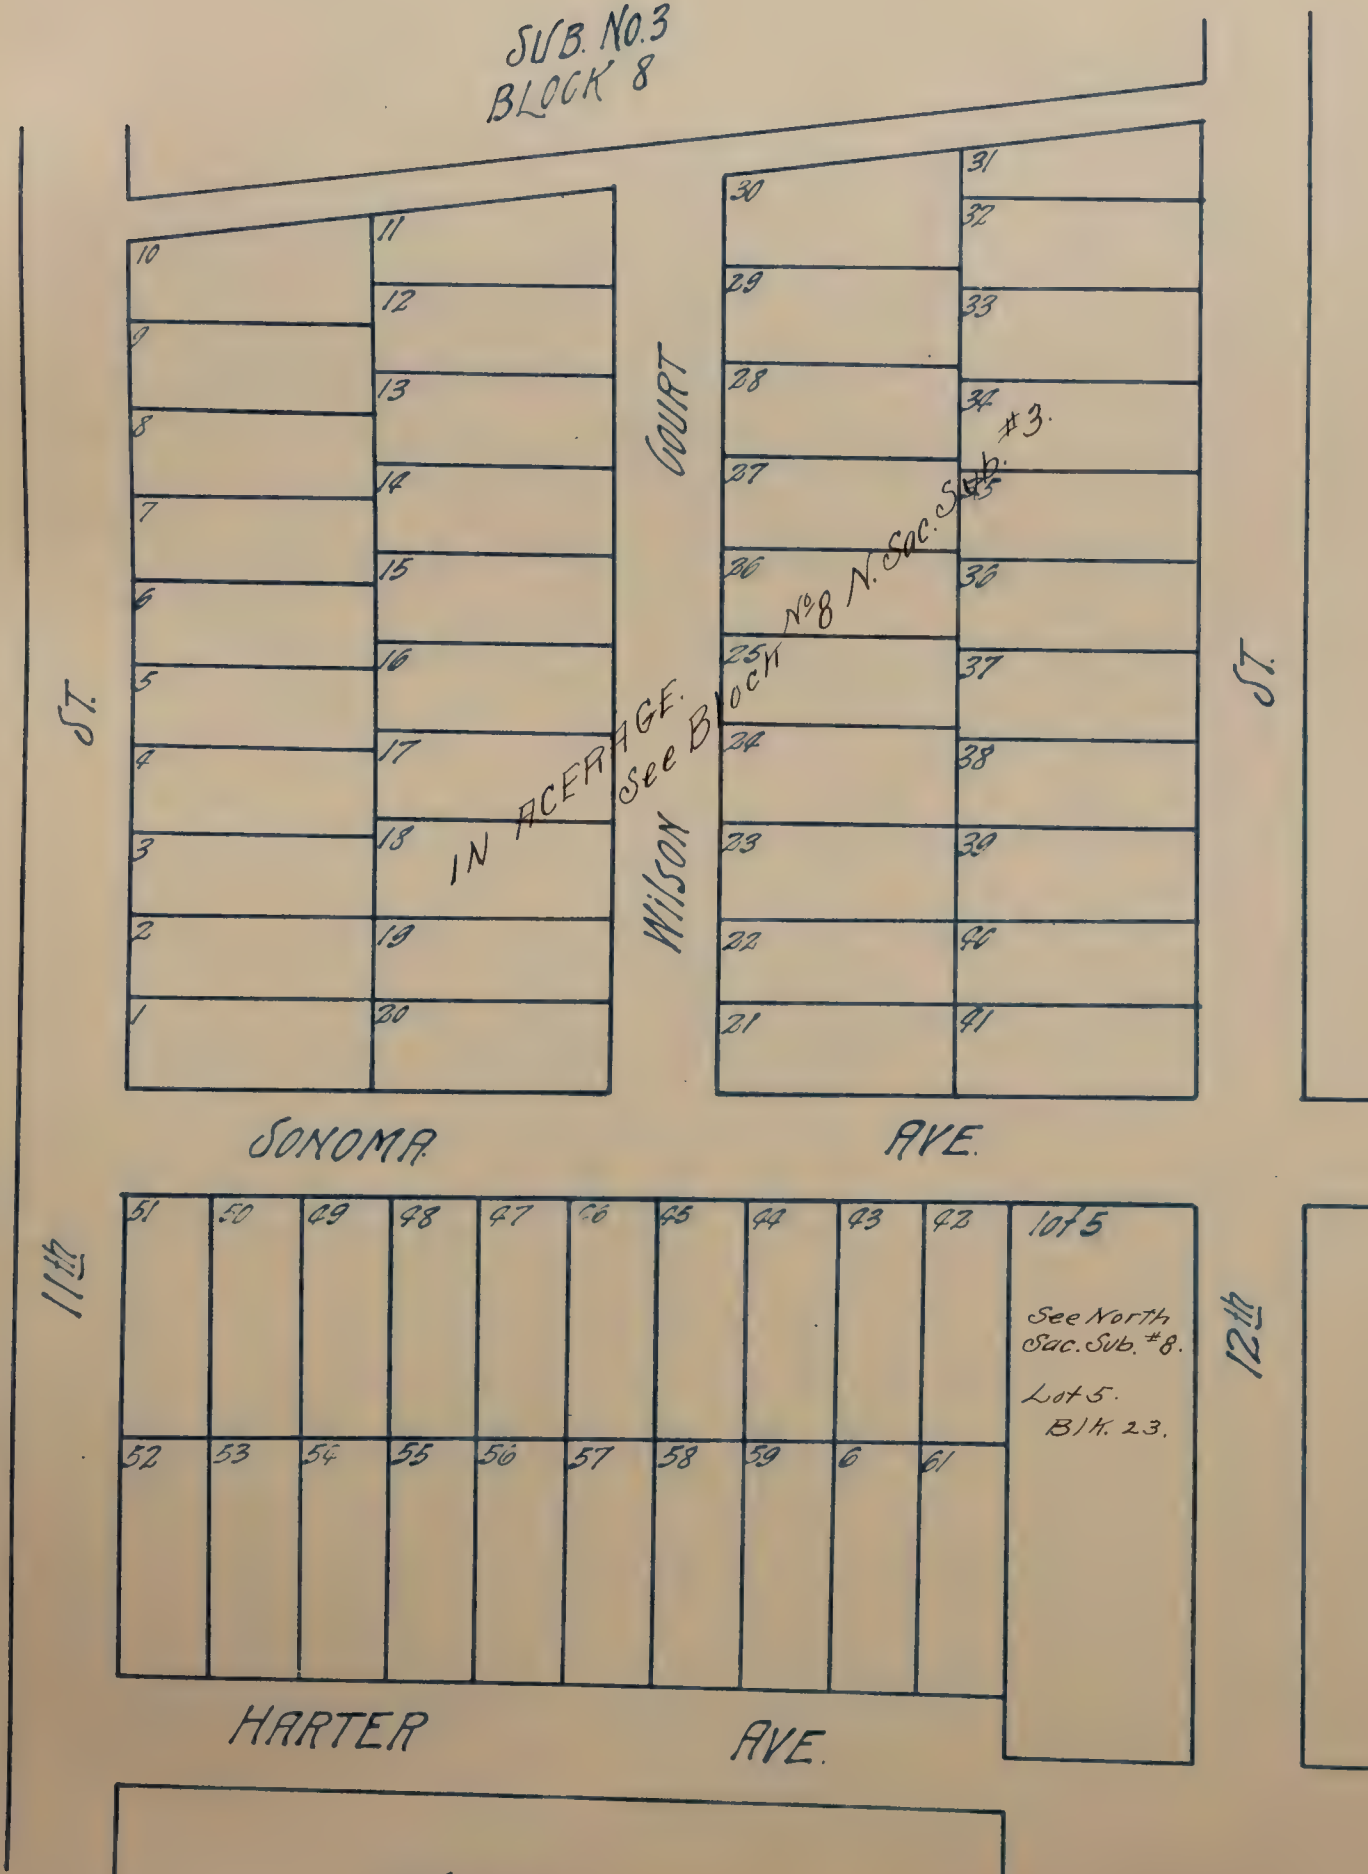

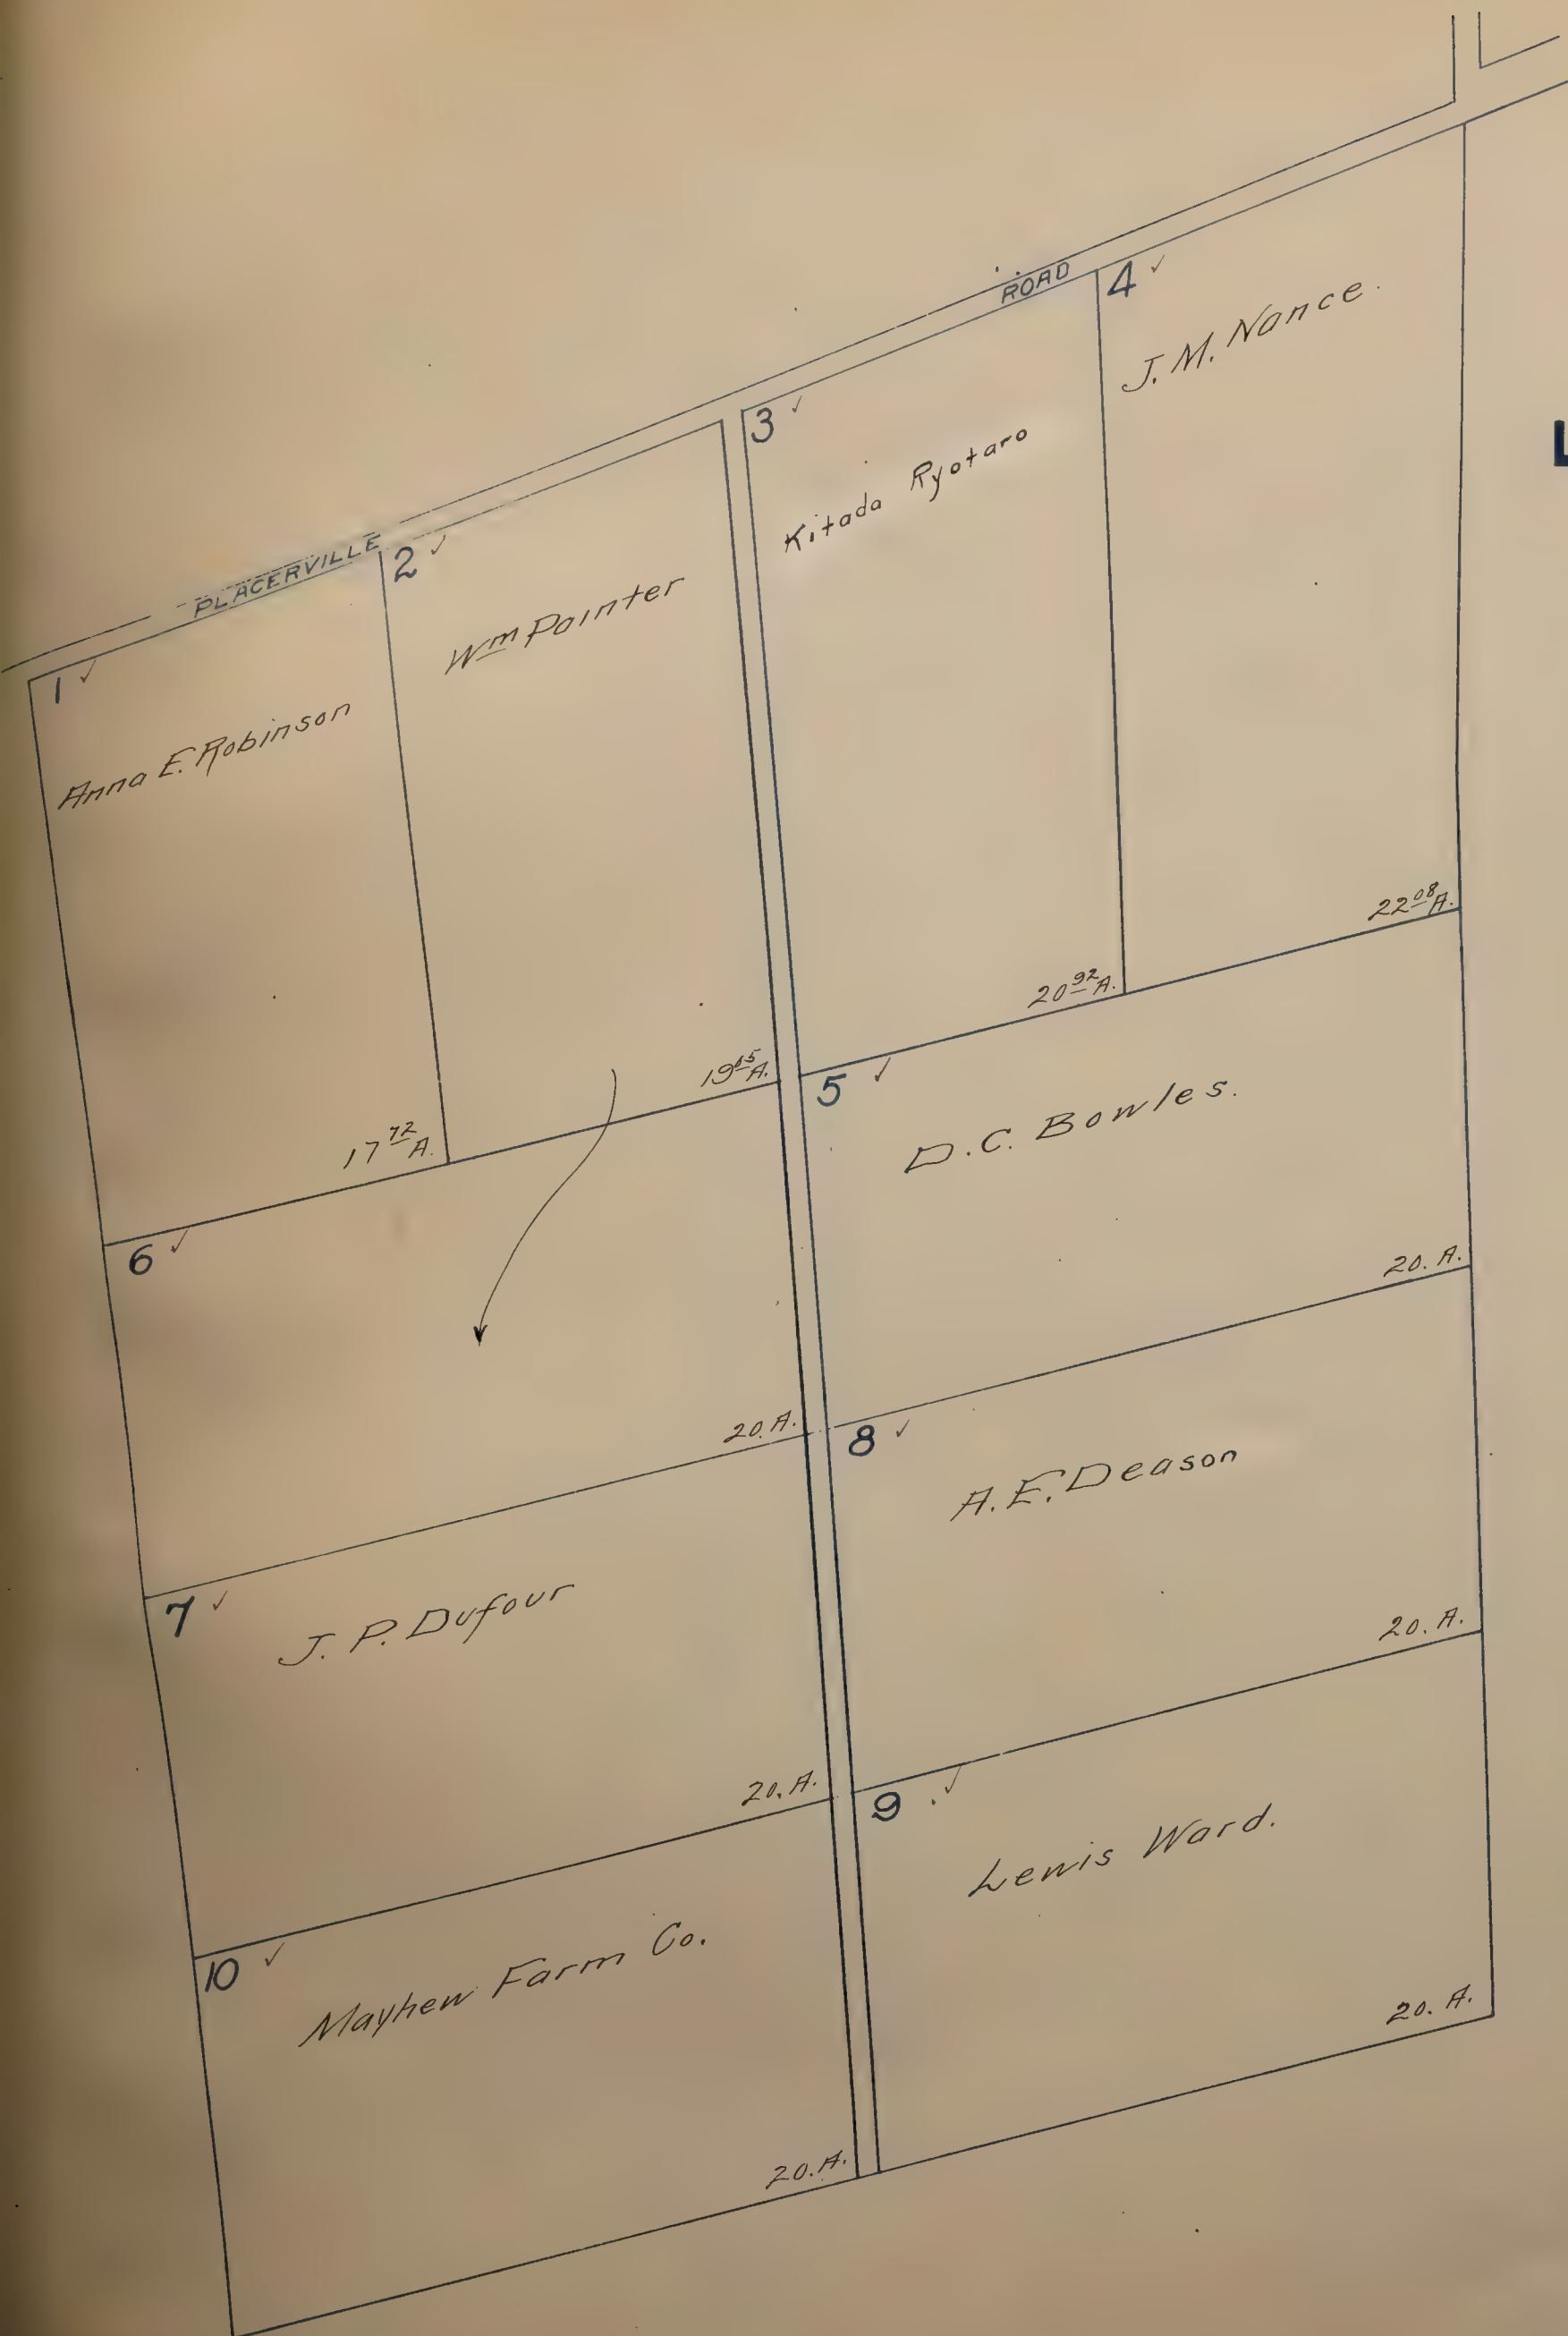

LOS AMERICANOS ACRES ✓

LOCATED IN
Rancho Rio De Los Americanos
Scale 300' = 1" — Kinney S.D.


Edw. Kelly S.D.
~~BRIGHTON S.D.~~

LOUISIANA & GOULD TRACTS

IN SECTION 19, T.8 N.R.5 E. ✓

Scale: 1" = 200'

Fruit Ridge, S.D.

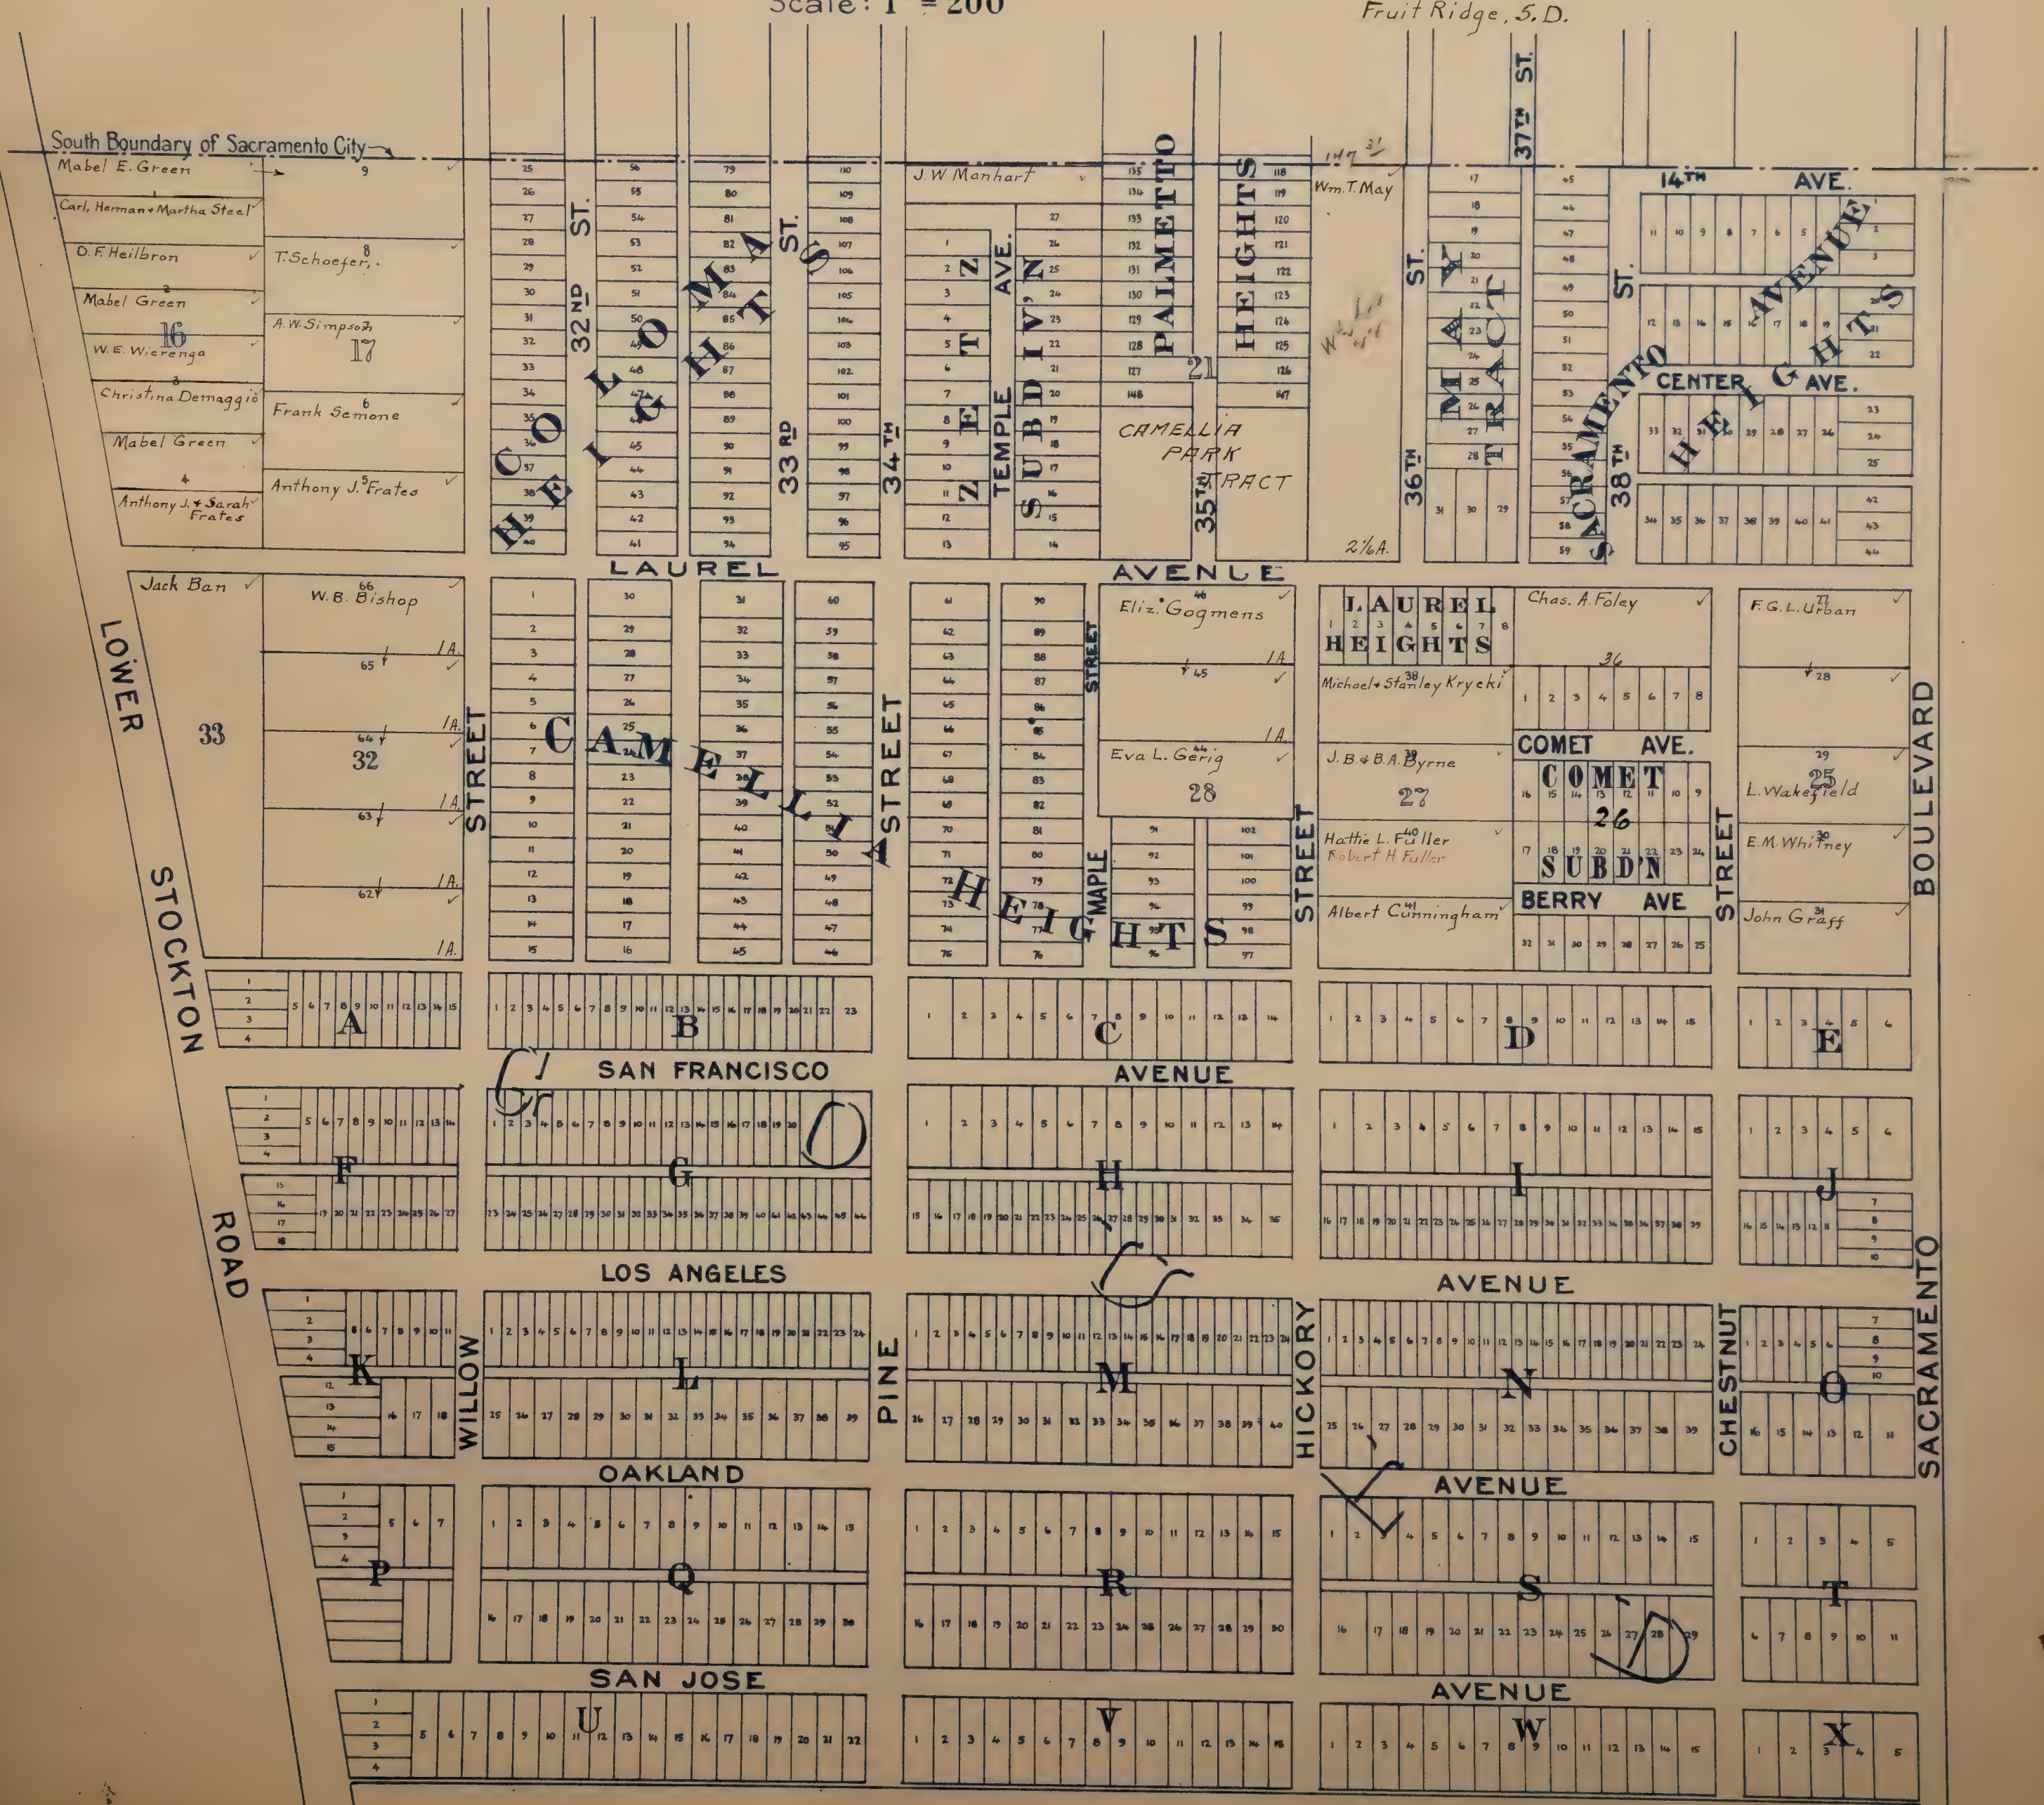

LUCERNE MEADOWS

LOCATED IN
Sec's 22-23 of T.7N.R.5E.
Scale: 1" = 5 Chains

JACKSON S.D.

Blotrs To C.M. Goethe.




Lucerne

MANLOVE ACRES ✓
 located in
 N.E. 1/4 Section 13 T.8 N. R.5 E.
 Scale 1" = 150 ft.
 Washington S.D.

Blanks to Herbert A. Kidder.

All Lots 1 Ac. unless otherwise noted.

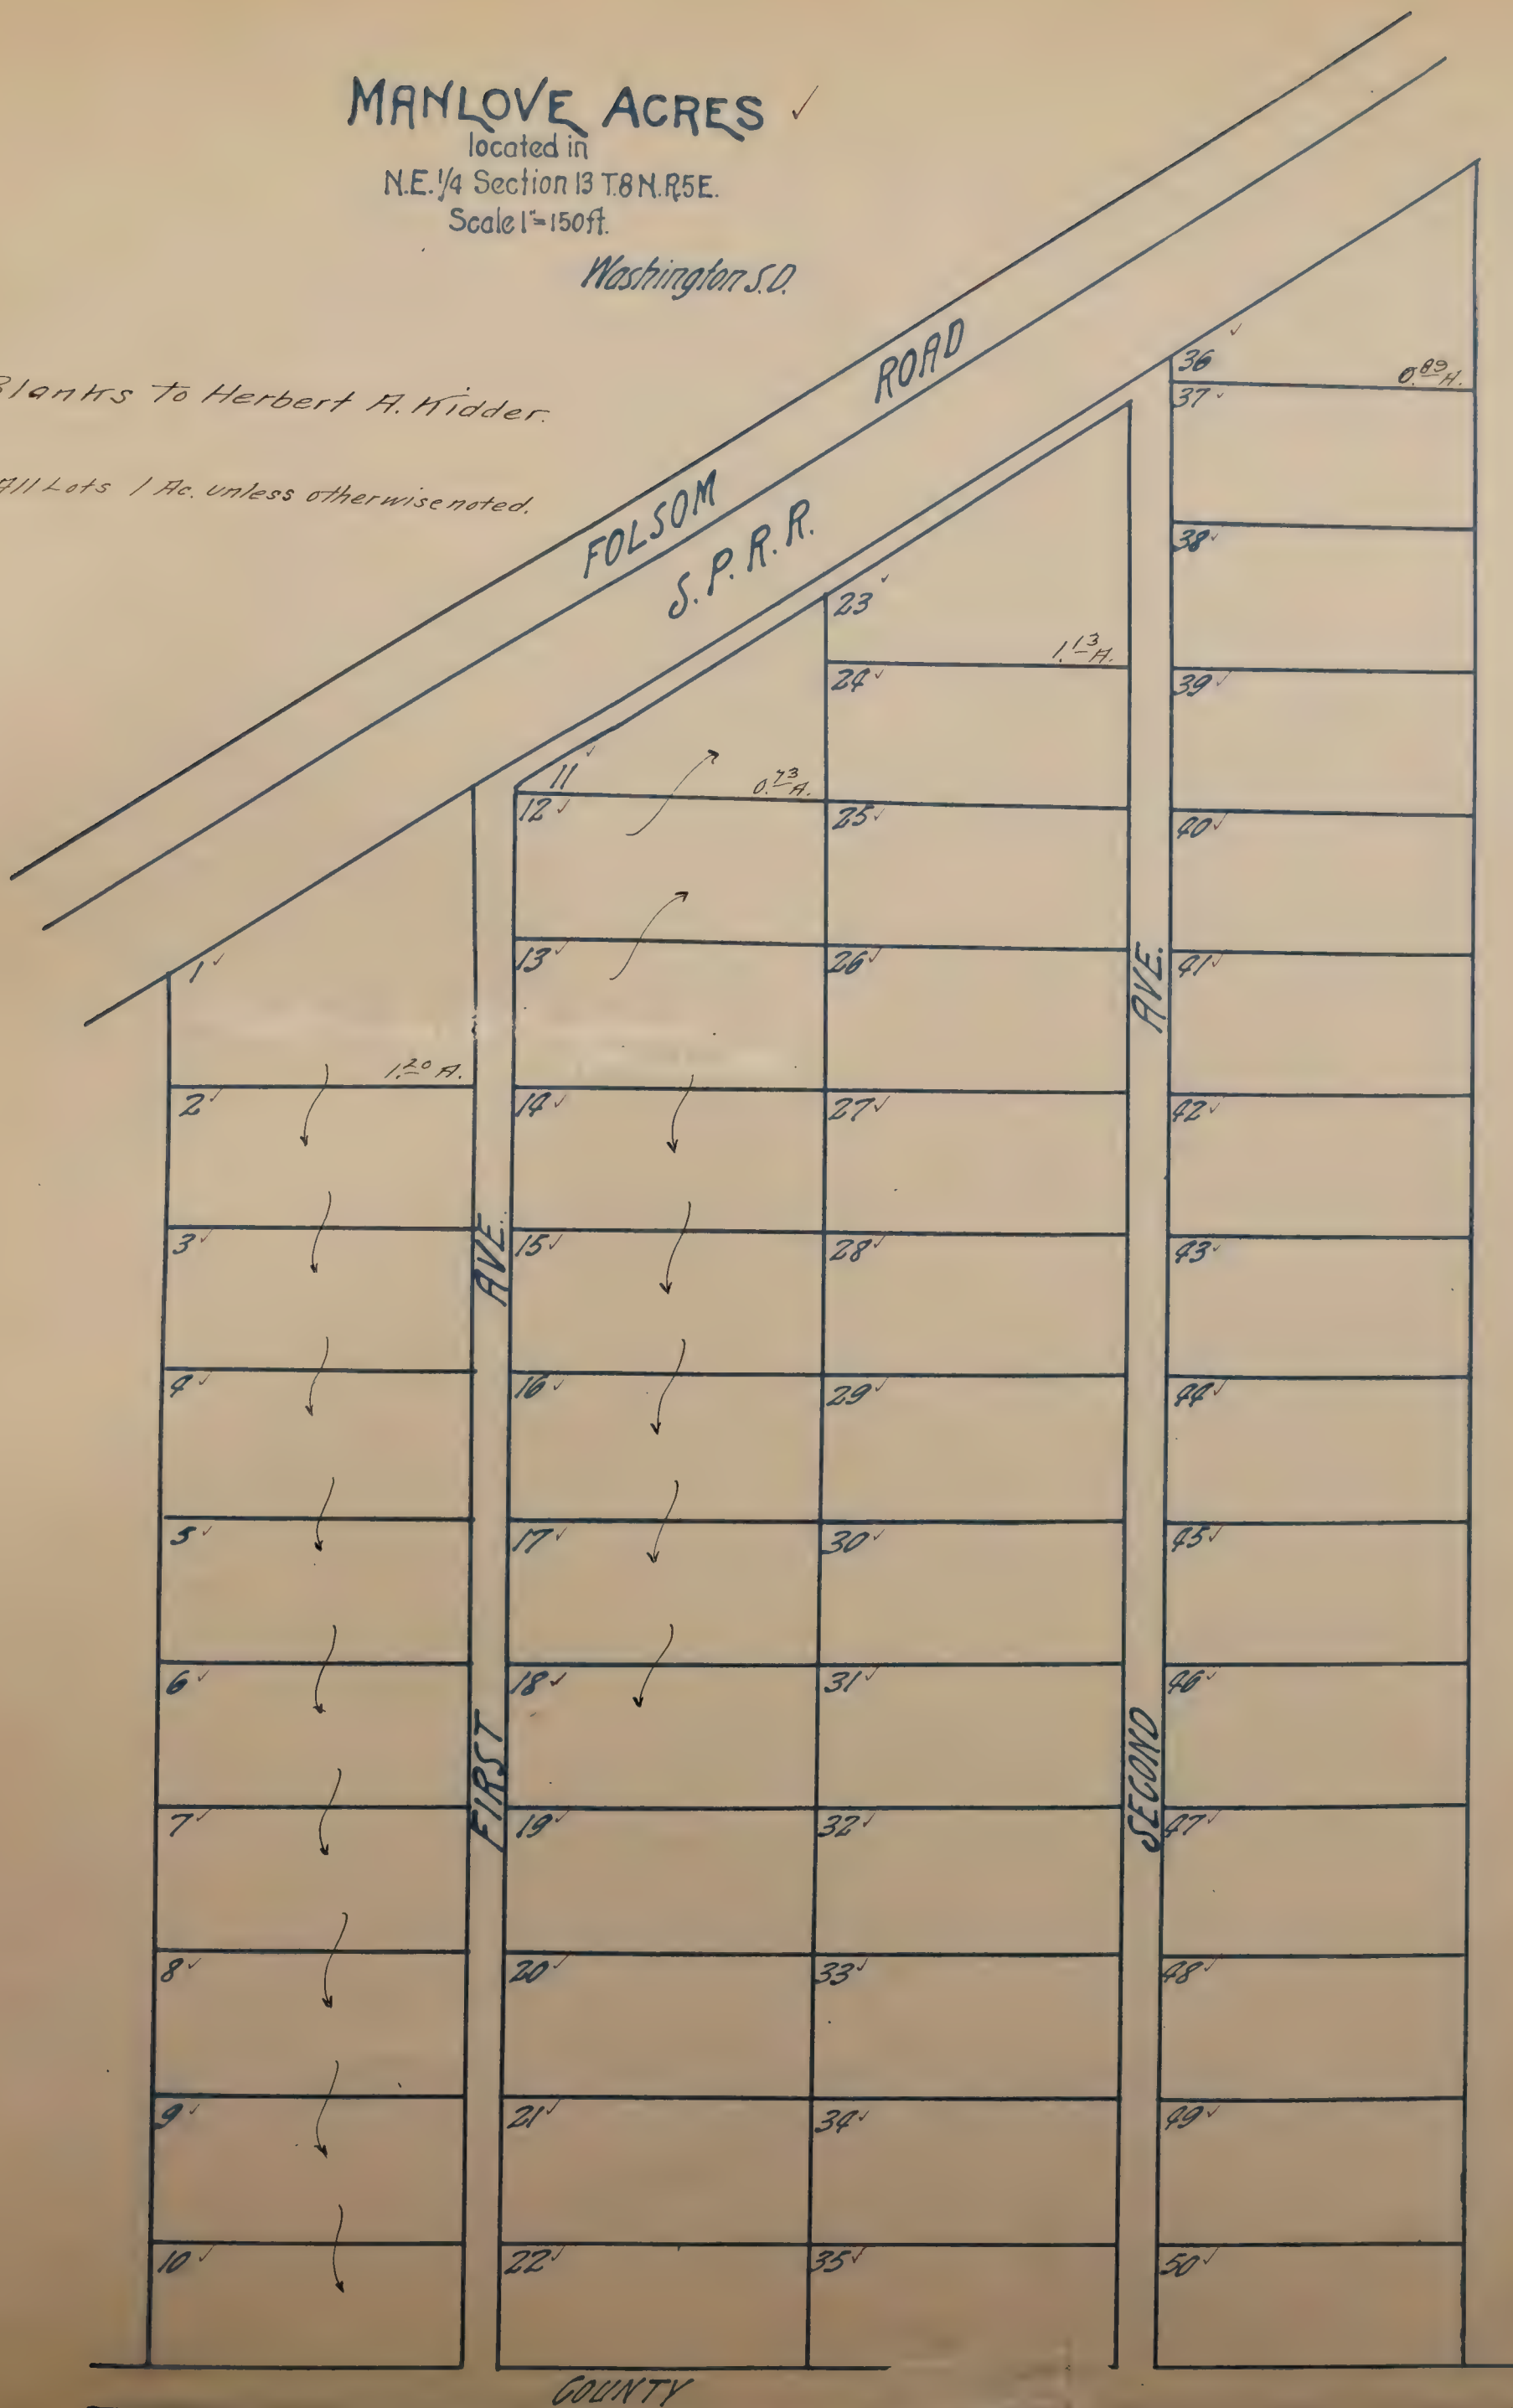


MARYLAND SUBDIVISION ✓

LOCATED IN
Sec. 12 — T. 6 N. R. 6 E.
Scale: 300' = 1"

~~10.45~~ 30

10.45 30
have "

Blanks To W. T. Foster & A. H. Gostick.

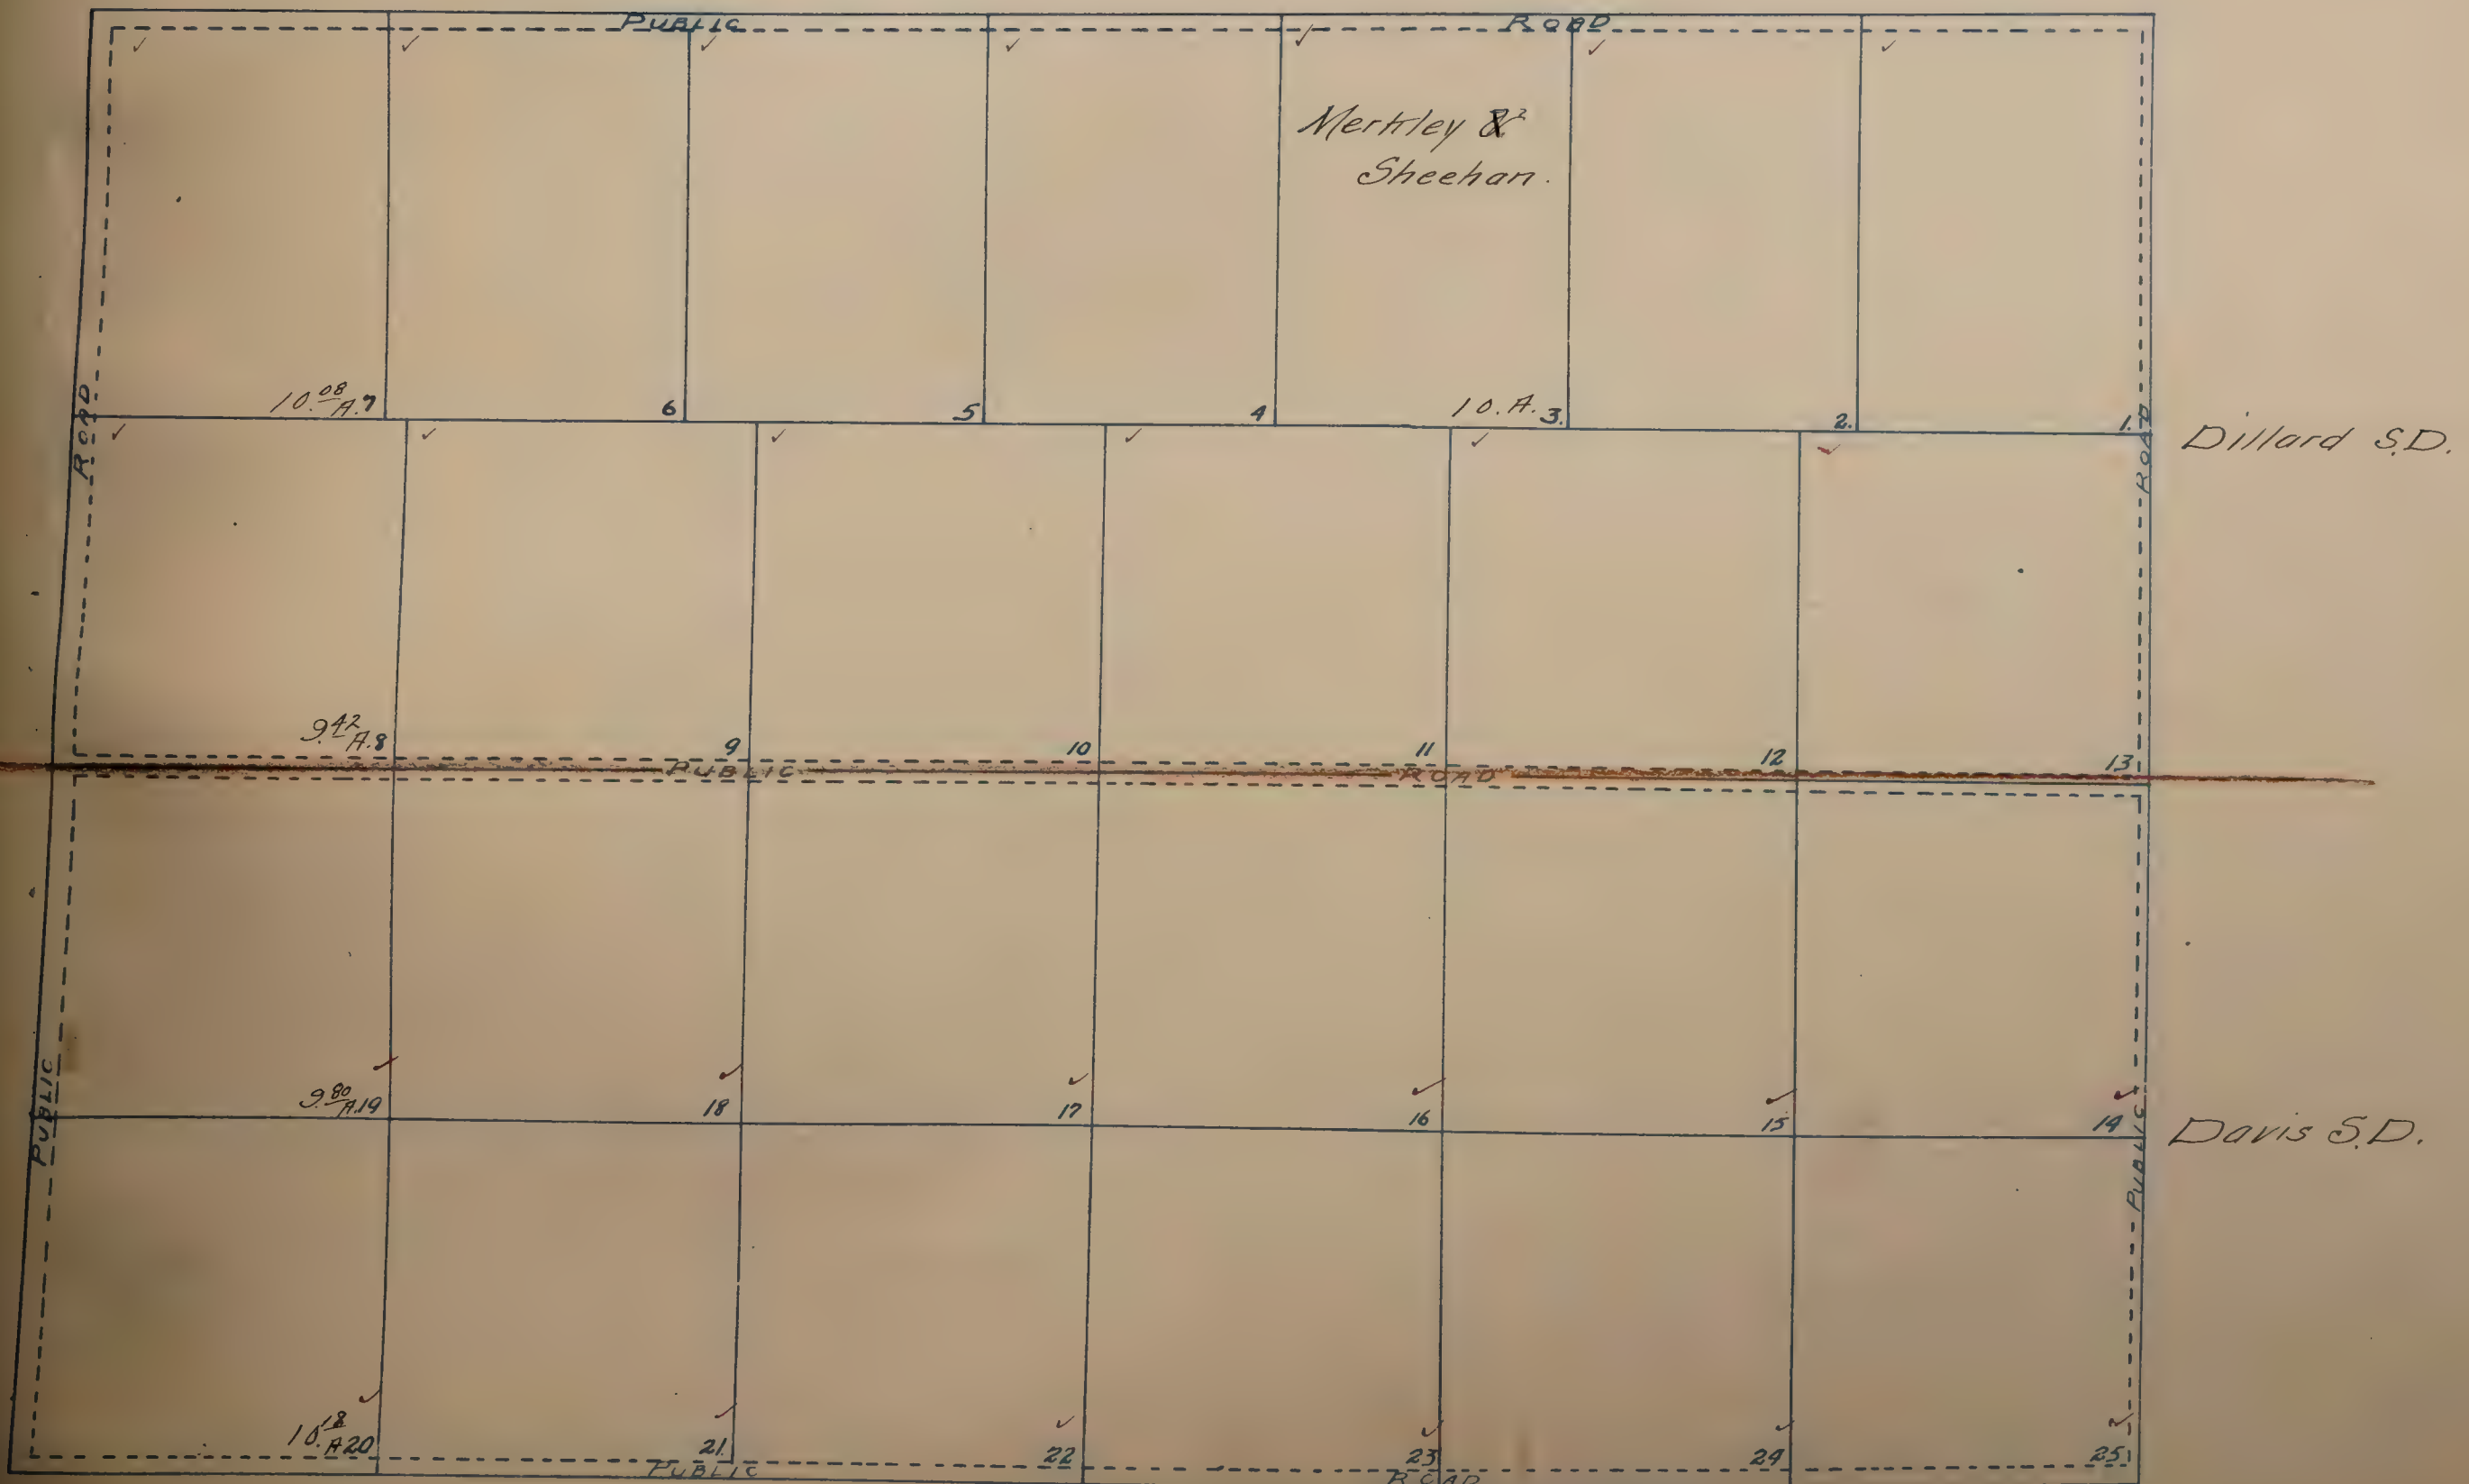

PALMETTO AVE.

AVENUE

PALMERO

AVENUE

FORT WAYNE

MAY TRACT ✓

being part of
Lots 10-22 of Louisiana Tract

Scale: 1"=100'

Blanks To W.T. Moy.

City

Limits

Fruitridge S.D.

Annie Johnson

Wm R. Frazier

MEAD TRACT


LOCATED IN

N $\frac{1}{2}$ of S.W. $\frac{1}{4}$ of Sec. 24, T. 8 N., R. 5 E.

Scale: 120' = 1"

Blanks To Frank Mead.

Freemont S.D.

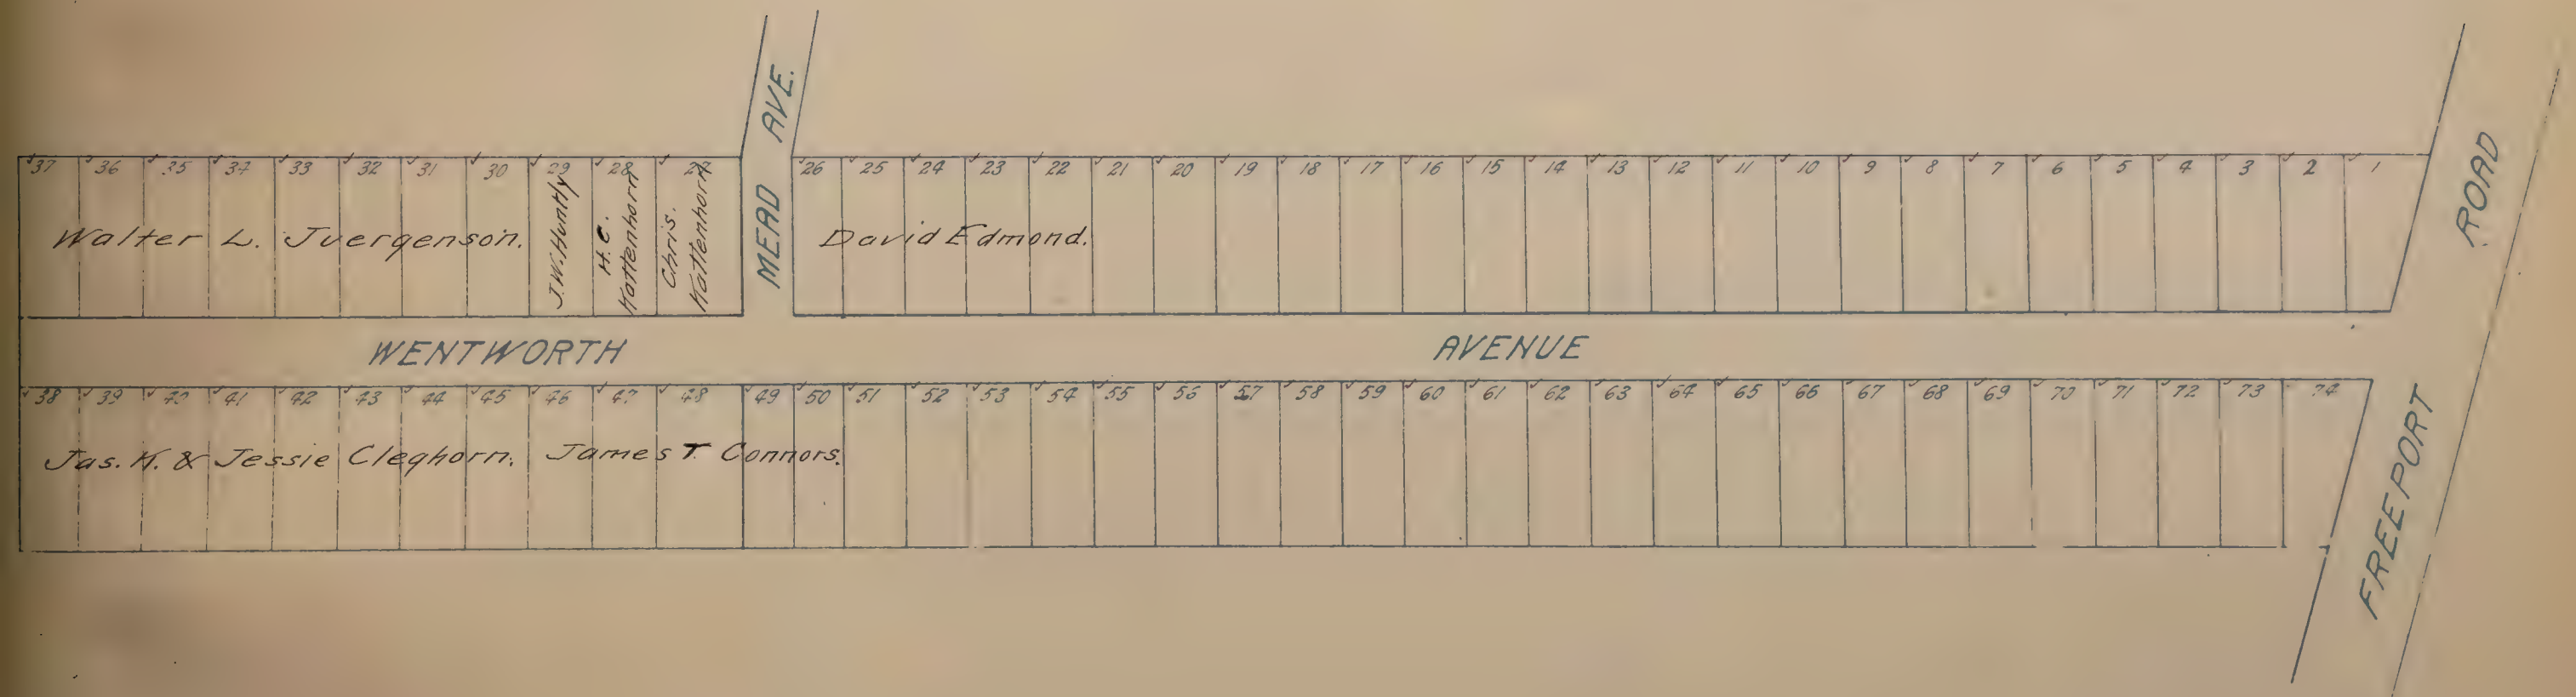

MEAD SUBD. N^o 2 ✓


LOCATED IN
N.W. 1/4 of Sec. 24, T. 8 N. R. 5 E.

Scale: 1" = 80'

Freemont, S. D.

Blanks to Frank Mead.


Blanks to H W Reynolds

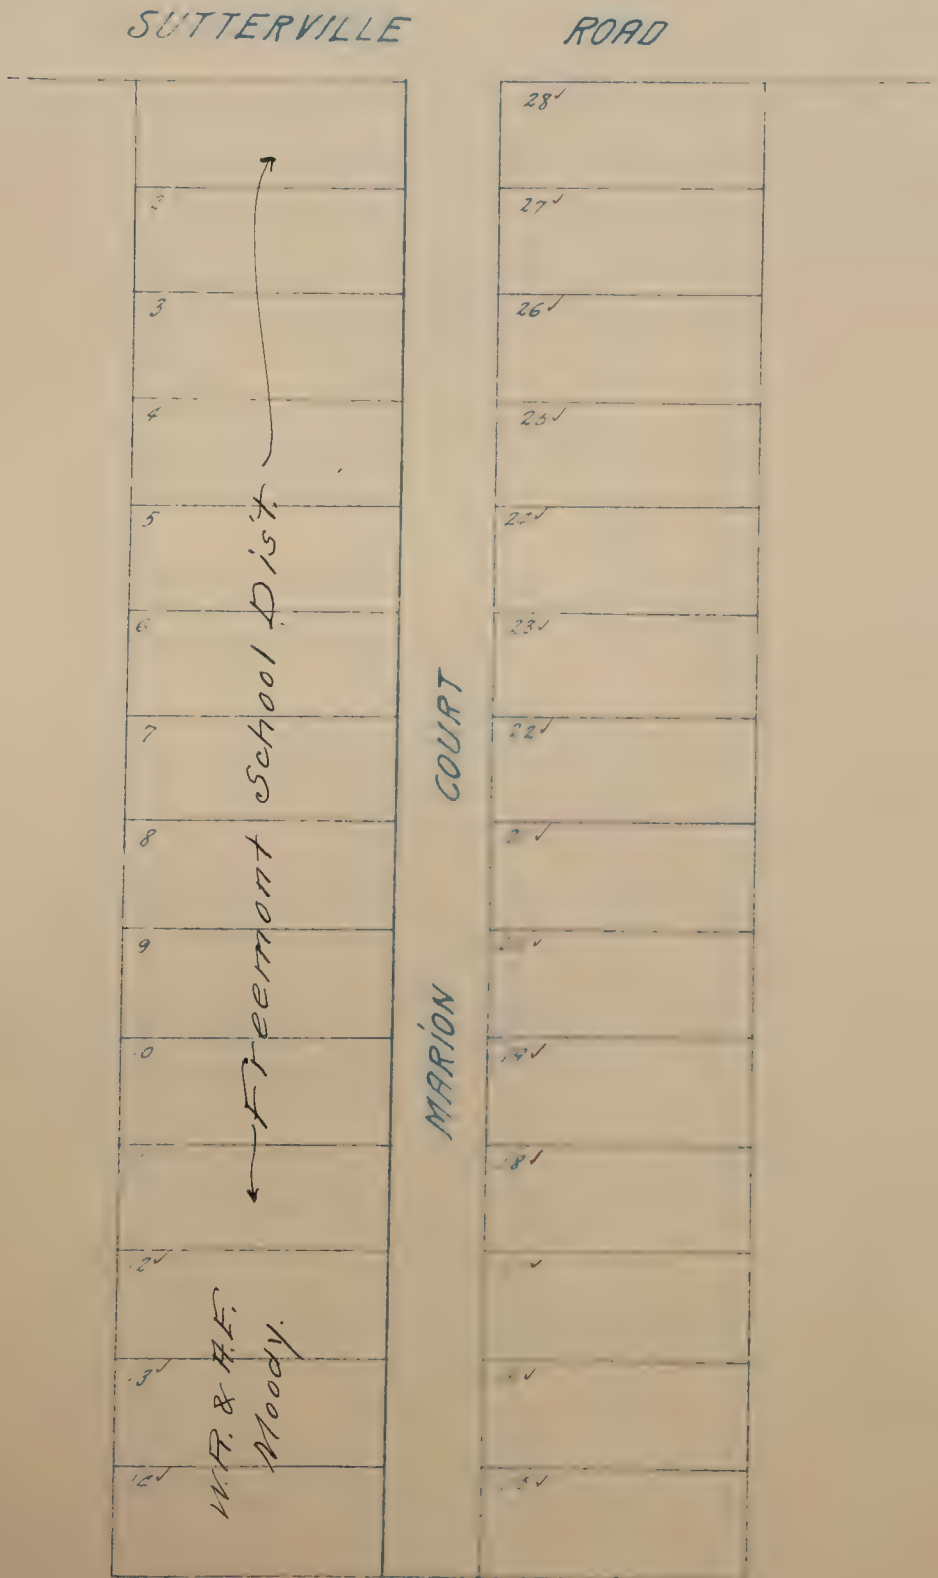

MEADOW VIEW COLONY ✓

LOCATED IN
Sec's 5, 6, 7 & 8 T. 7 N. R. 5 E.
Scale: 100' = 1"


Prairie SD.

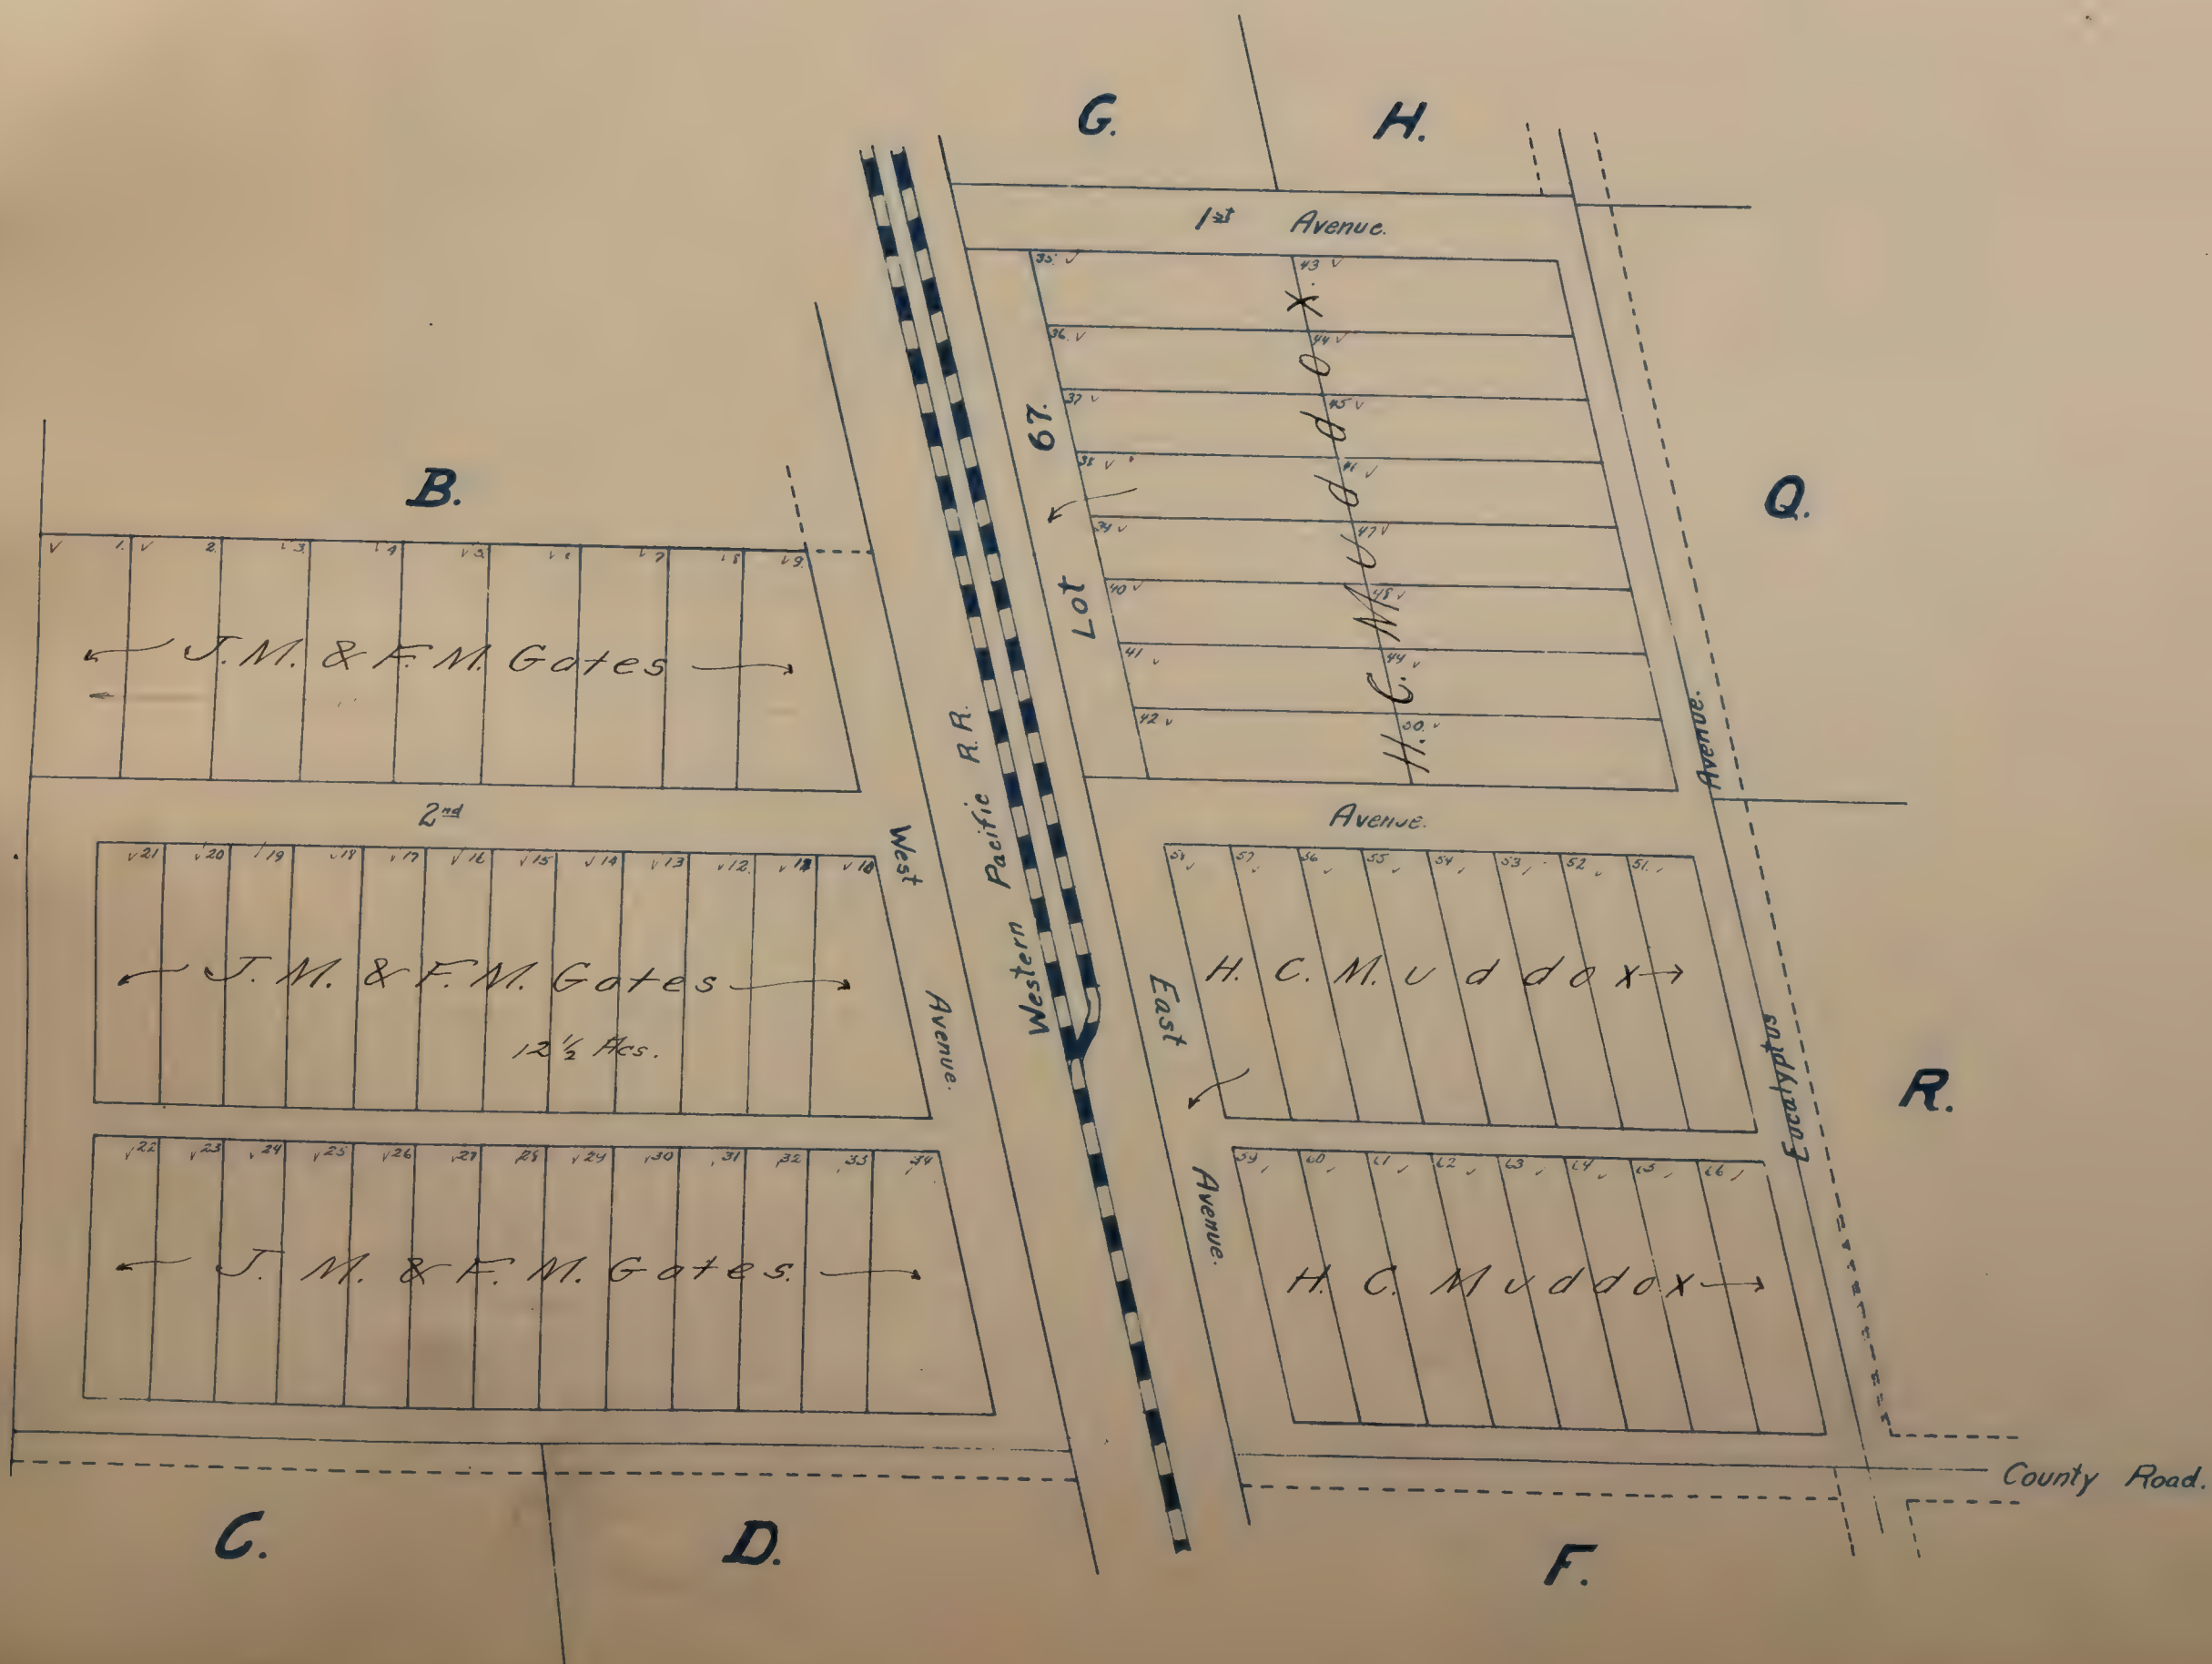

MEADOW VIEW COLONY ✓

LOCATED IN
Sec's 56 7 & 8 T. 7 N. R. 5 E.
Scale 100' = 1"

Prairie S.D.

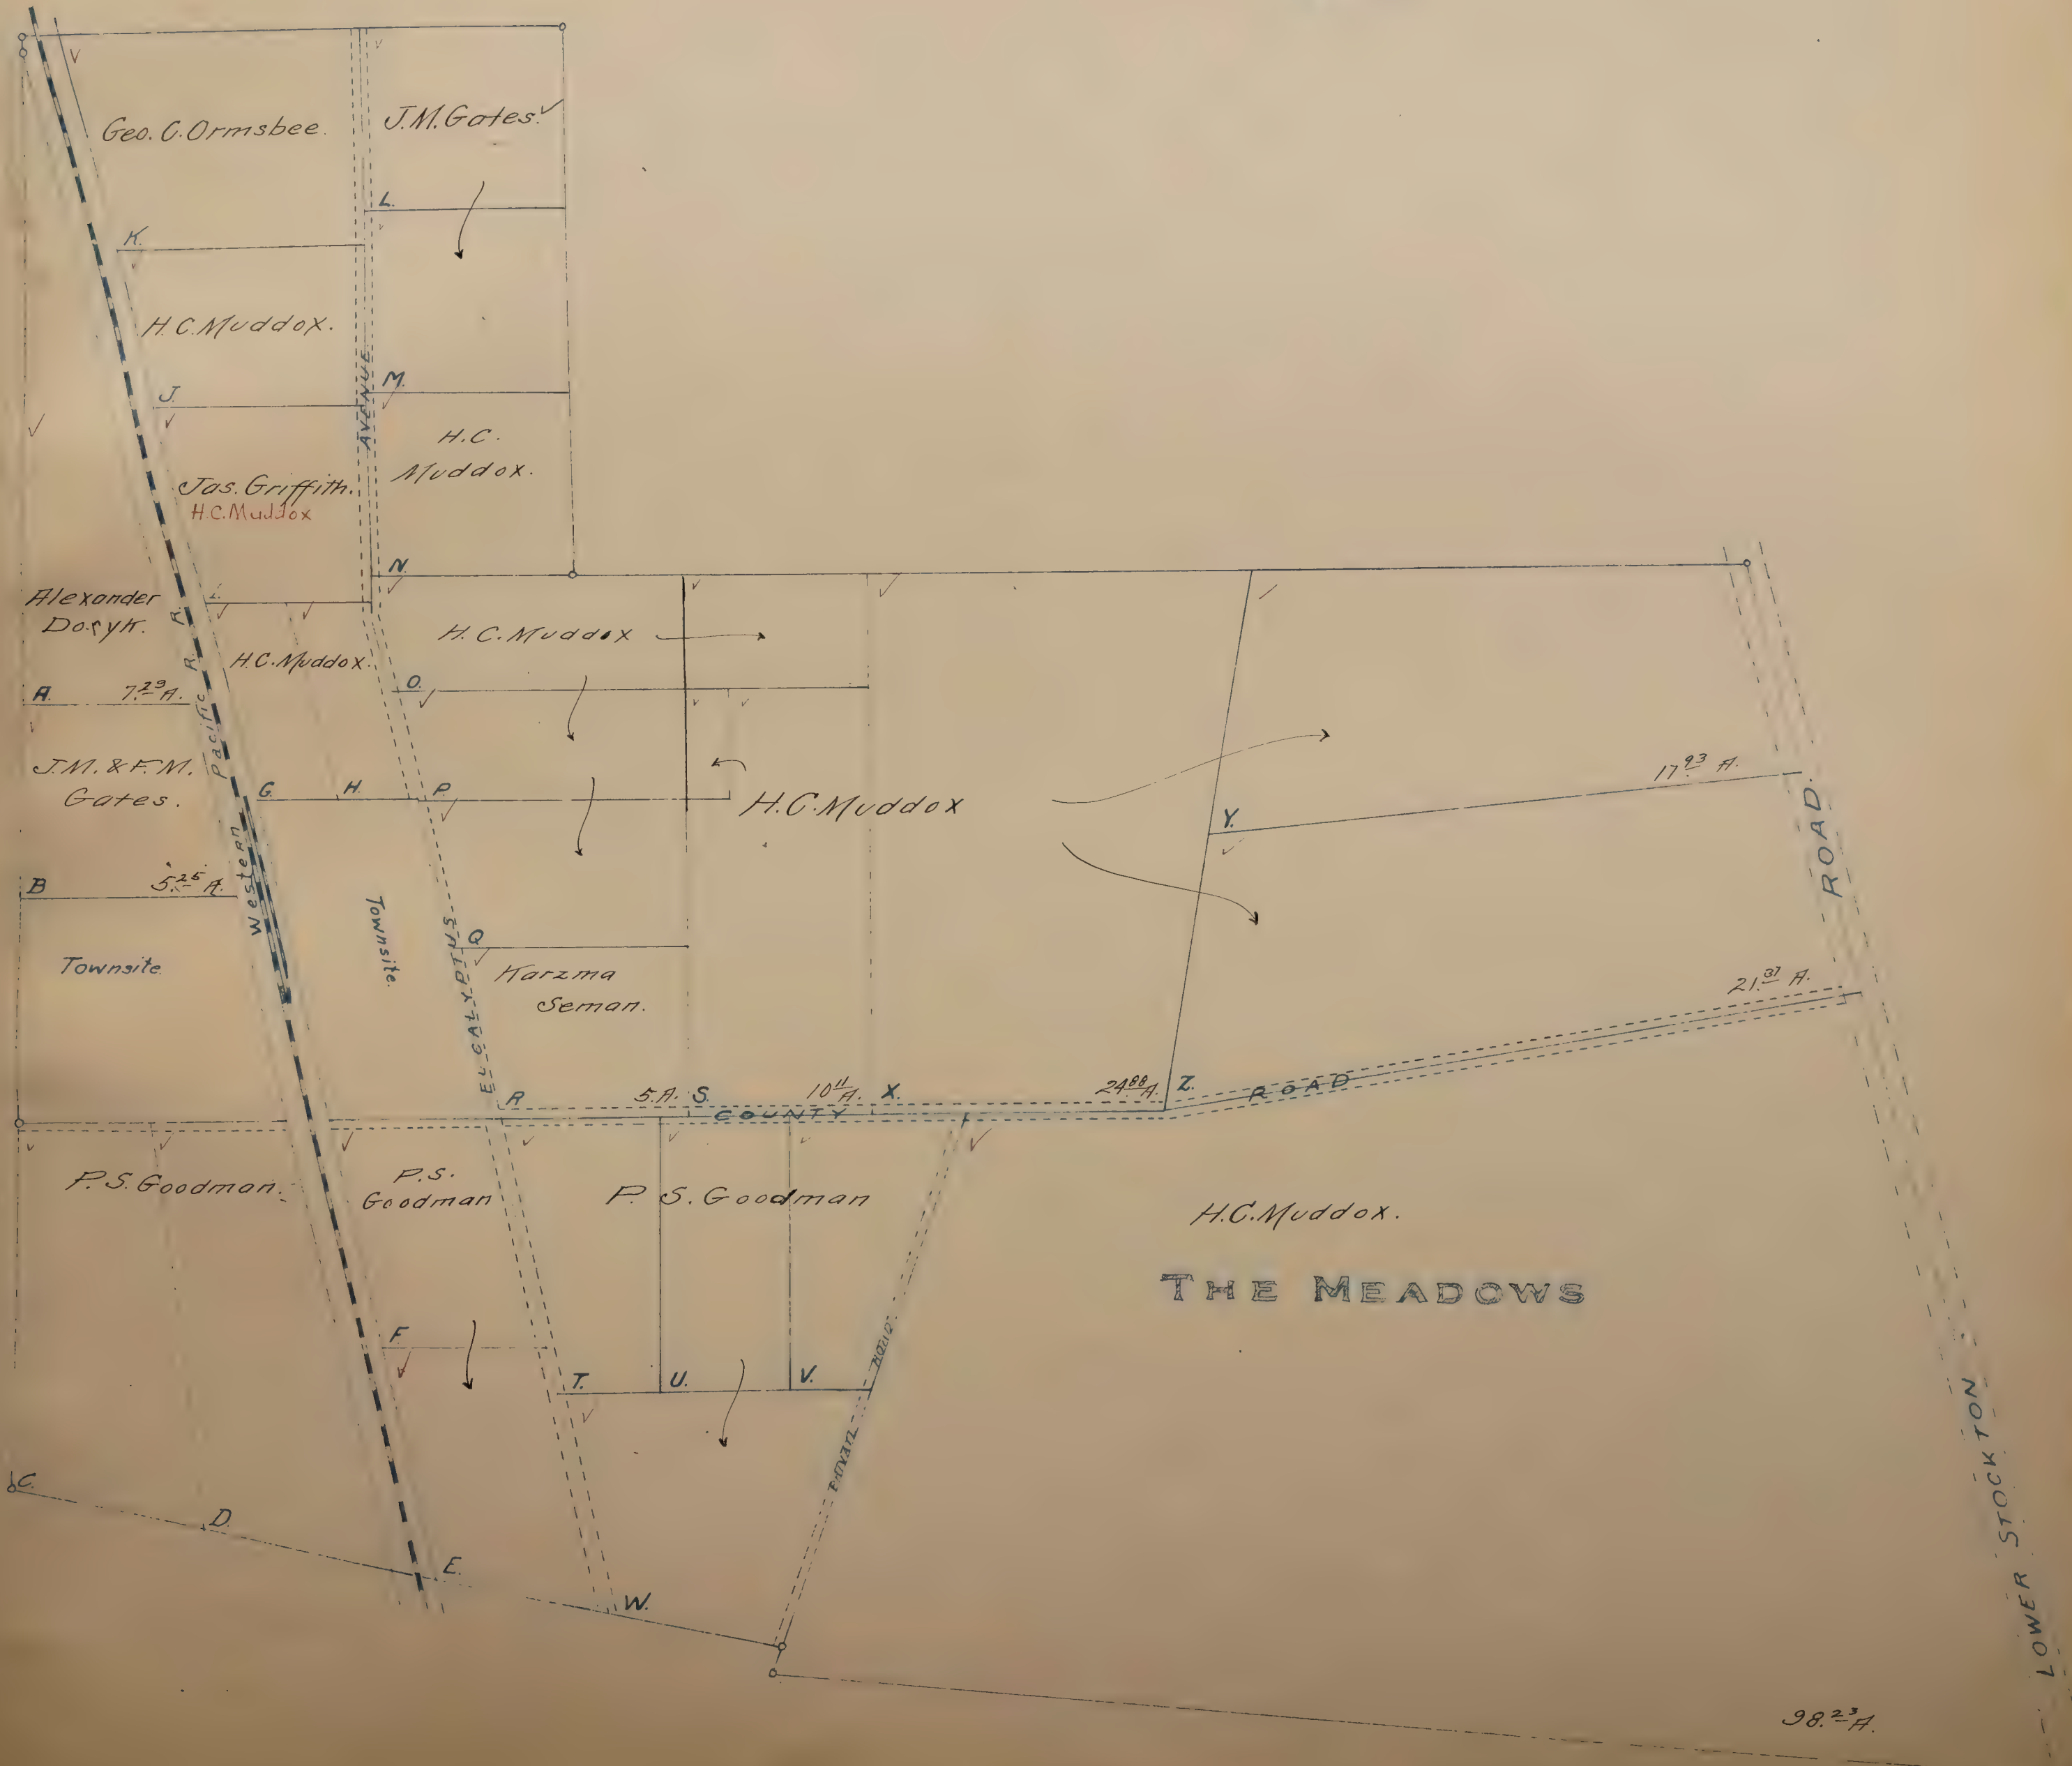

MIRA VISTA ✓

LOCATED IN

N.W. 1/4 Section 15, T. 8 N. R. 5 E. Lots 2 and 3 Davis Tract.

Scale: 1" = 60'

Blanks To S. I. Lee.

Junction S.D.

23 ^v	22 ^v	21 ^v	20 ^v	19 ^v	18 ^v	17 ^v	16 ^v	15 ^v	14 ^v	13 ^v	12 ^v	11 ^v	10 ^v	9 ^v	8 ^v	7 ^v	6 ^v	1 ^v		
M. Iseri		I. Tsuda →					H. Doi			Jas. H. Donnelly							Henry Schmittgen.			
Edith P. McCurdy																	Edith P. McCurdy		Frank H. Schmittgen	

ASPEN

AVENUE

24✓	25✓	26✓	27✓	28✓	29✓	30✓	31✓	32✓	33✓	34✓	35✓	36✓	37✓	38✓	39✓	40✓	41✓
R. Hattori Edith P. McCurdy		J. Tsuchigashi															Jas. H. Donnelly.
																	42✓
																	43✓
																	44✓
																	Jas. H. Donnelly.
																	45✓
67✓	66✓	65✓	64✓	63✓	62✓	61✓	60✓	59✓	58✓	57✓	56✓	55✓	54✓	53✓	52✓	51✓	46✓
M. Yamane Edith P. McCurdy		S. Handa Nippon Bank															Jas. H. Donnelly
																	47✓
																	T. Hattori.
																	48✓
																	49✓
																	50✓
																	Edith P. McCurdy H. Hattori.

MADRONE

AVENUE

68✓	69✓	70✓	71✓	72✓	73✓	74✓	75✓	76✓	77✓	78✓	79✓	80✓	81✓	82✓	83✓	84✓	85✓	86✓
																		T. Hattori.
																		87✓
																		88✓
																		89✓
																		90✓

REDDING

AVENUE

BRIGHTON TOWNSITE


MOULTON TRACT ✓

LOCATED IN THE
N.E. ¼ of Sec. 36, T. 8 N., R. 4 E.

Scale: 3 Chs. = 1"

Pacific S.D.

Blanks to D. H. Moulton.

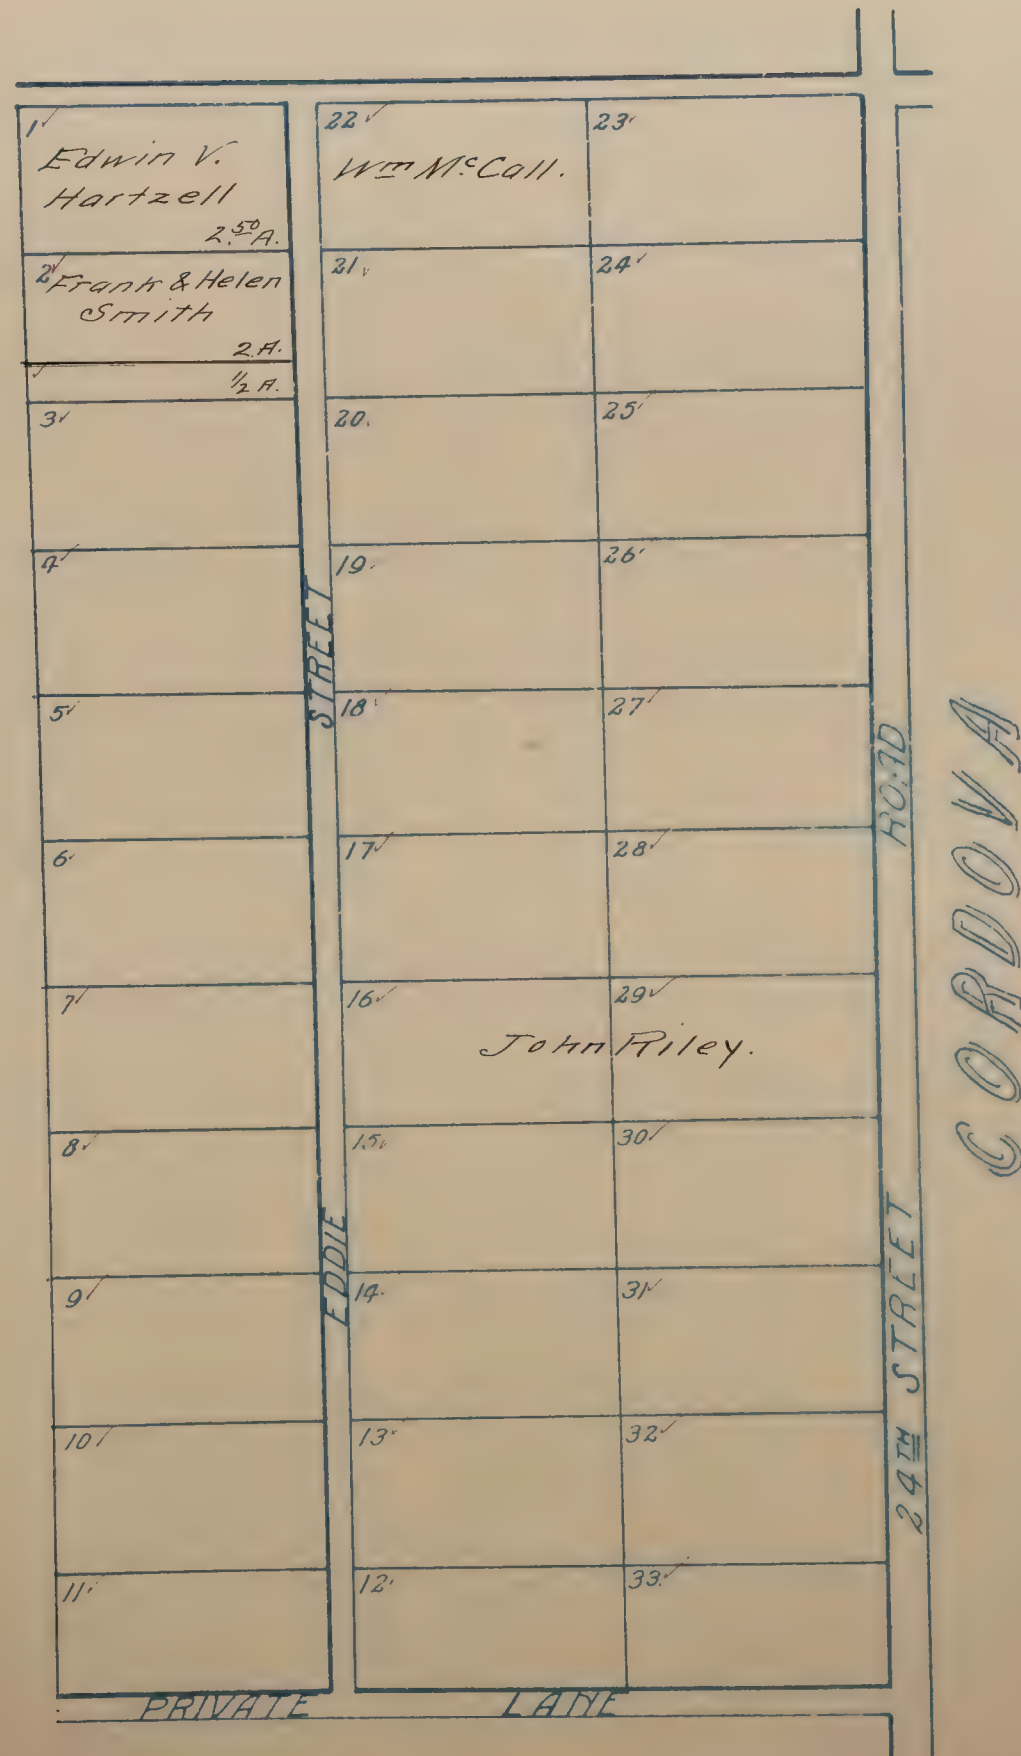

MCCARTY'S EAST SACRAMENTO ✓ FIVE ACRE TRACTS


BEING

THE SW 1/4 OF THE SW 1/4 OF SEC. 14 - T8N R5E. M.D.B. & M.

SCALE: 1 IN. = 200 FT.

Washington S. D.

All blanks to H.E.M. Corty.

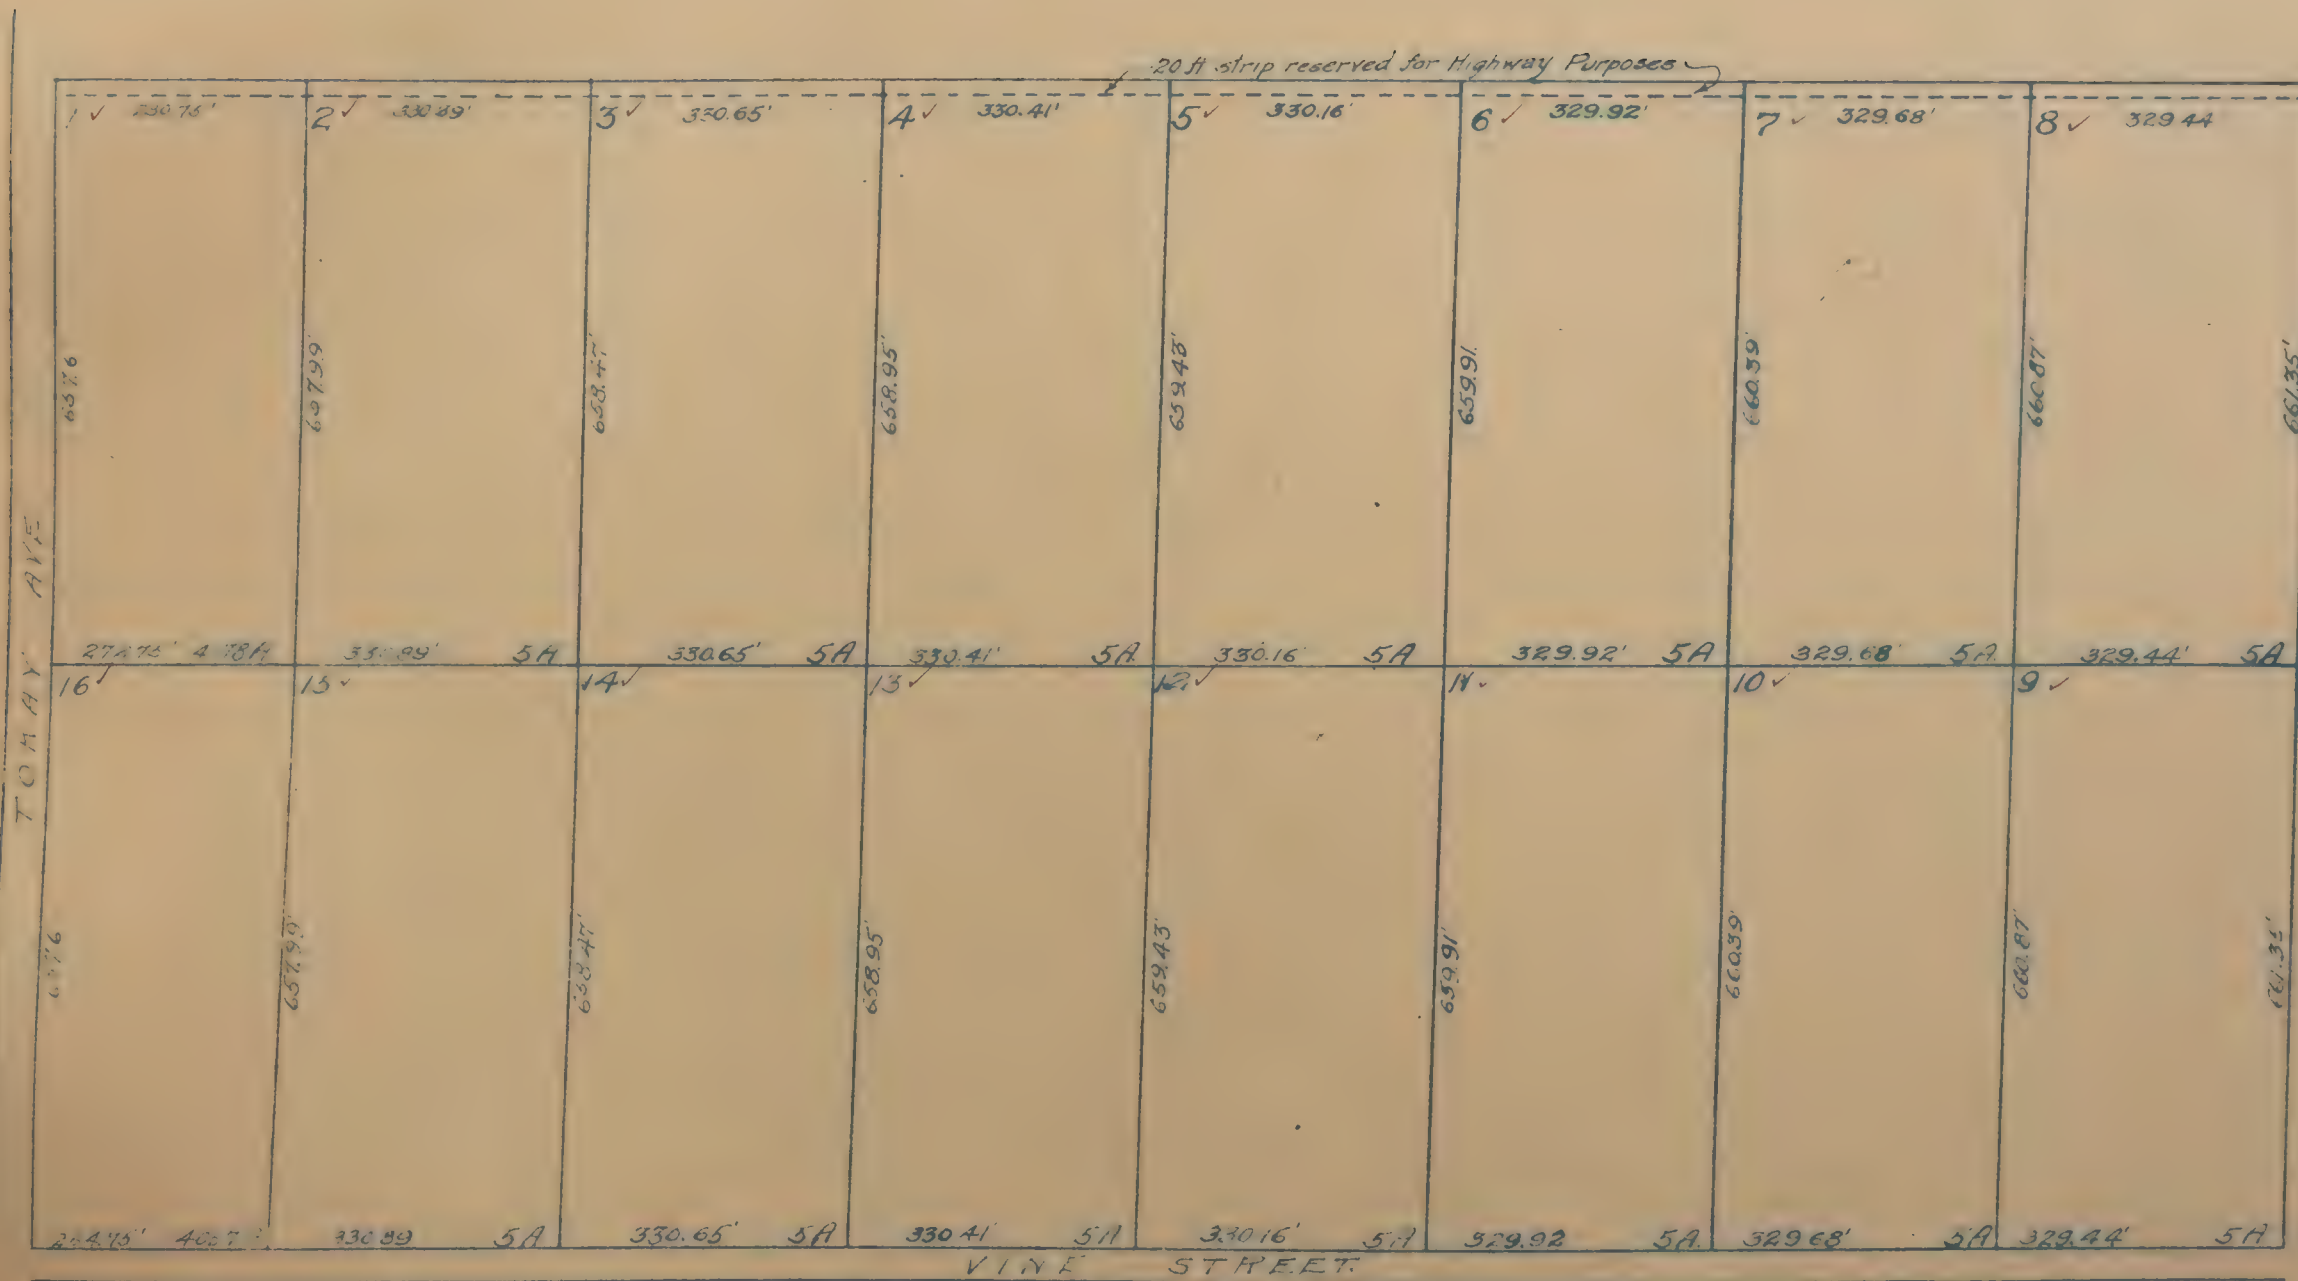

McCAULEY ADD'N TO GALT


LOCATED IN
W. 1/2 of Sec. 26, T. 8 N., R. 5 E.

Scale: 6 chs. = 1"

Blanks to G.M. Steele & F.G. Carey.

Galt S.D.

All Lots 5 Acs. unless otherwise noted.

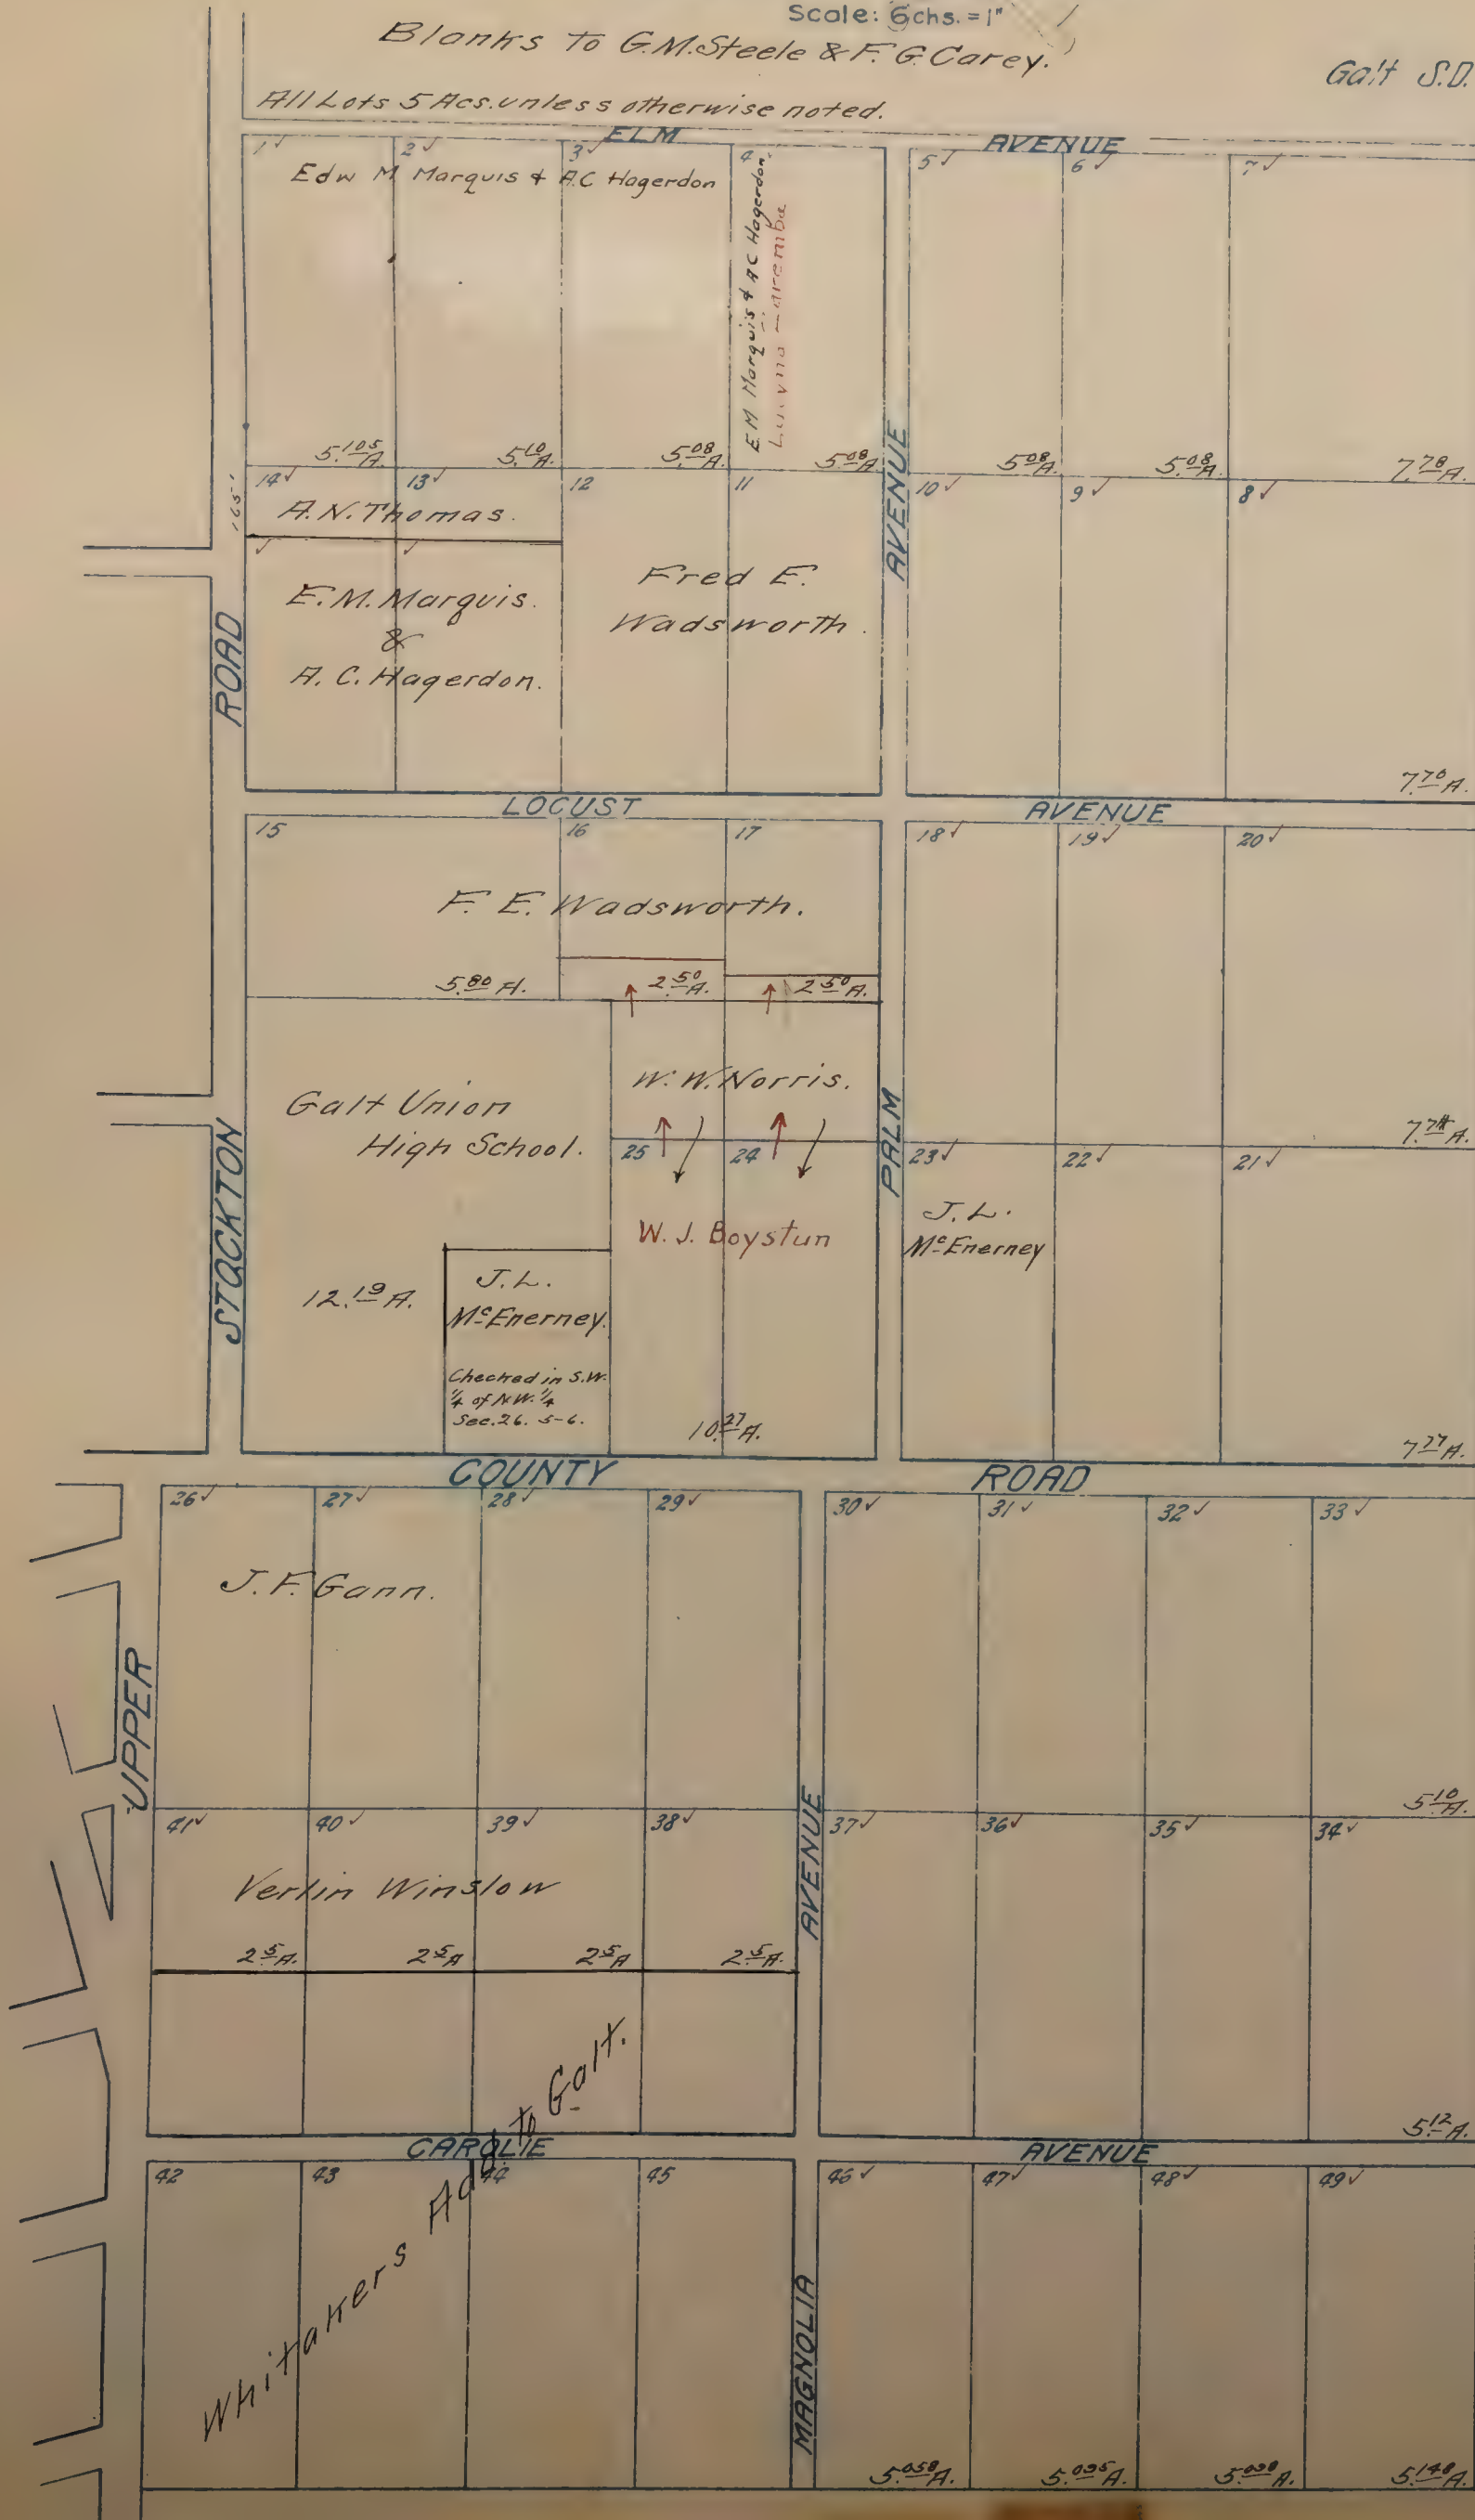


NATOMIS BENNETT SUB. ✓

Located in
T. 10 N. R. 3 E.
Scale: 1 in = 600 ft.

AMERICAN BASIN S.D.

Blanks to Natomas Co. of Calif.

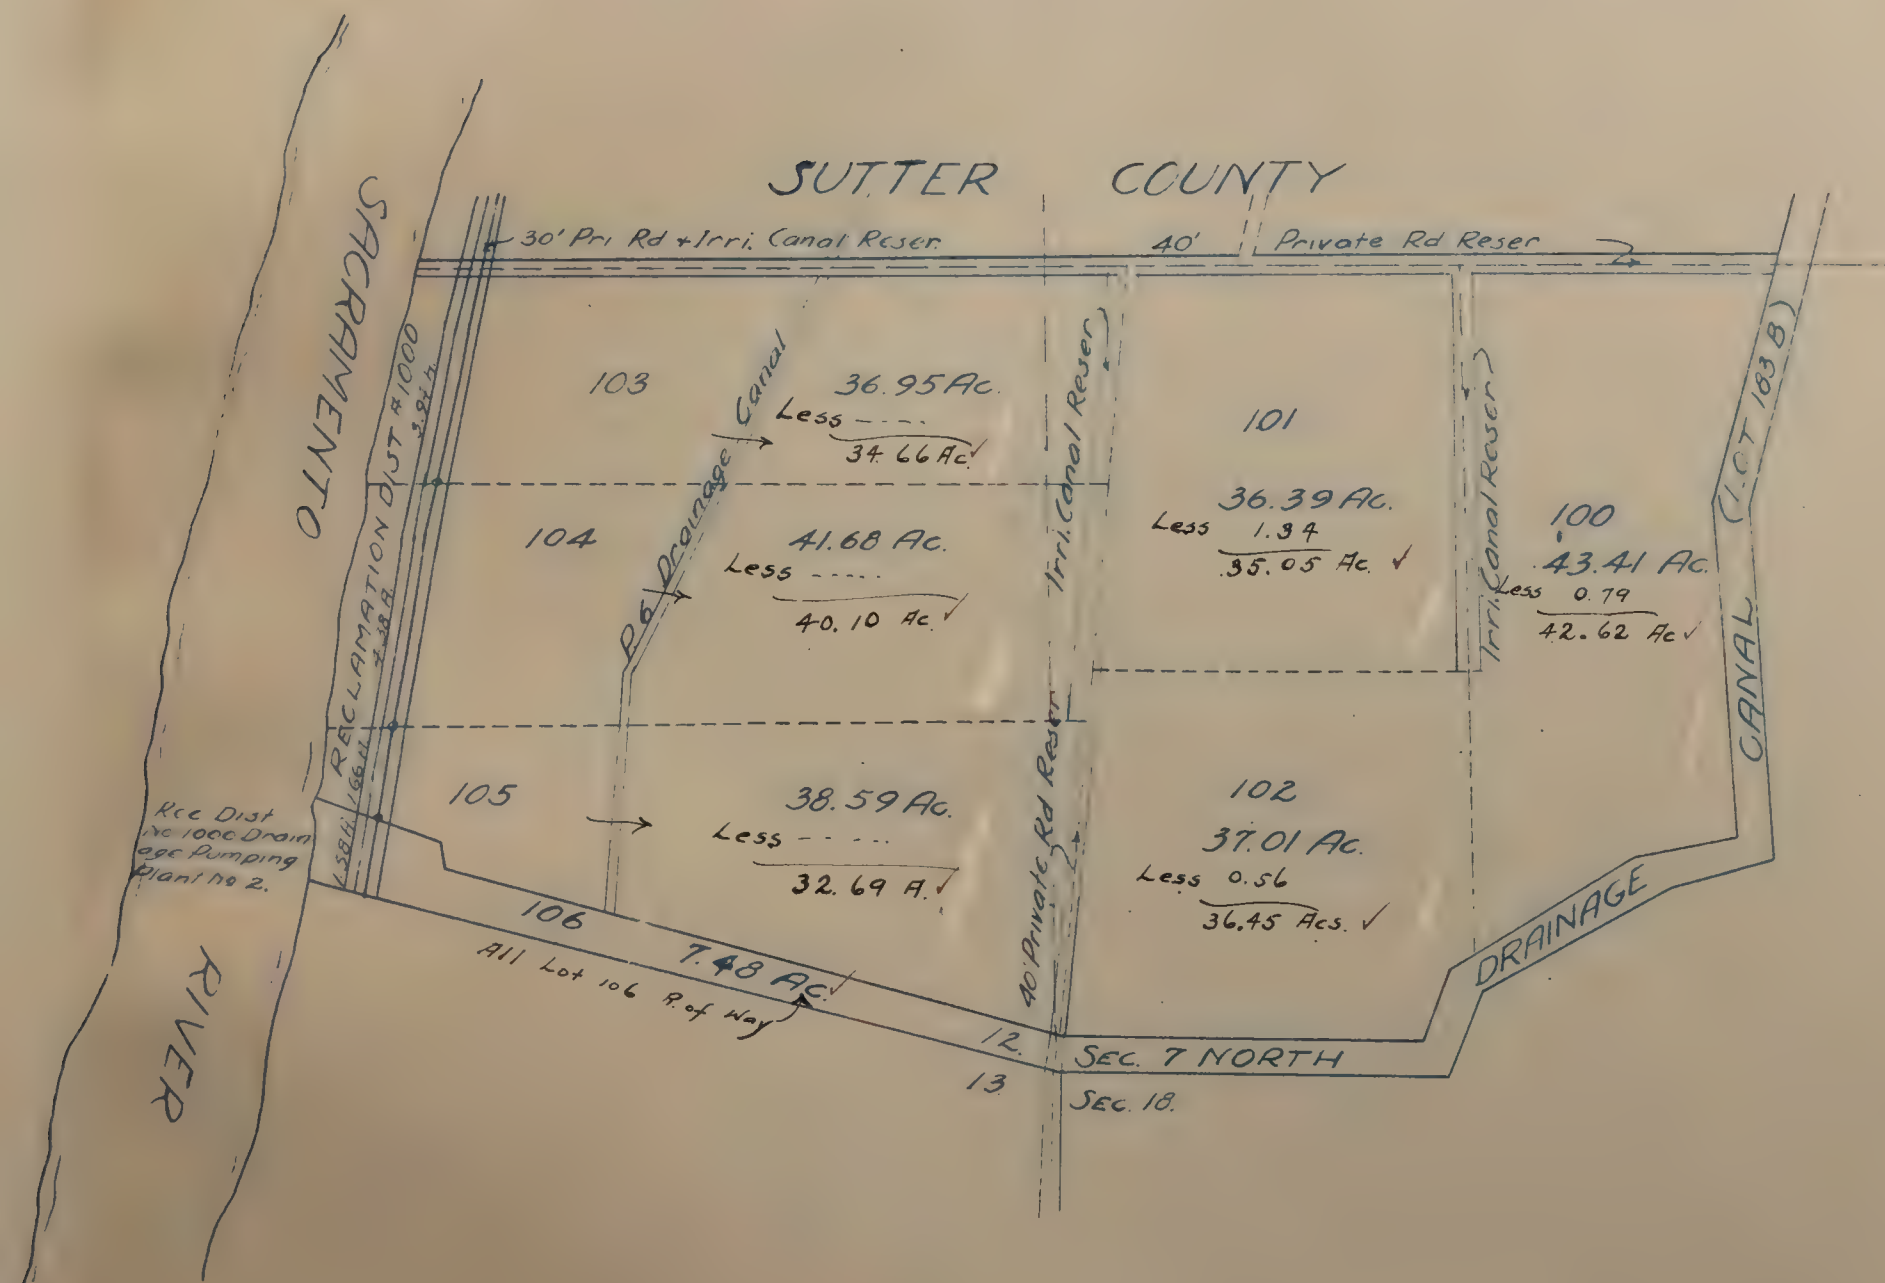

NATOMAS COMPANY OF CALIFORNIA
 MAP OF
 NATOMAS CENTRAL SUBDIVISION ✓
 IN
 TION. R. 4 E .


SHEET NO 2

American Basin S.D.

Lincoln S.D.

All blanks to Natomas Co. of Calif.

SUTTER COUNTY
 SACRAMENTO COUNTY

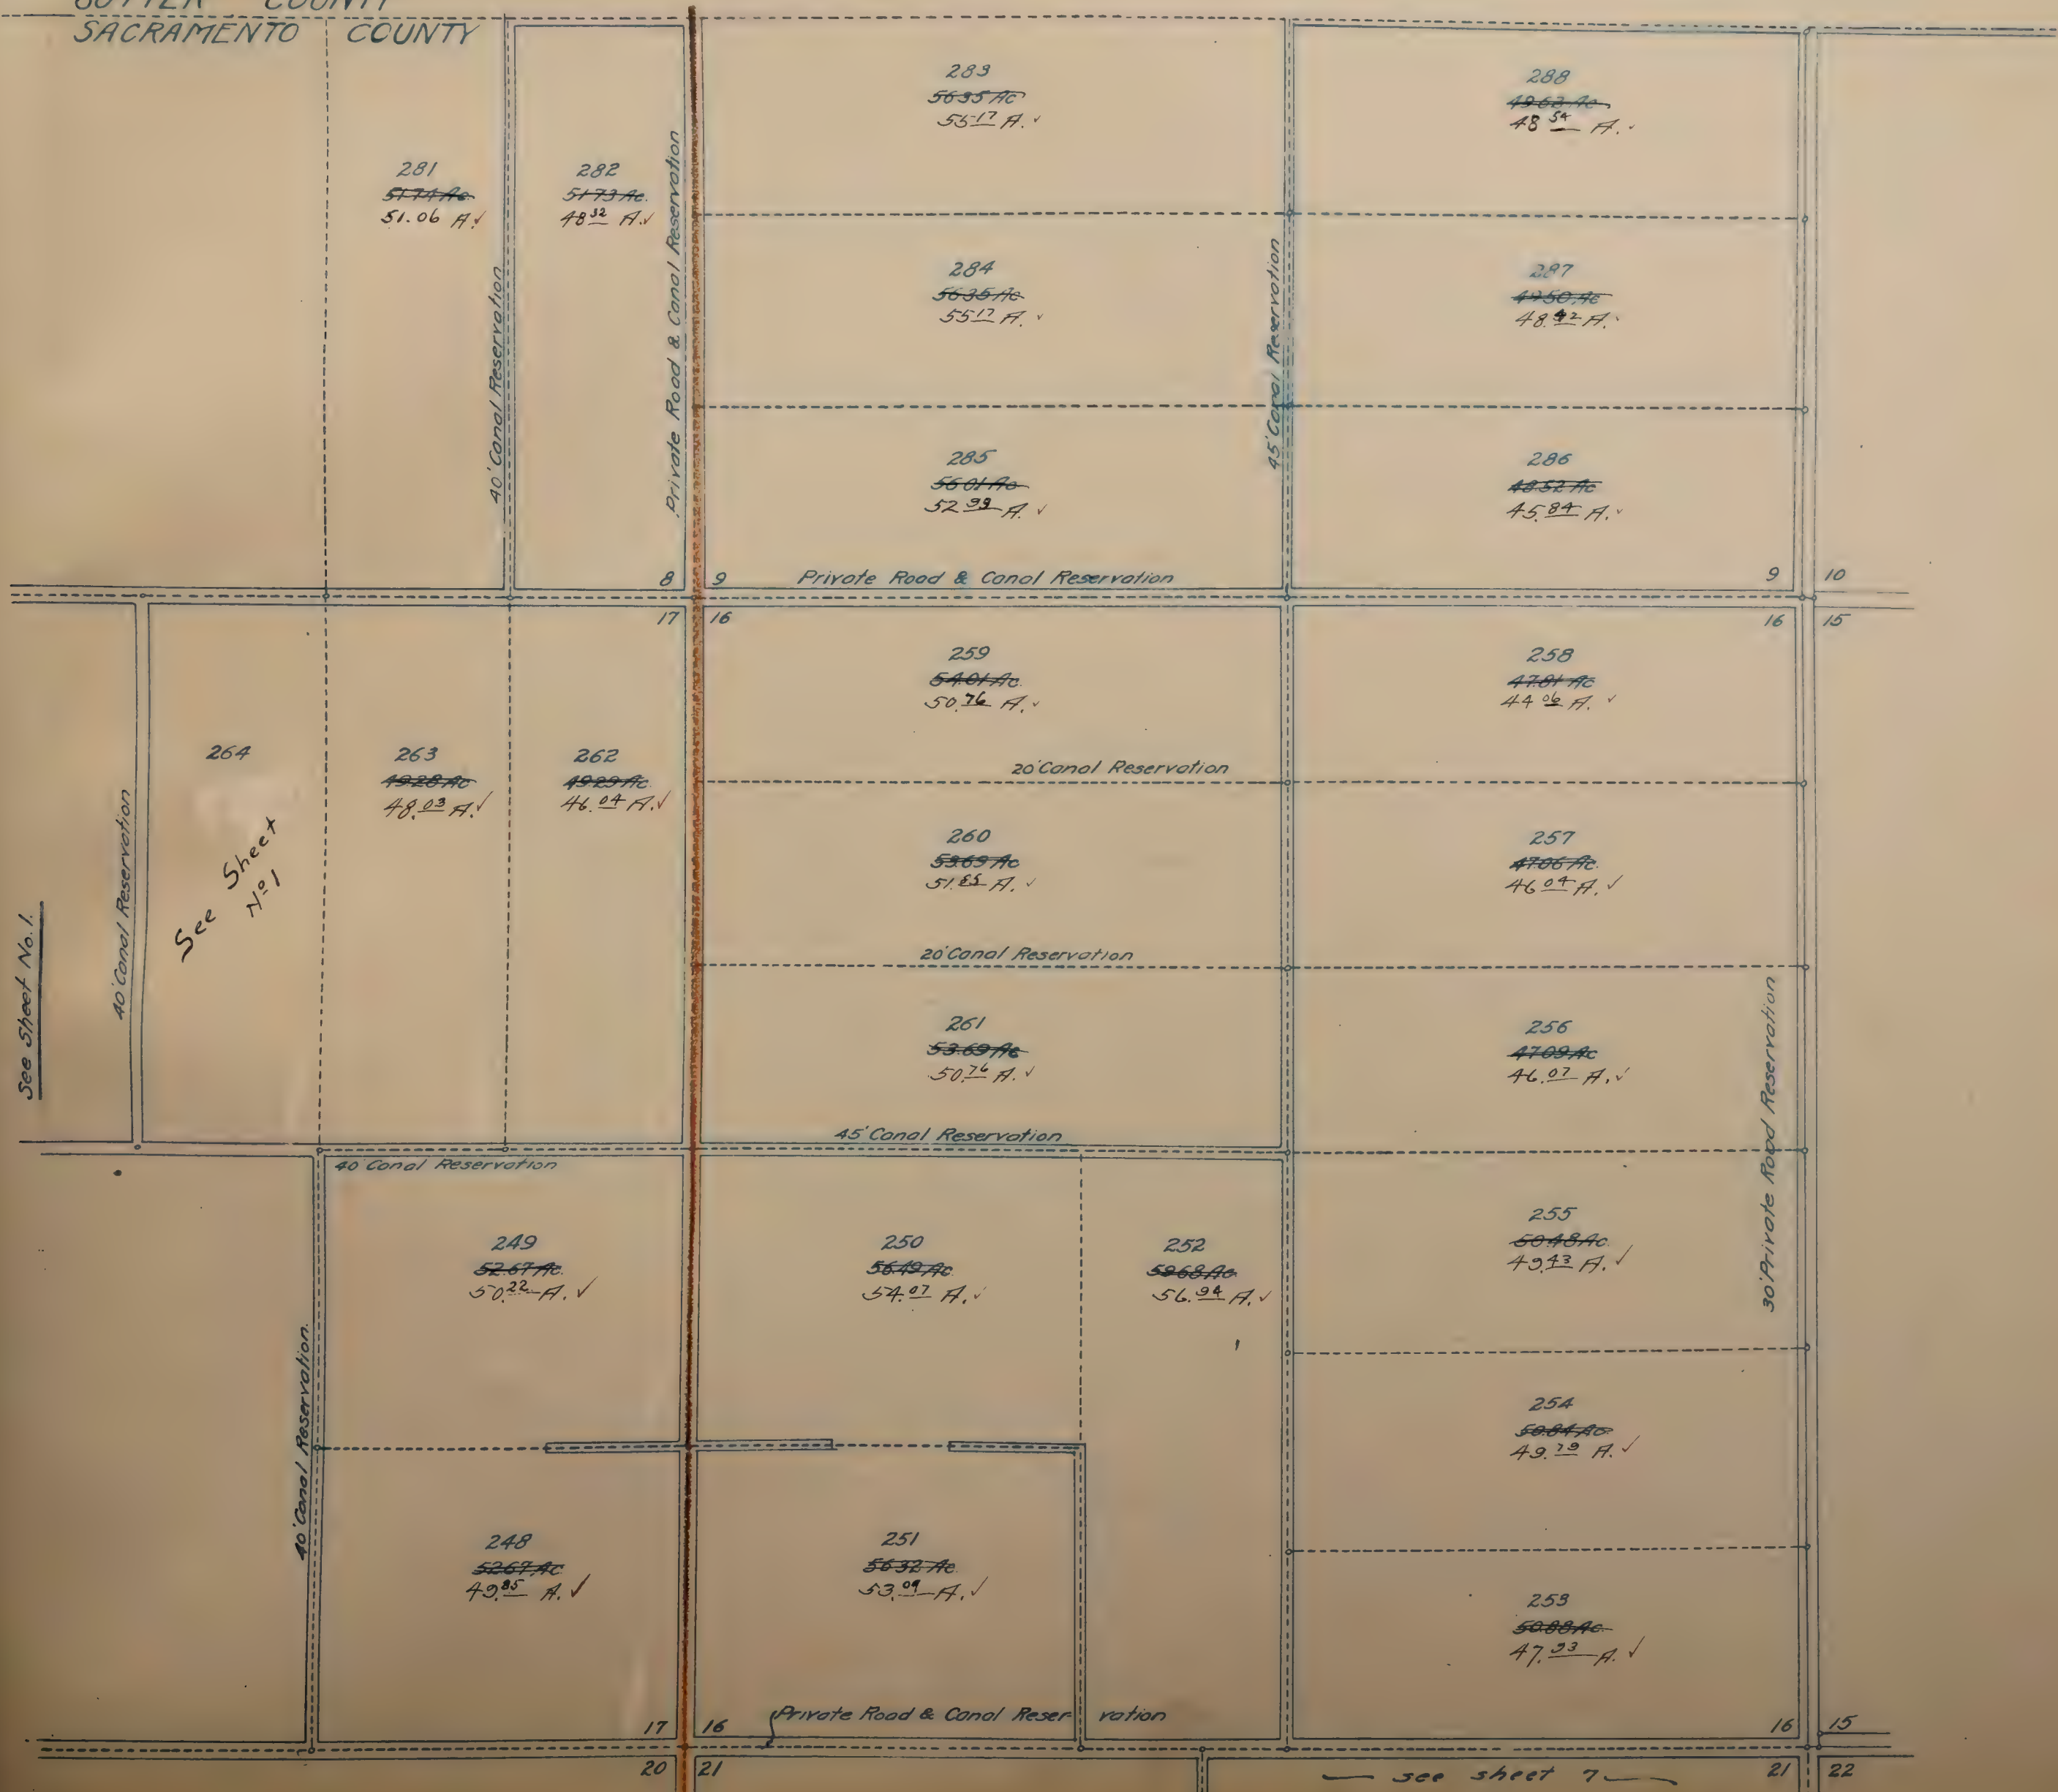


All Blanks To Natoma's Co. of Calif.

American Basin S.D.

Lincoln S. D.

— see sheet 1 —

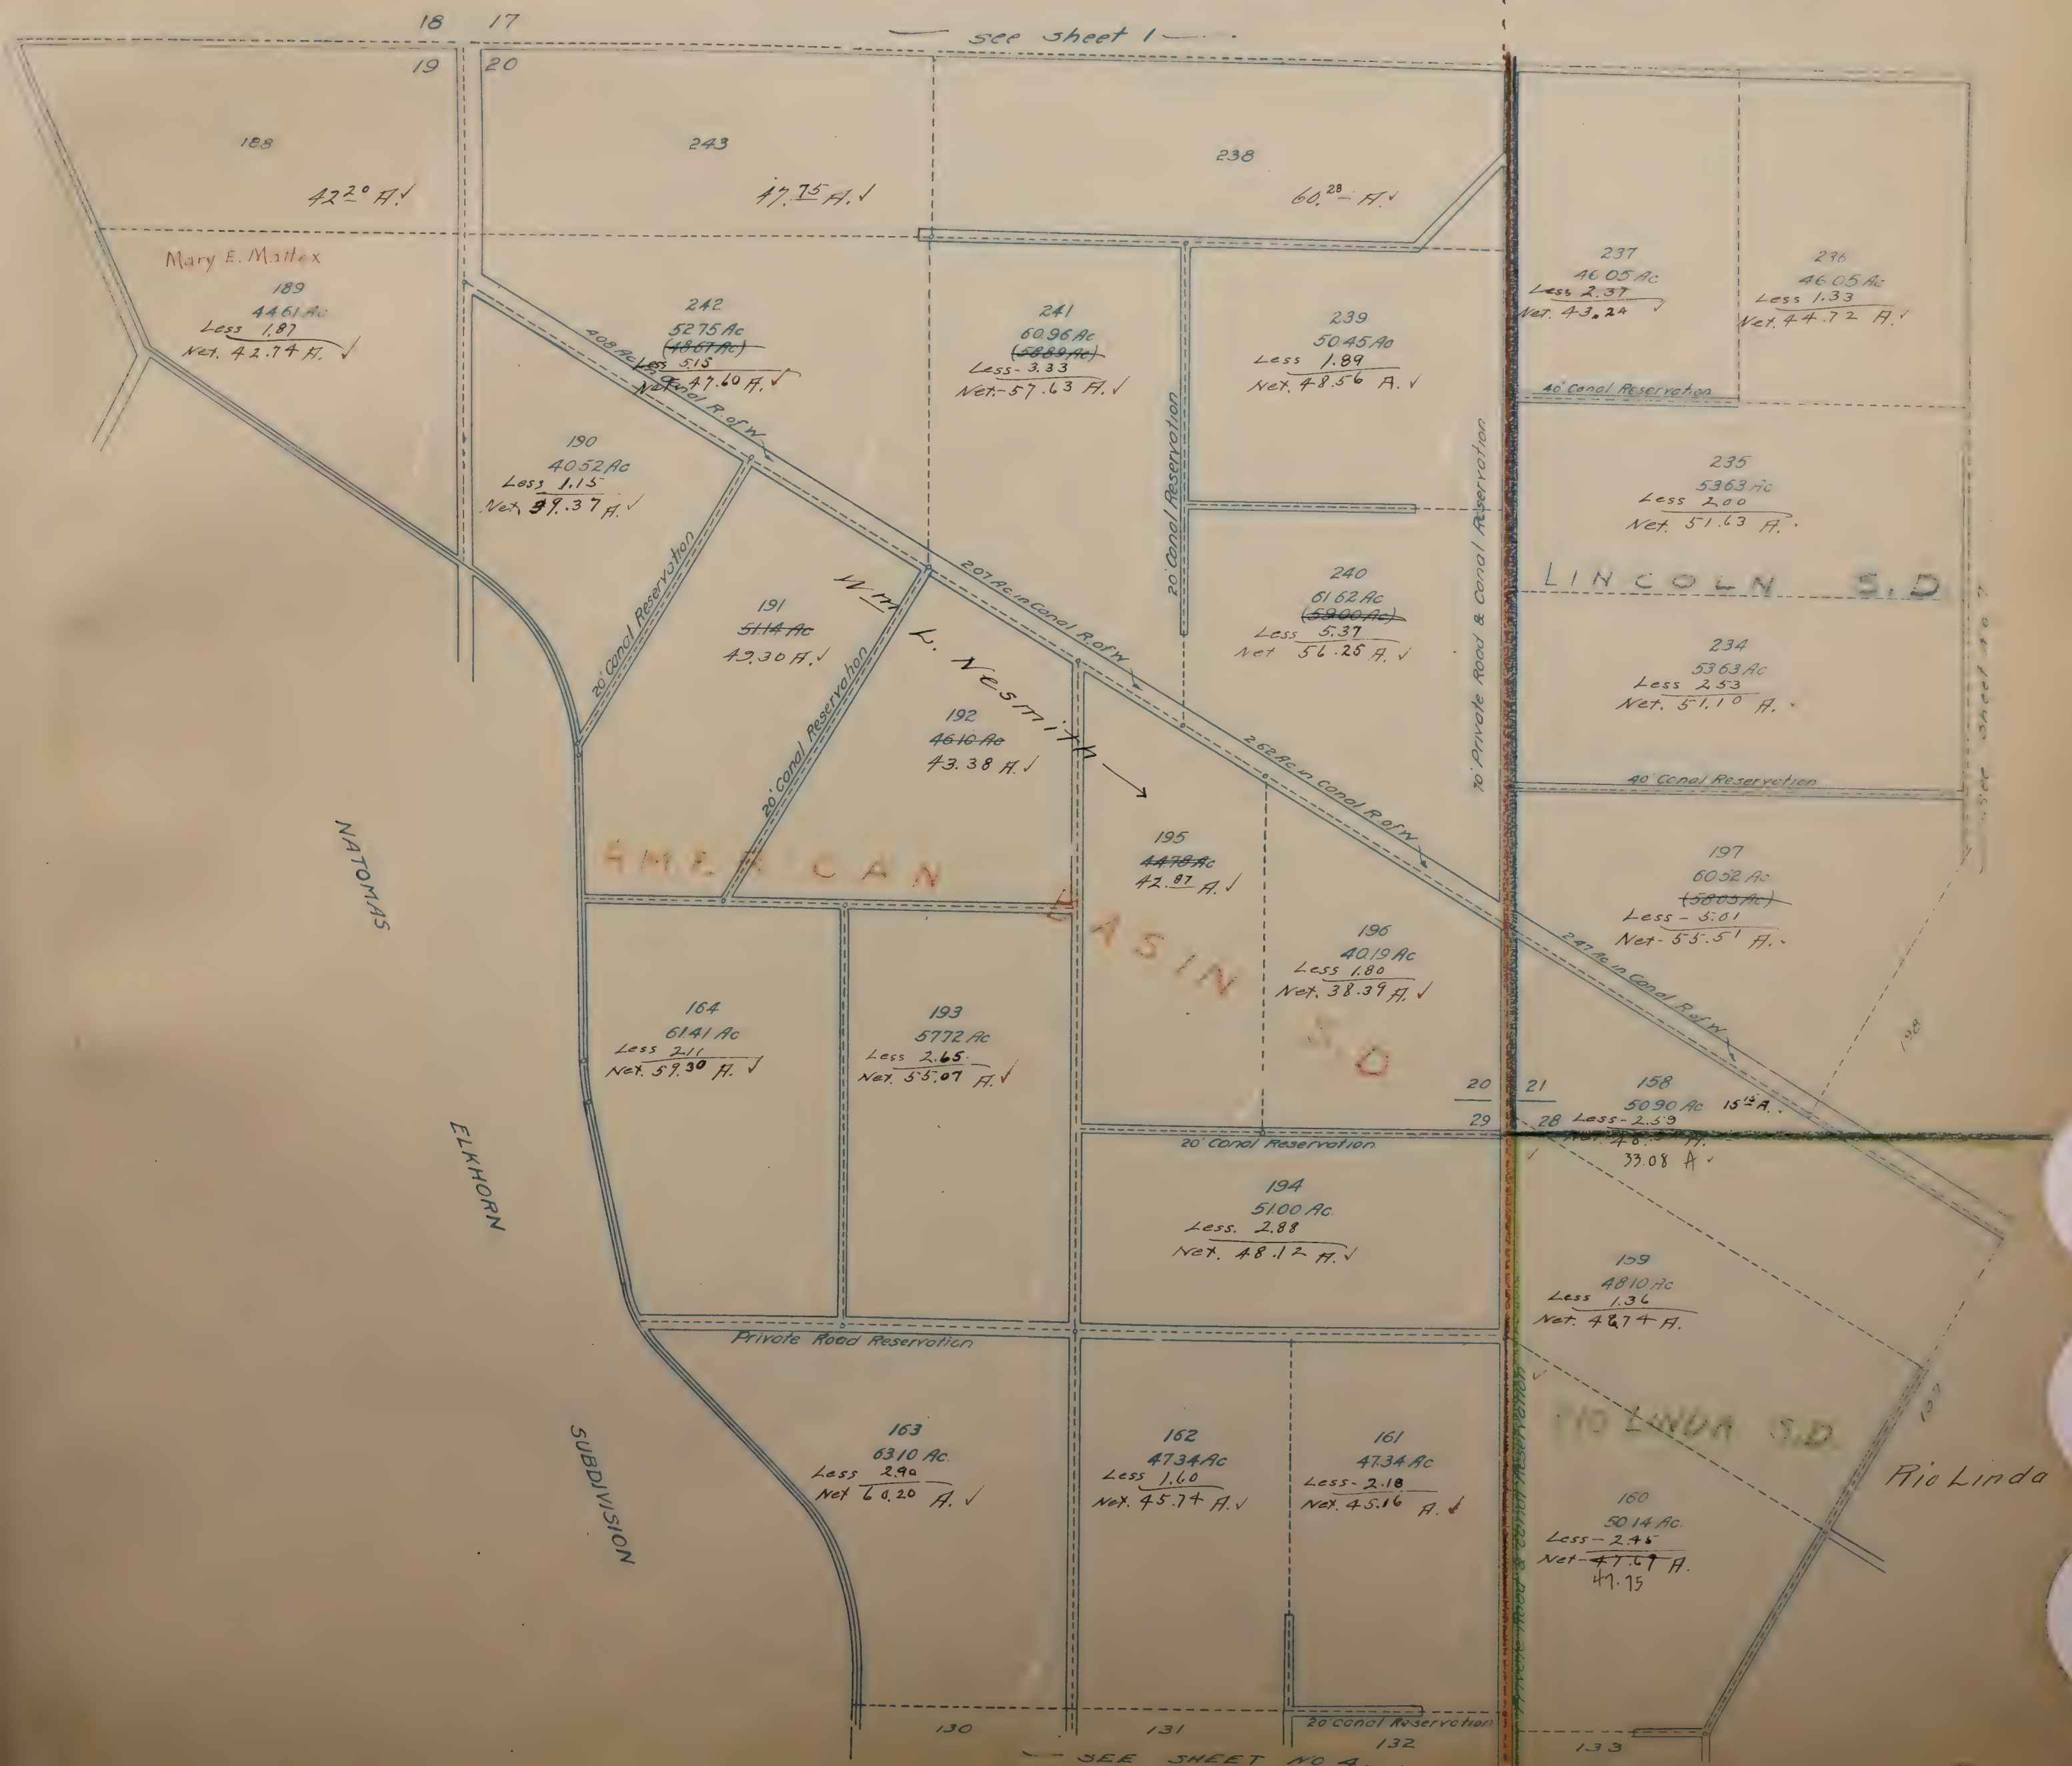


MAP OF
NATOMAS CENTRAL SUBDIVISION ✓
IN
T10N R4E

111 117 110 11

All blanks to Natomas Co. of Calif.


Rio Linda S.D.

see sheet 3

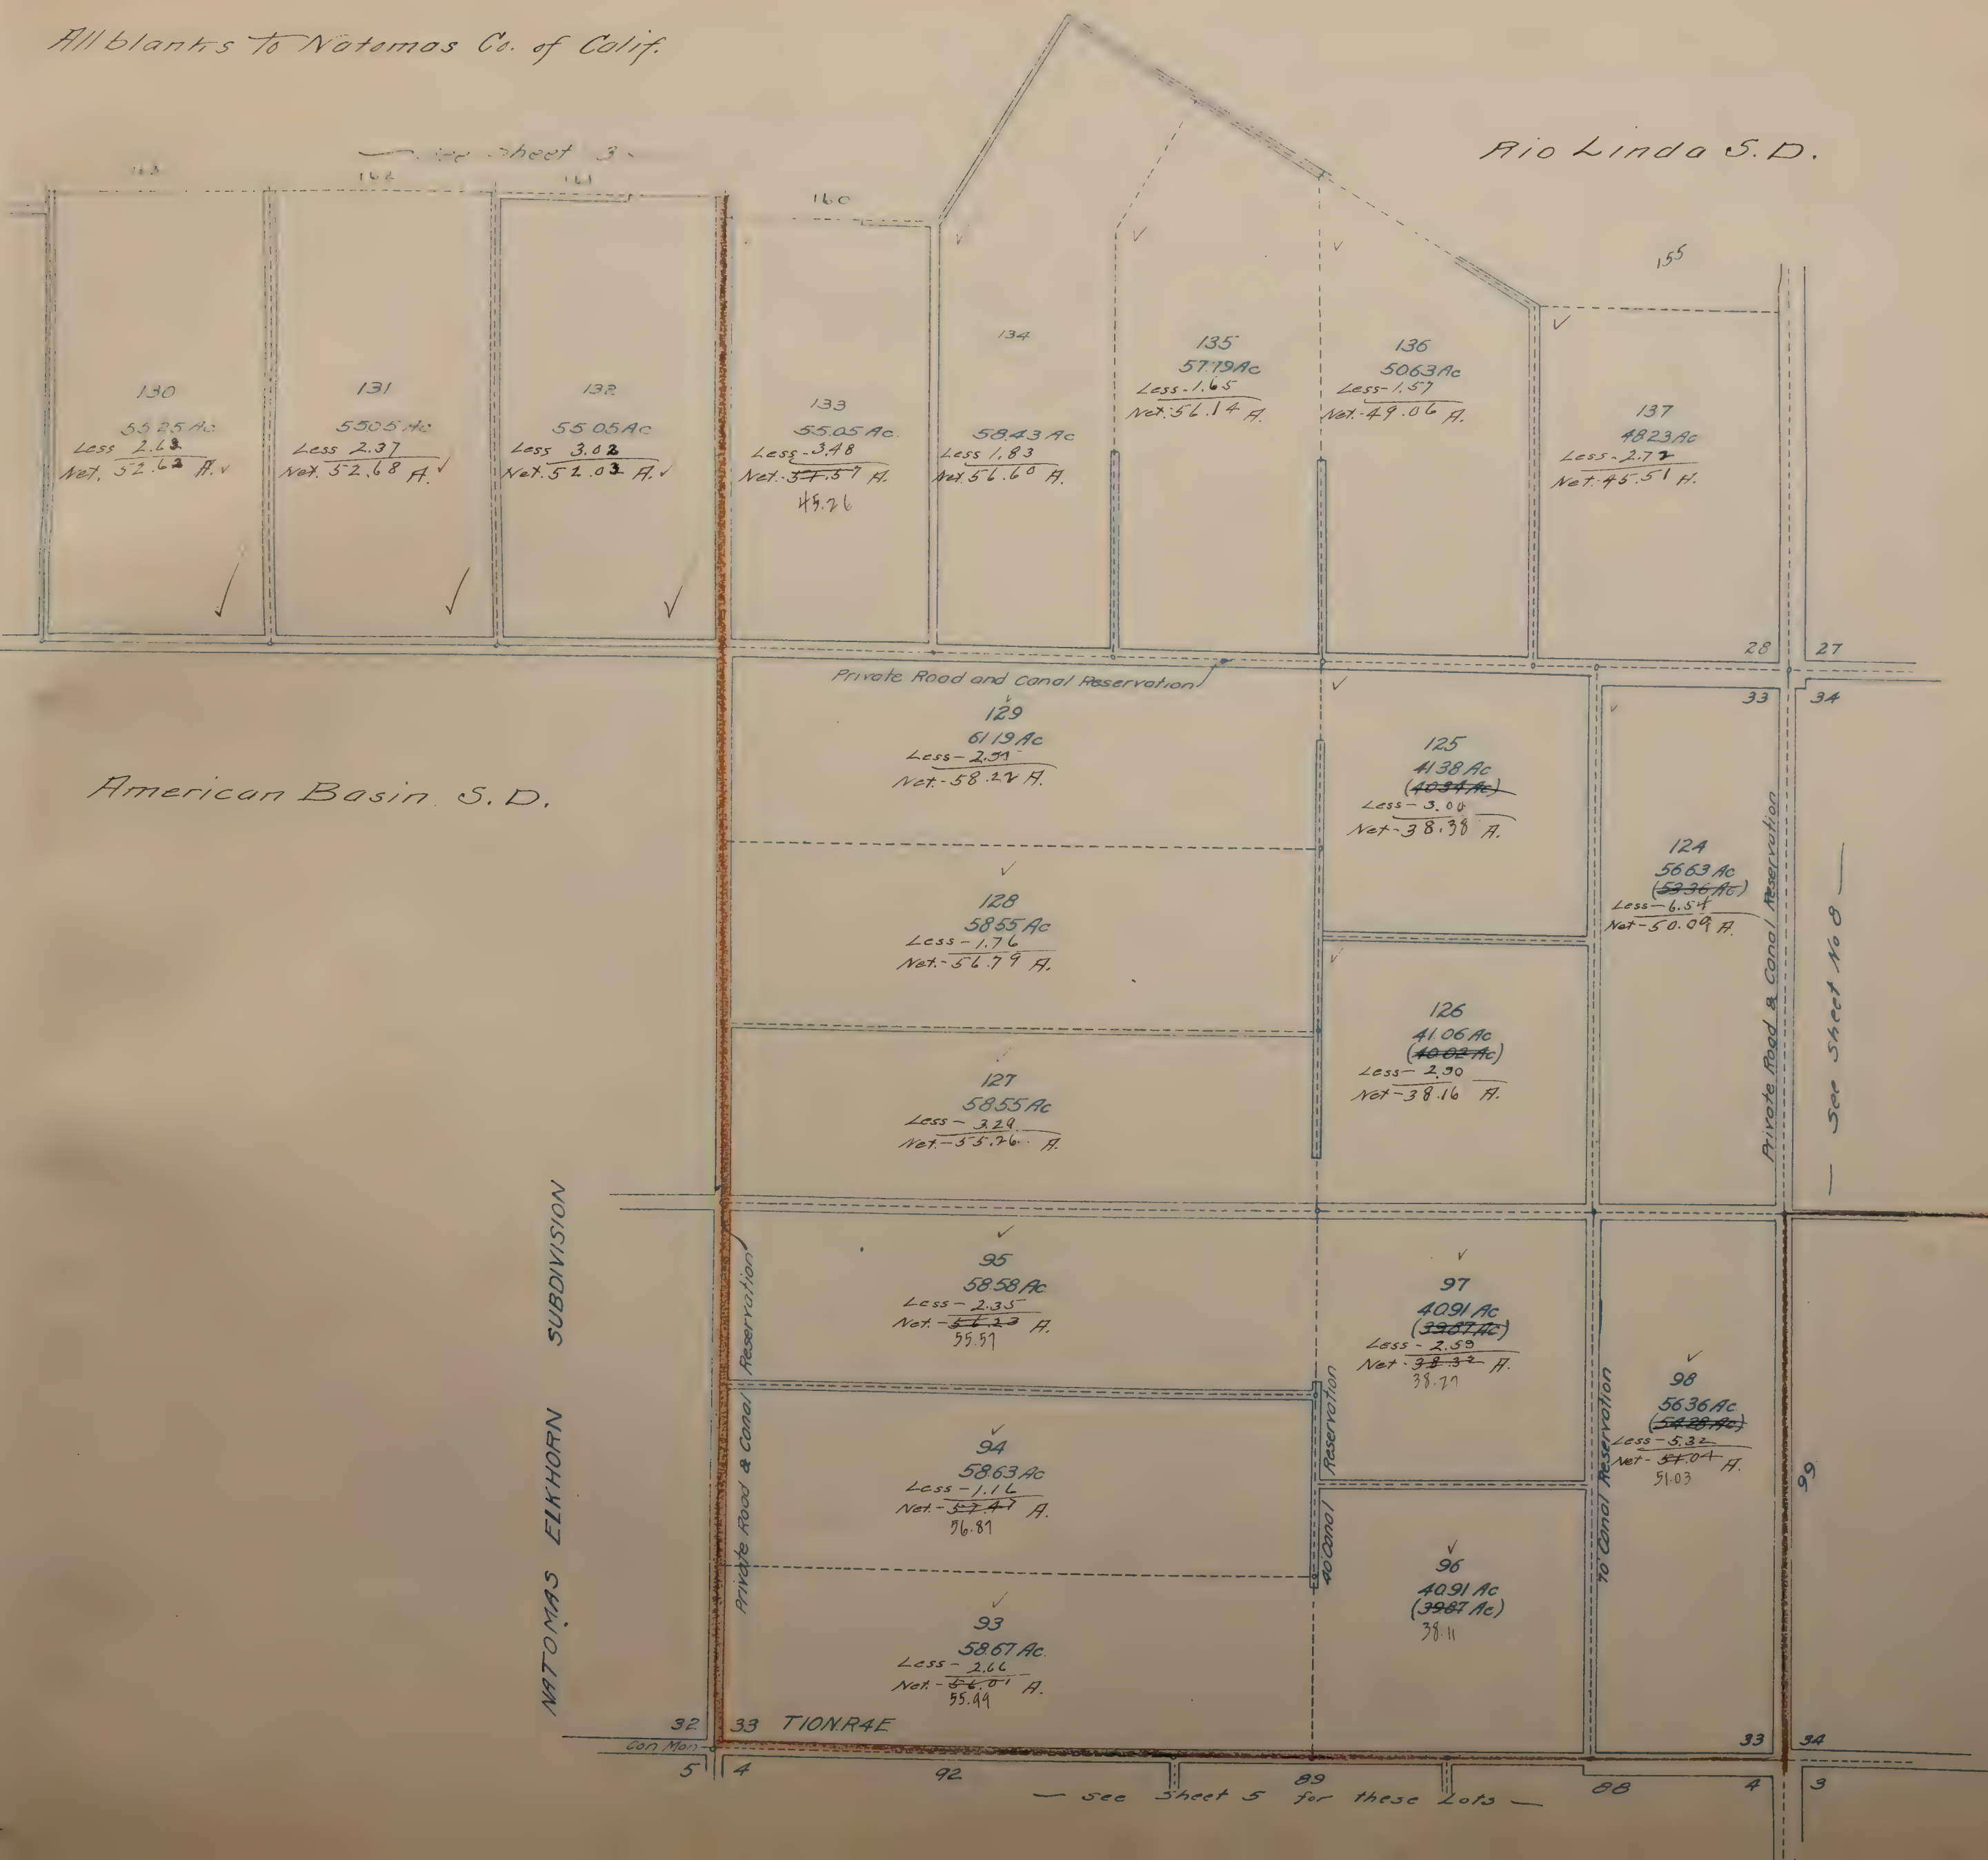

SHEET NO 5

Jefferson S. D.

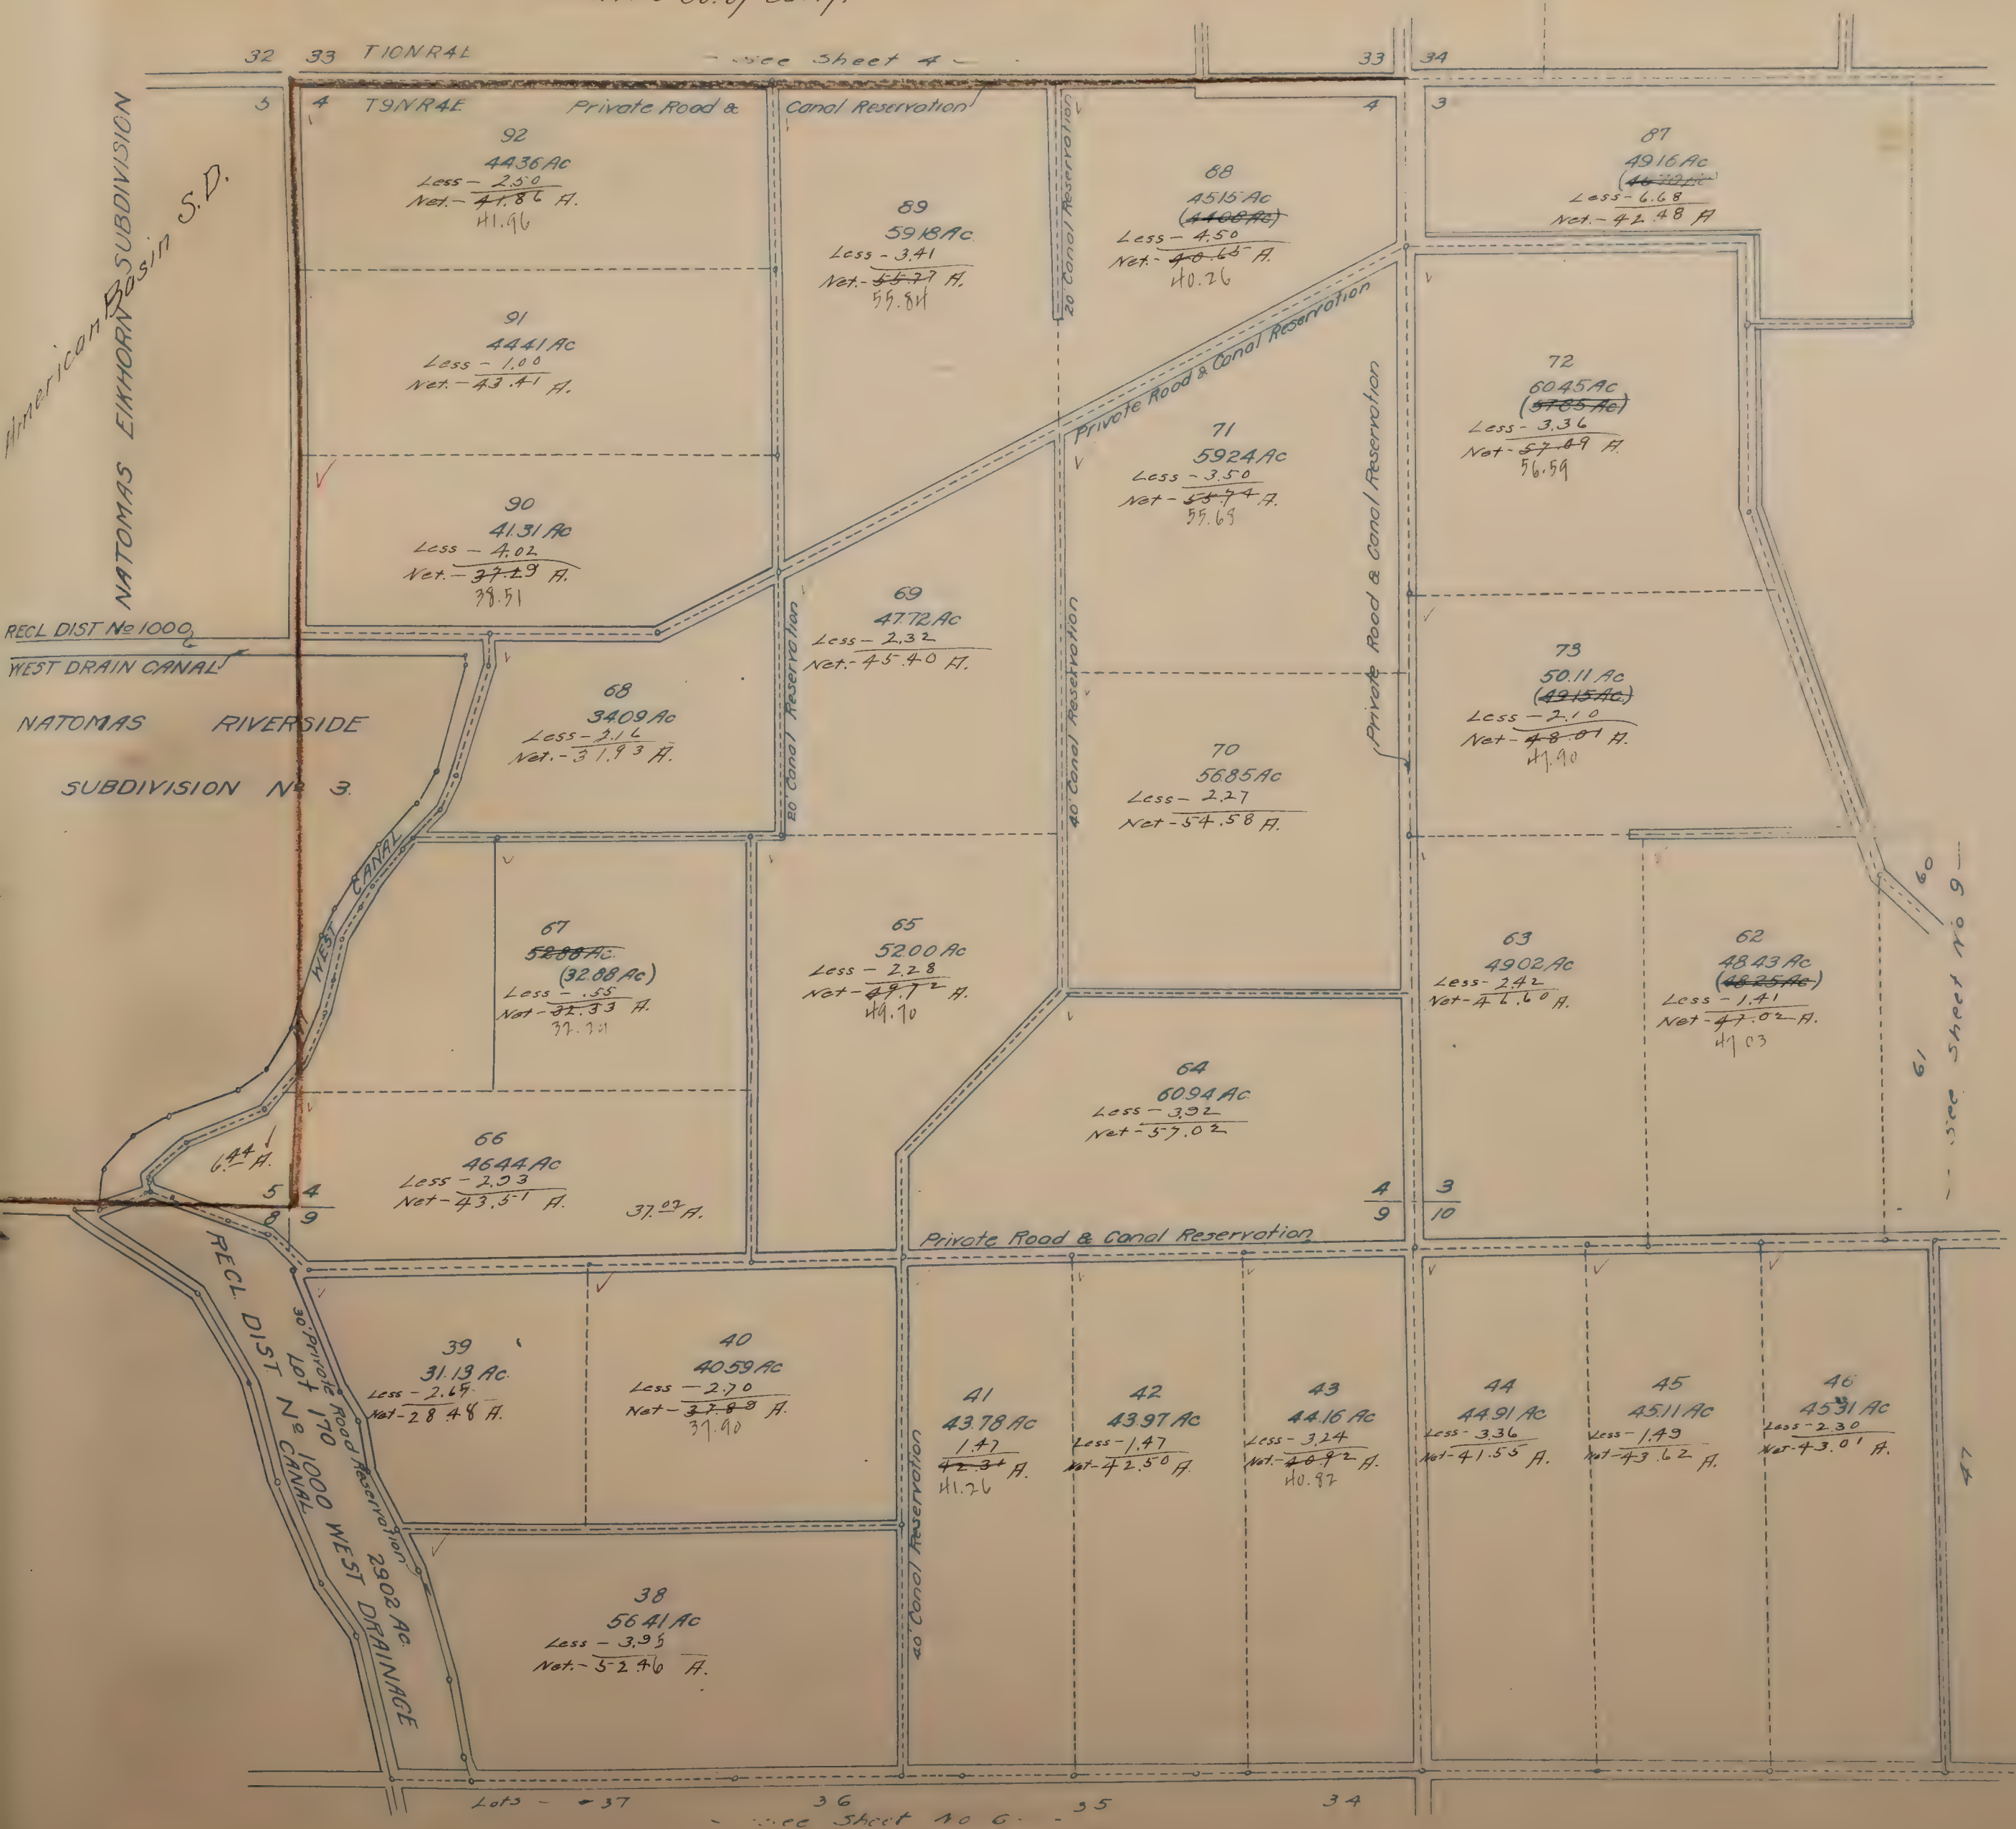


MAP OF
NATOMAS CENTRAL SUBDIVISION
IN
T9NR4E.

SHEET NO 6

All blanks to Natomas Co. of Calif.

Jefferson S. D.

See Sheet 5

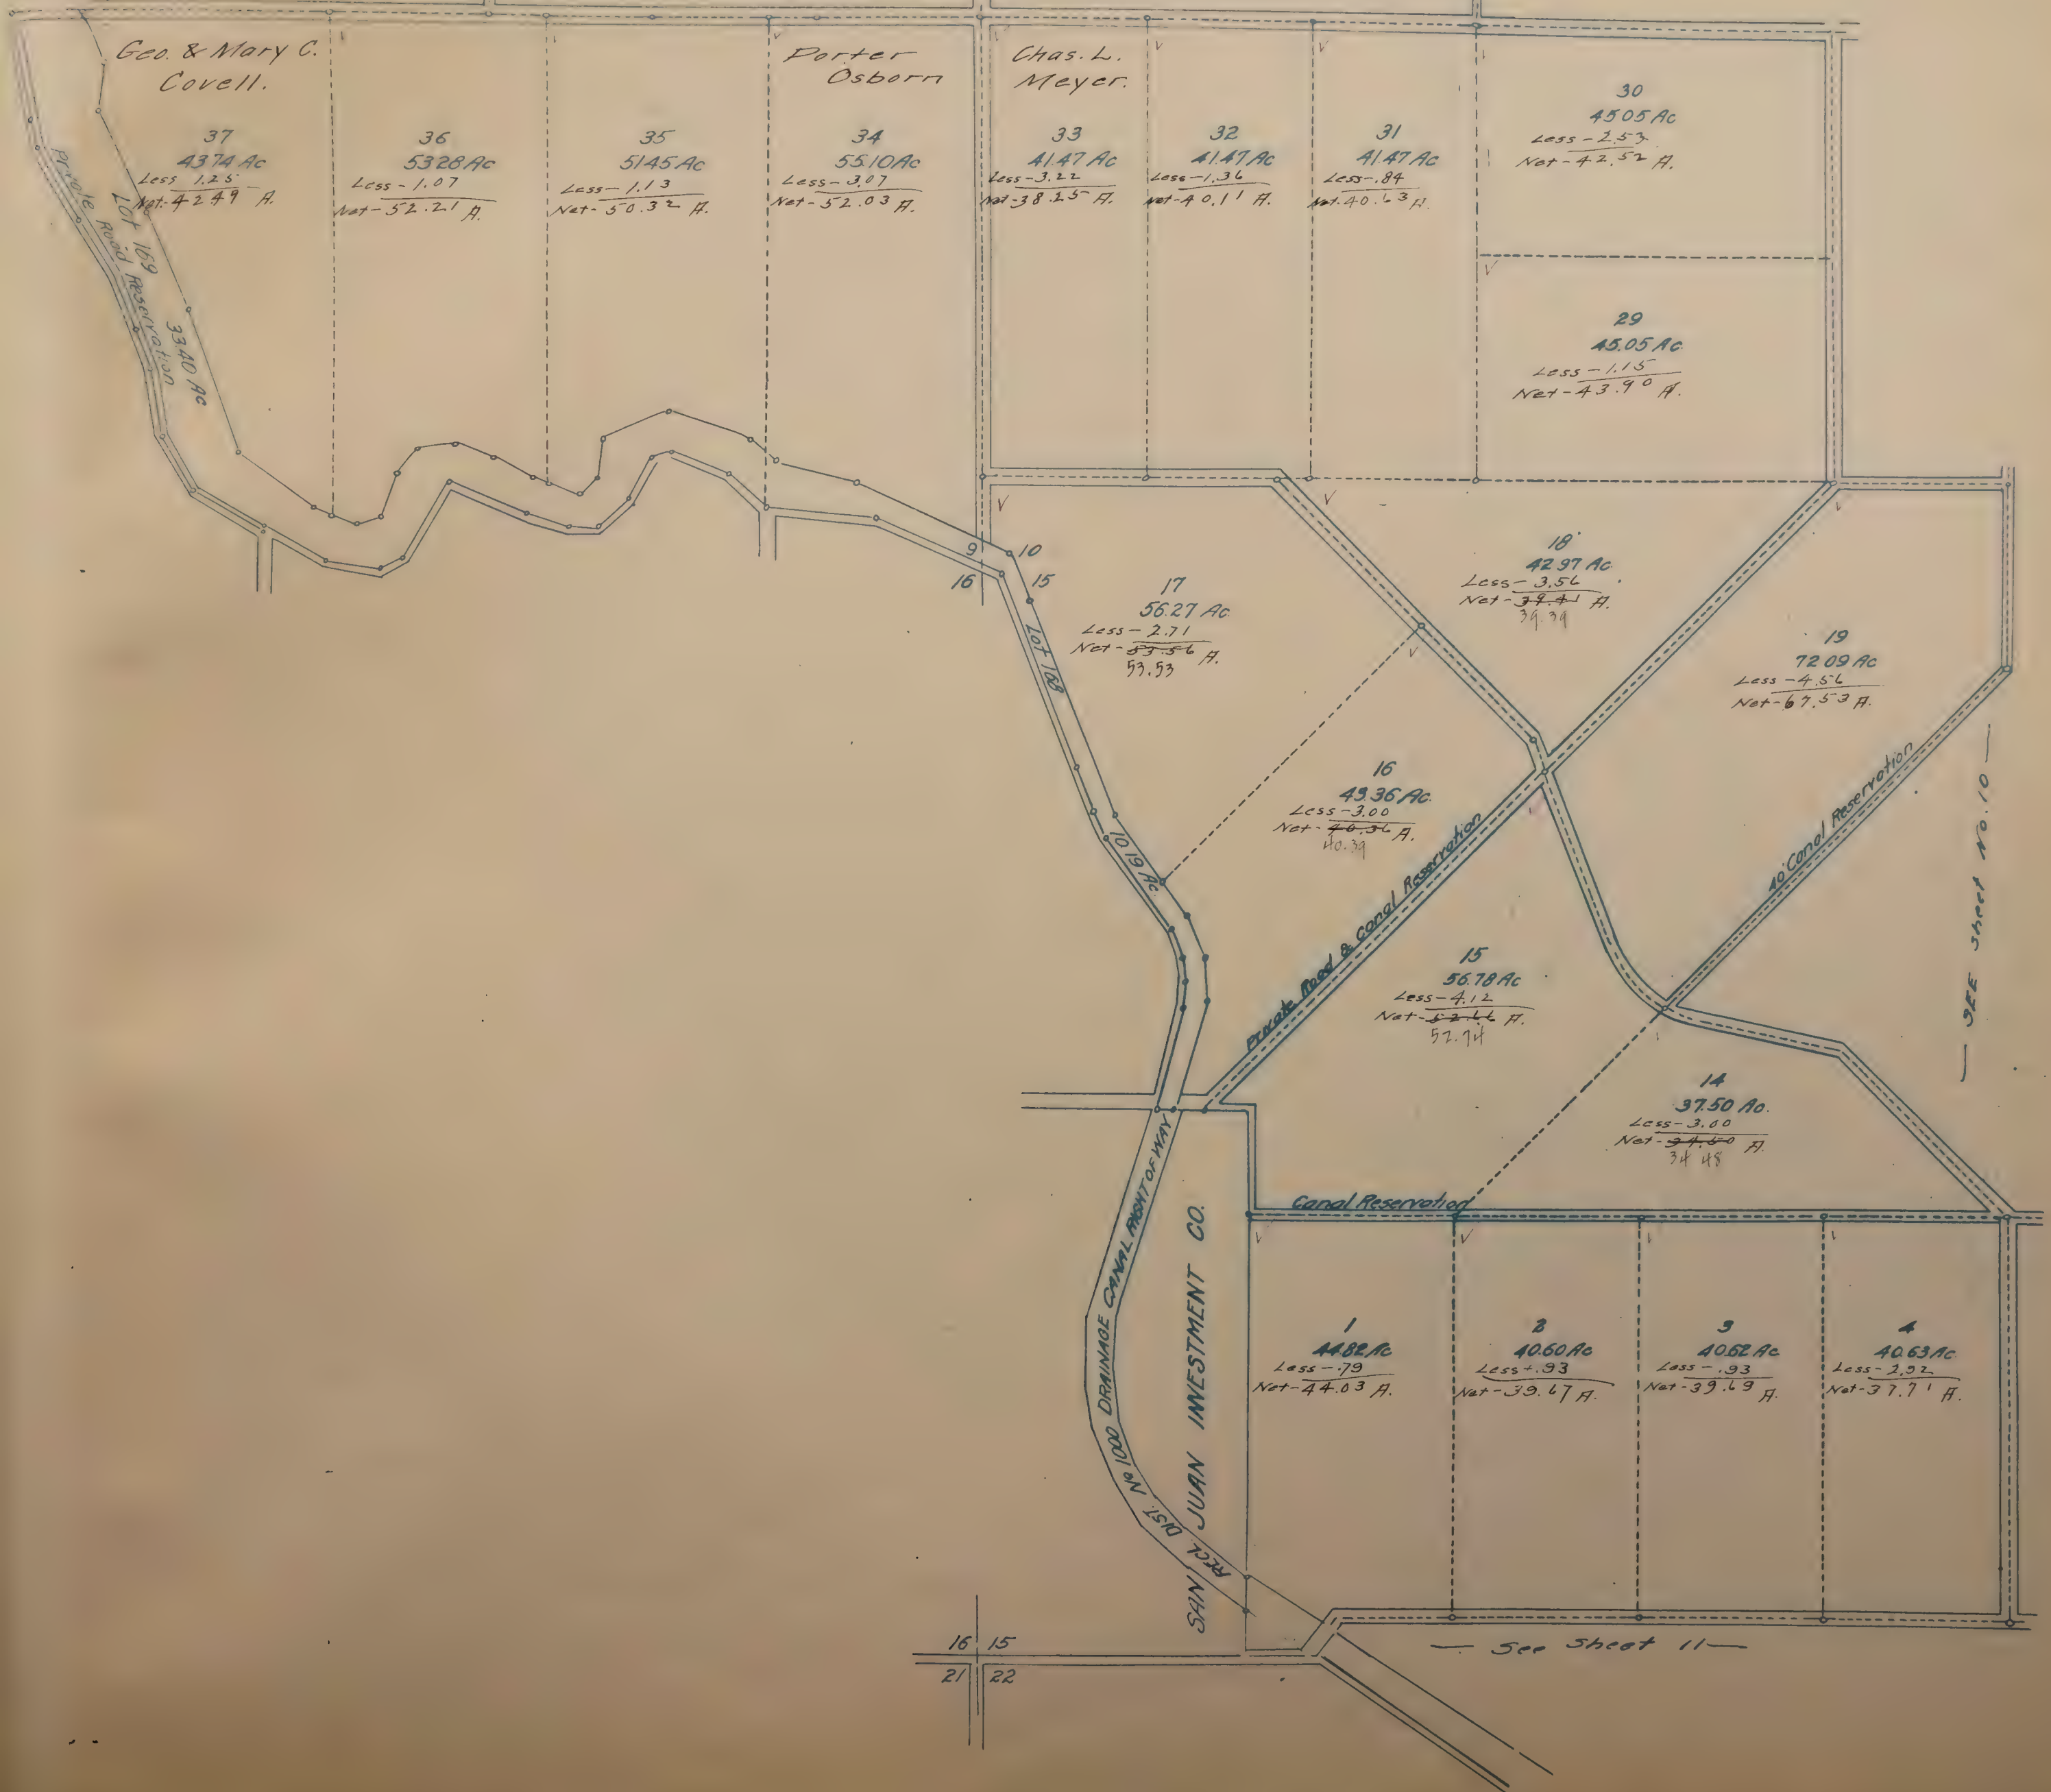

MAP OF
NATOMAS CENTRAL SUBDIVISION
IN
T10N.R4E.

SHEET NO 7

All blanks to Natomas Co. of Calif.

Lincoln S.D.



NATOMAS COMPANY OF CALIFORNIA
MAP OF
NATOMAS CENTRAL SUBDIVISION
IN
T.10N R.4E.

SHEET NO. 8.

Rio Linda S.D.

See sheet 7

See sheet 12

All Blanks To
Natomas Co. of Calif.

See sheet 10

SEE SHEET 10

156
4788 Ac
Less - 1.31
Net - 4786.69 A.
46.55

155
3892 Ac
Less - 2.00
Net - 3890 A.
46.55

154
3367 Ac
(3242 Ac)
Less - 3.70
Net - 2997 A.
46.55

152
4088 Ac
Less - 2.26
Net - 4085.74 A.
46.55

151
3346 Ac
Less - 2.26
Net - 3343.74 A.
46.55

150
4721 Ac
Less - 3.11
Net - 4717.89 A.
46.55

148
5252 Ac
Less - 5.20
Net - 5246.80 A.
47.77

149
5283 Ac
Less - 3.18
Net - 5279.82 A.
47.77

153
5108 Ac
(4974 Ac)
Less - 3.17
Net - 4970.83 A.
47.41

139
3918 Ac
Less - .96
Net - 3917.04 A.
38.71

140
4518 Ac
Less - 7.6
Net - 4510.4 A.
44.42

141
4519 Ac
Less - 2.20
Net - 4516.8 A.
42.98

142
4320 Ac
Less - 3.67
Net - 4316.33 A.
39.54

143
6239 Ac
Less - 3.12
Net - 6235.88 A.
54.25

144
6253 Ac
Less - 3.12
Net - 6250 A.
54.39

138
5003 Ac
(4850 Ac)
Less - 5.50
Net - 4844.5 A.
45.66

123
3802 Ac
Less - 2.94
Net - 3799.06 A.
39.10

120
3385 Ac
Less - 2.76
Net - 3382.24 A.
31.07

119
4786 Ac
Less - 4.08
Net - 4781.92 A.
46.55

113
4872 Ac
Less - 2.31
Net - 4869.69 A.
45.41

112
4880 Ac
Less - 2.48
Net - 4877.52 A.
45.41

122
3779 Ac
Less - 2.08
Net - 3776.92 A.
38.71

121
3377 Ac
Less - 1.67
Net - 3375.33 A.
31.07

117
4802 Ac
Less - 1.30
Net - 4800.7 A.
46.72

114
4869 Ac
Less - 1.39
Net - 4867.61 A.
45.41

116
4786 Ac
Less - 1.90
Net - 4784.1 A.
46.55

115
4869 Ac
Less - 1.39
Net - 4867.61 A.
45.41

F. H. Preston,
Nat. Co. of Calif.

99
4040 Ac
Less - 2.84
Net - 4037.16 A.
46.55

100
5355 Ac
Less - 2.61
Net - 5352.39 A.
46.55

101
4927 Ac
Less - 2.95
Net - 4924.05 A.
46.41

103
3801 Ac
Less - 1.99
Net - 3799.01 A.
39.10

104
5024 Ac
Less - 2.72
Net - 5021.28 A.
46.35

105
4869 Ac
Less - 1.39
Net - 4867.61 A.
45.41

106
4869 Ac
Less - 1.39
Net - 4867.61 A.
45.41

102
4868 Ac
Less - 4.24
Net - 4863.76 A.
46.35

107
4869 Ac
Less - 1.39
Net - 4867.61 A.
45.41

34 35 45.11 46.55 A. T.10N R.4E

—see sheet 10—

MAP OF NATOMAS CENTRAL SUBDIVISION IN T₉S 9&10 R 4 E.

SHEET NO 10

Jefferson S.D.

All Blanks to Natomas Co. of Calif.

— see sheet 9 —
T₉N R 4 E

Rio Linda S.D.



See Sheet No. 6.

NATOMAS COMPANY OF CALIFORNIA

Jefferson S.D.

EAST DRAINAGE CANAL

NATOMAS COMPANY OF CALIFORNIA

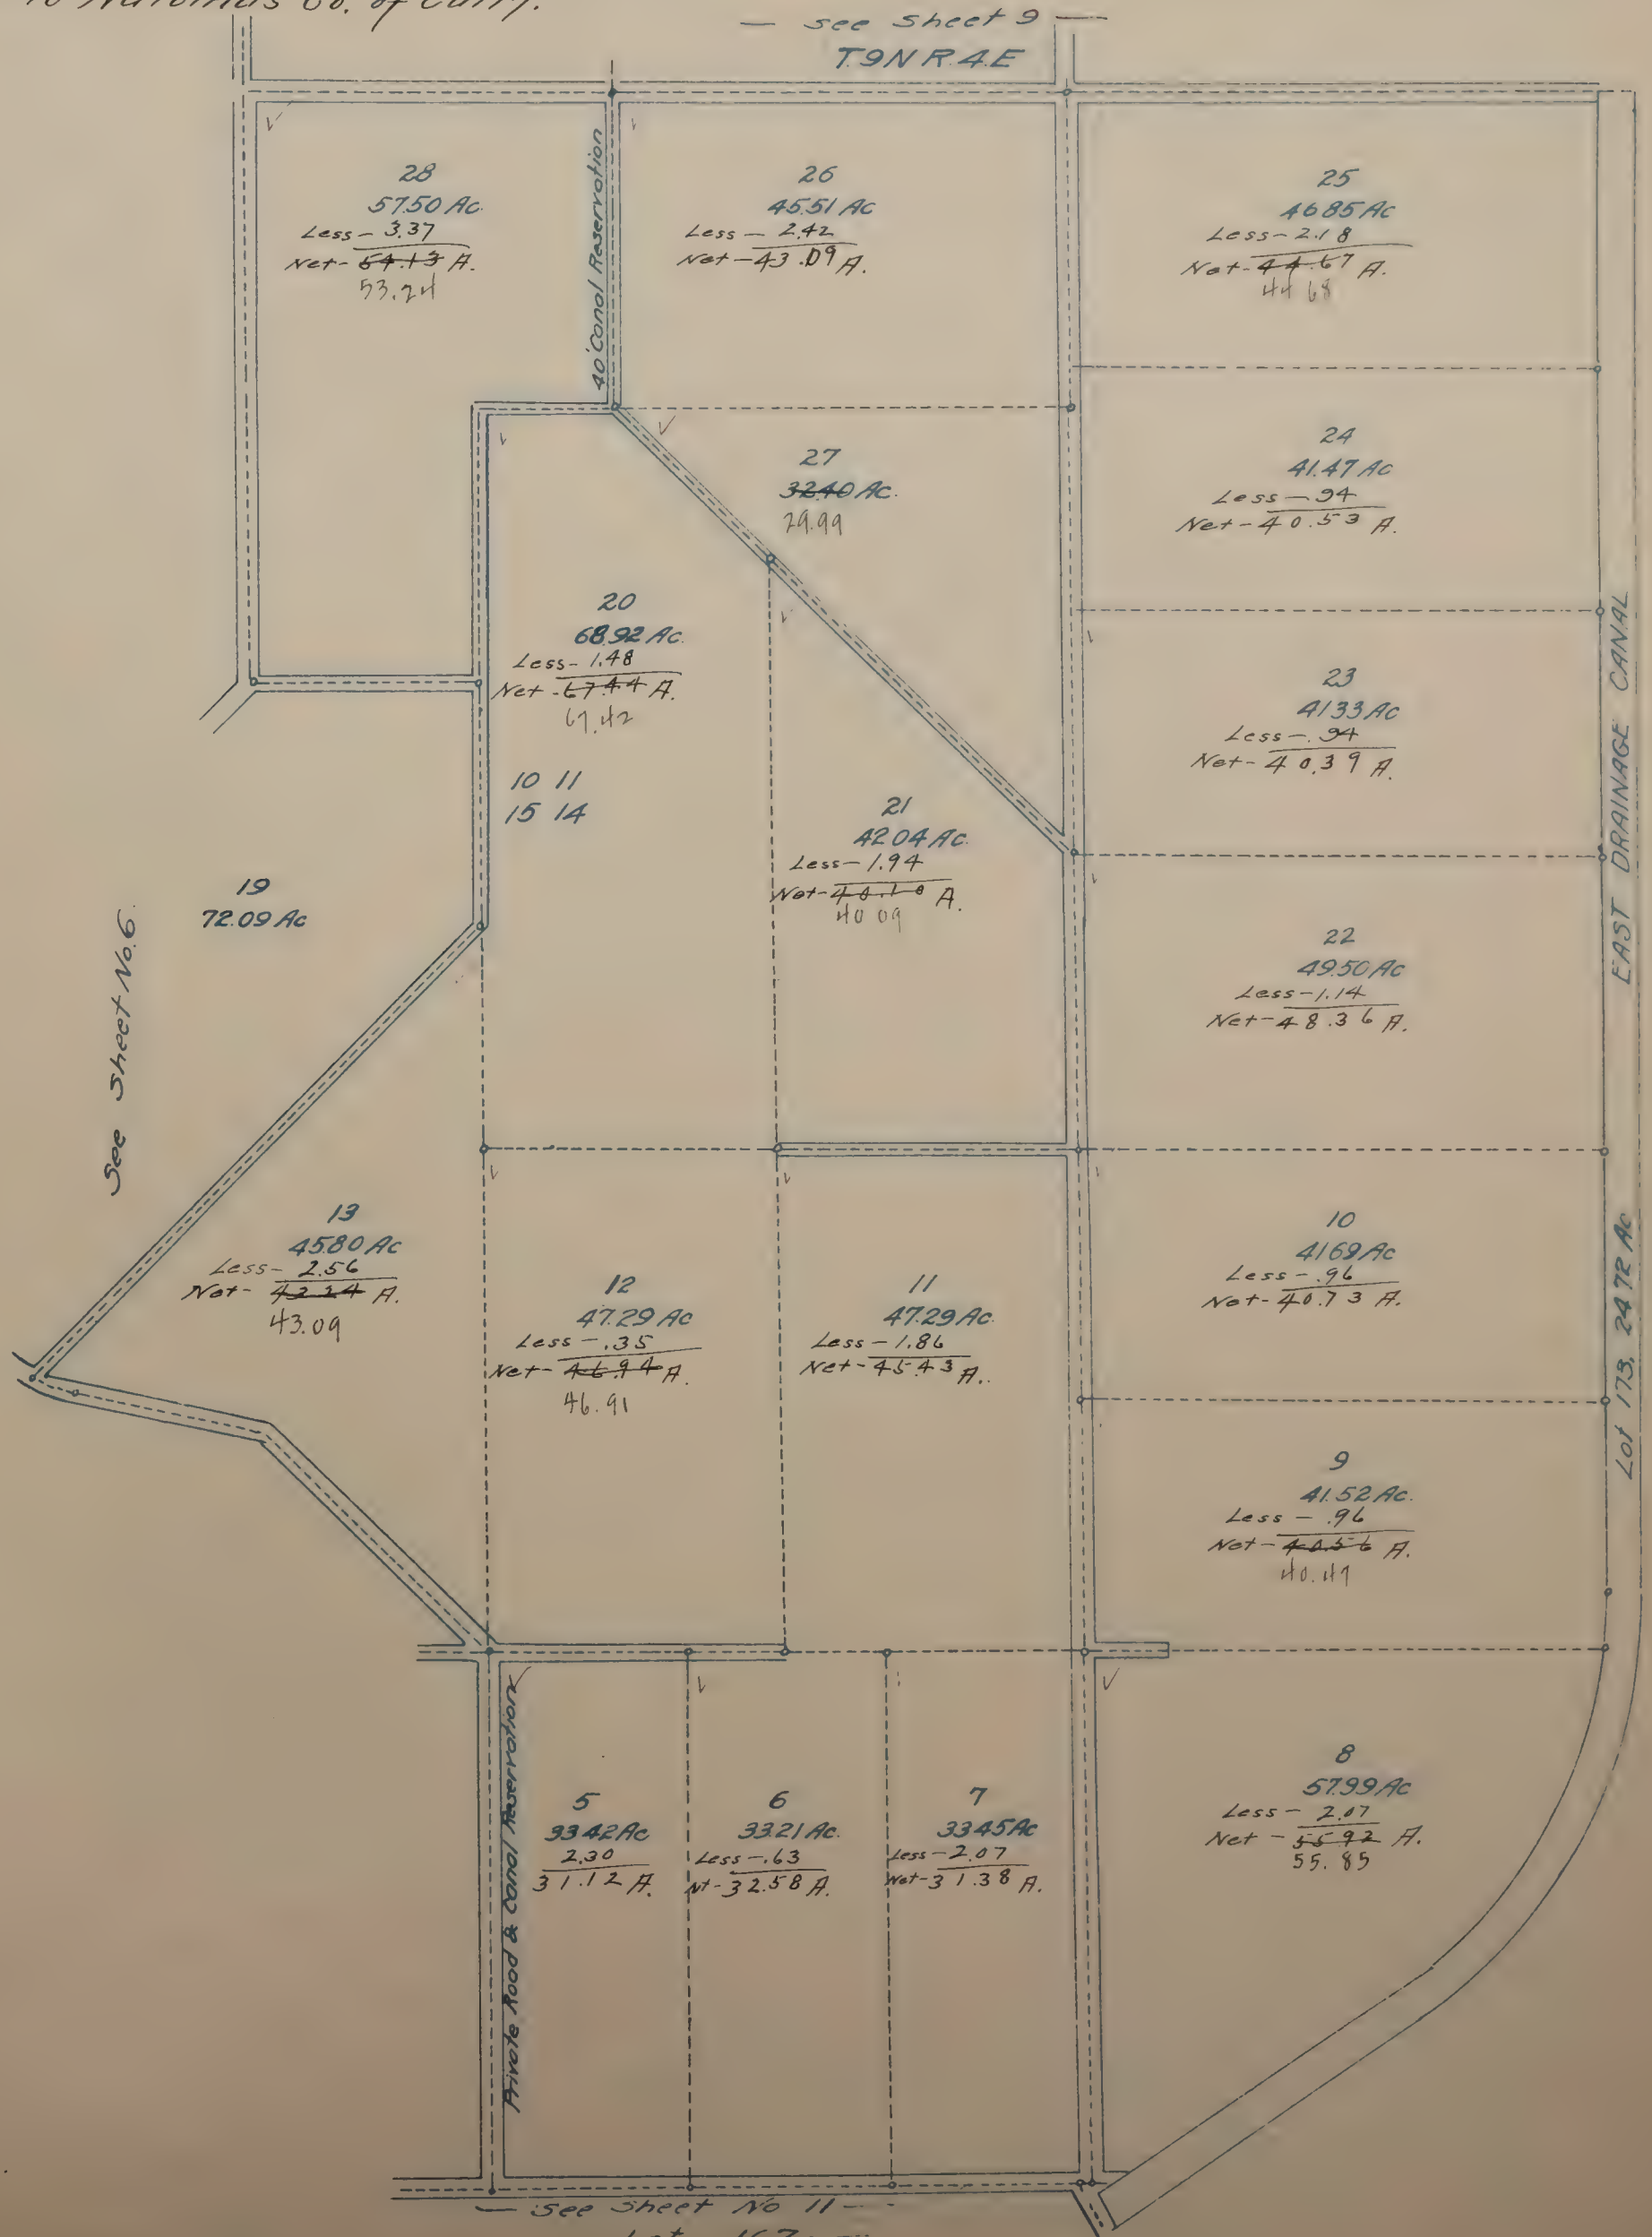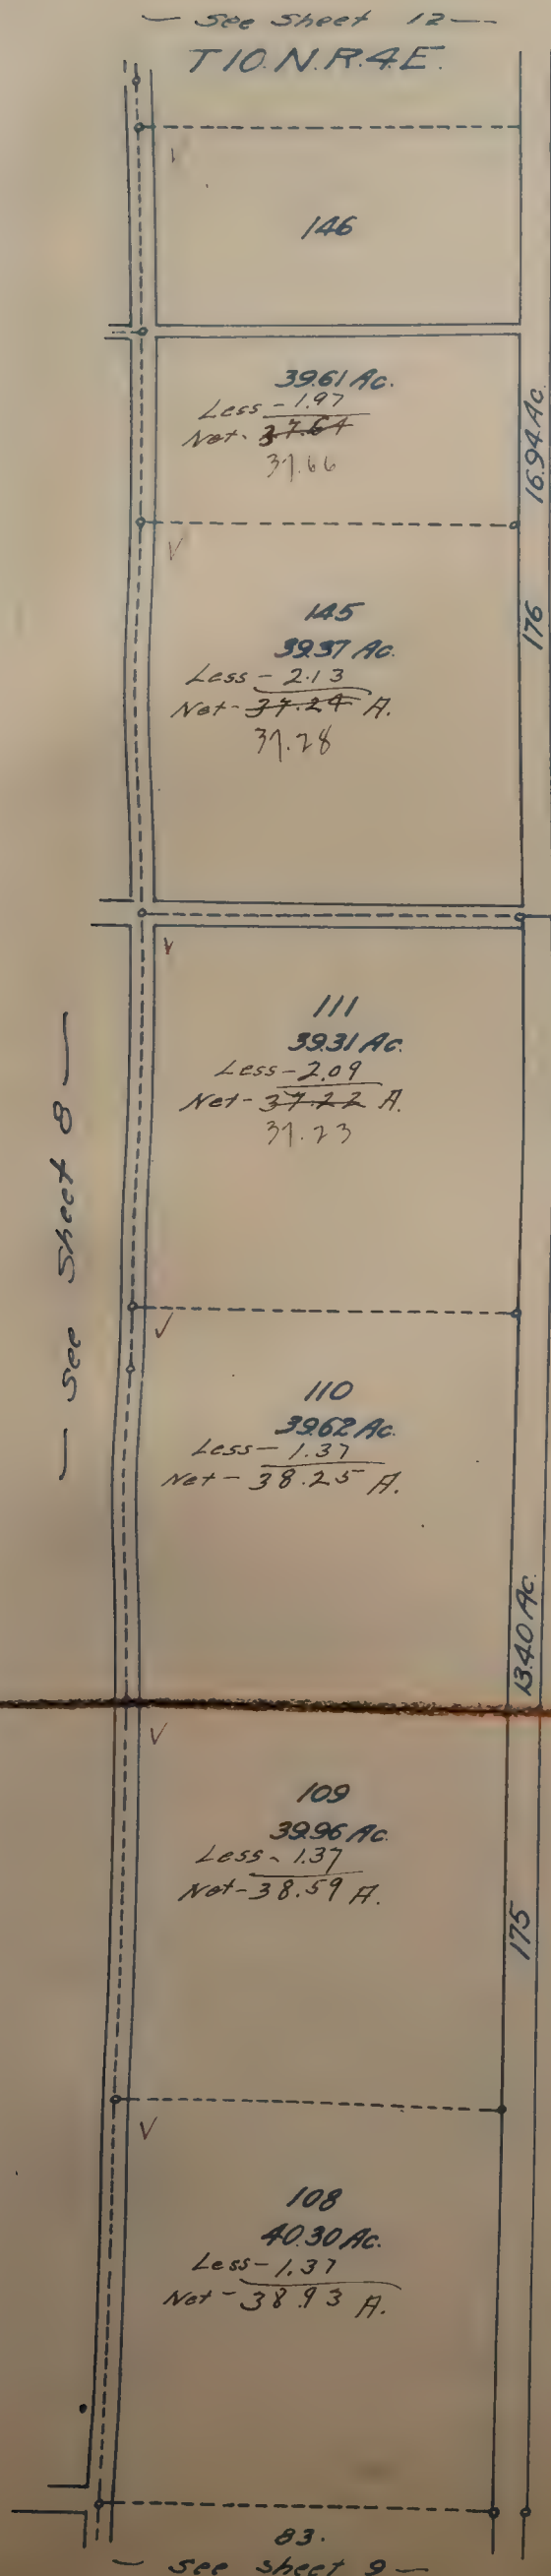

MAP OF
NATOMAS CENTRAL SUBDIVISION
IN
T9NR4E.

Jefferson S.D.

See sheet 10.

13 14
22 23

Lot 167, NATOMAS CENTRAL SUBDIVISION

WEST DRAINAGE CANAL

EAST CANAL

Lot 172

120 52 A.

Geo. D. Jones.
5.19 A.

NATOMAS RIVERSIDE SUBDIVISION No 2

DRAINAGE CANAL
Lot 165 Total 59.29 Ac.

NATOMAS COMPANY OF CALIFORNIA


1000

No

RECL. DIST.

MAP OF
NATOMAS CENTRAL SUBDIVISION ✓
IN
TIONRAE

Lincoln S.D.

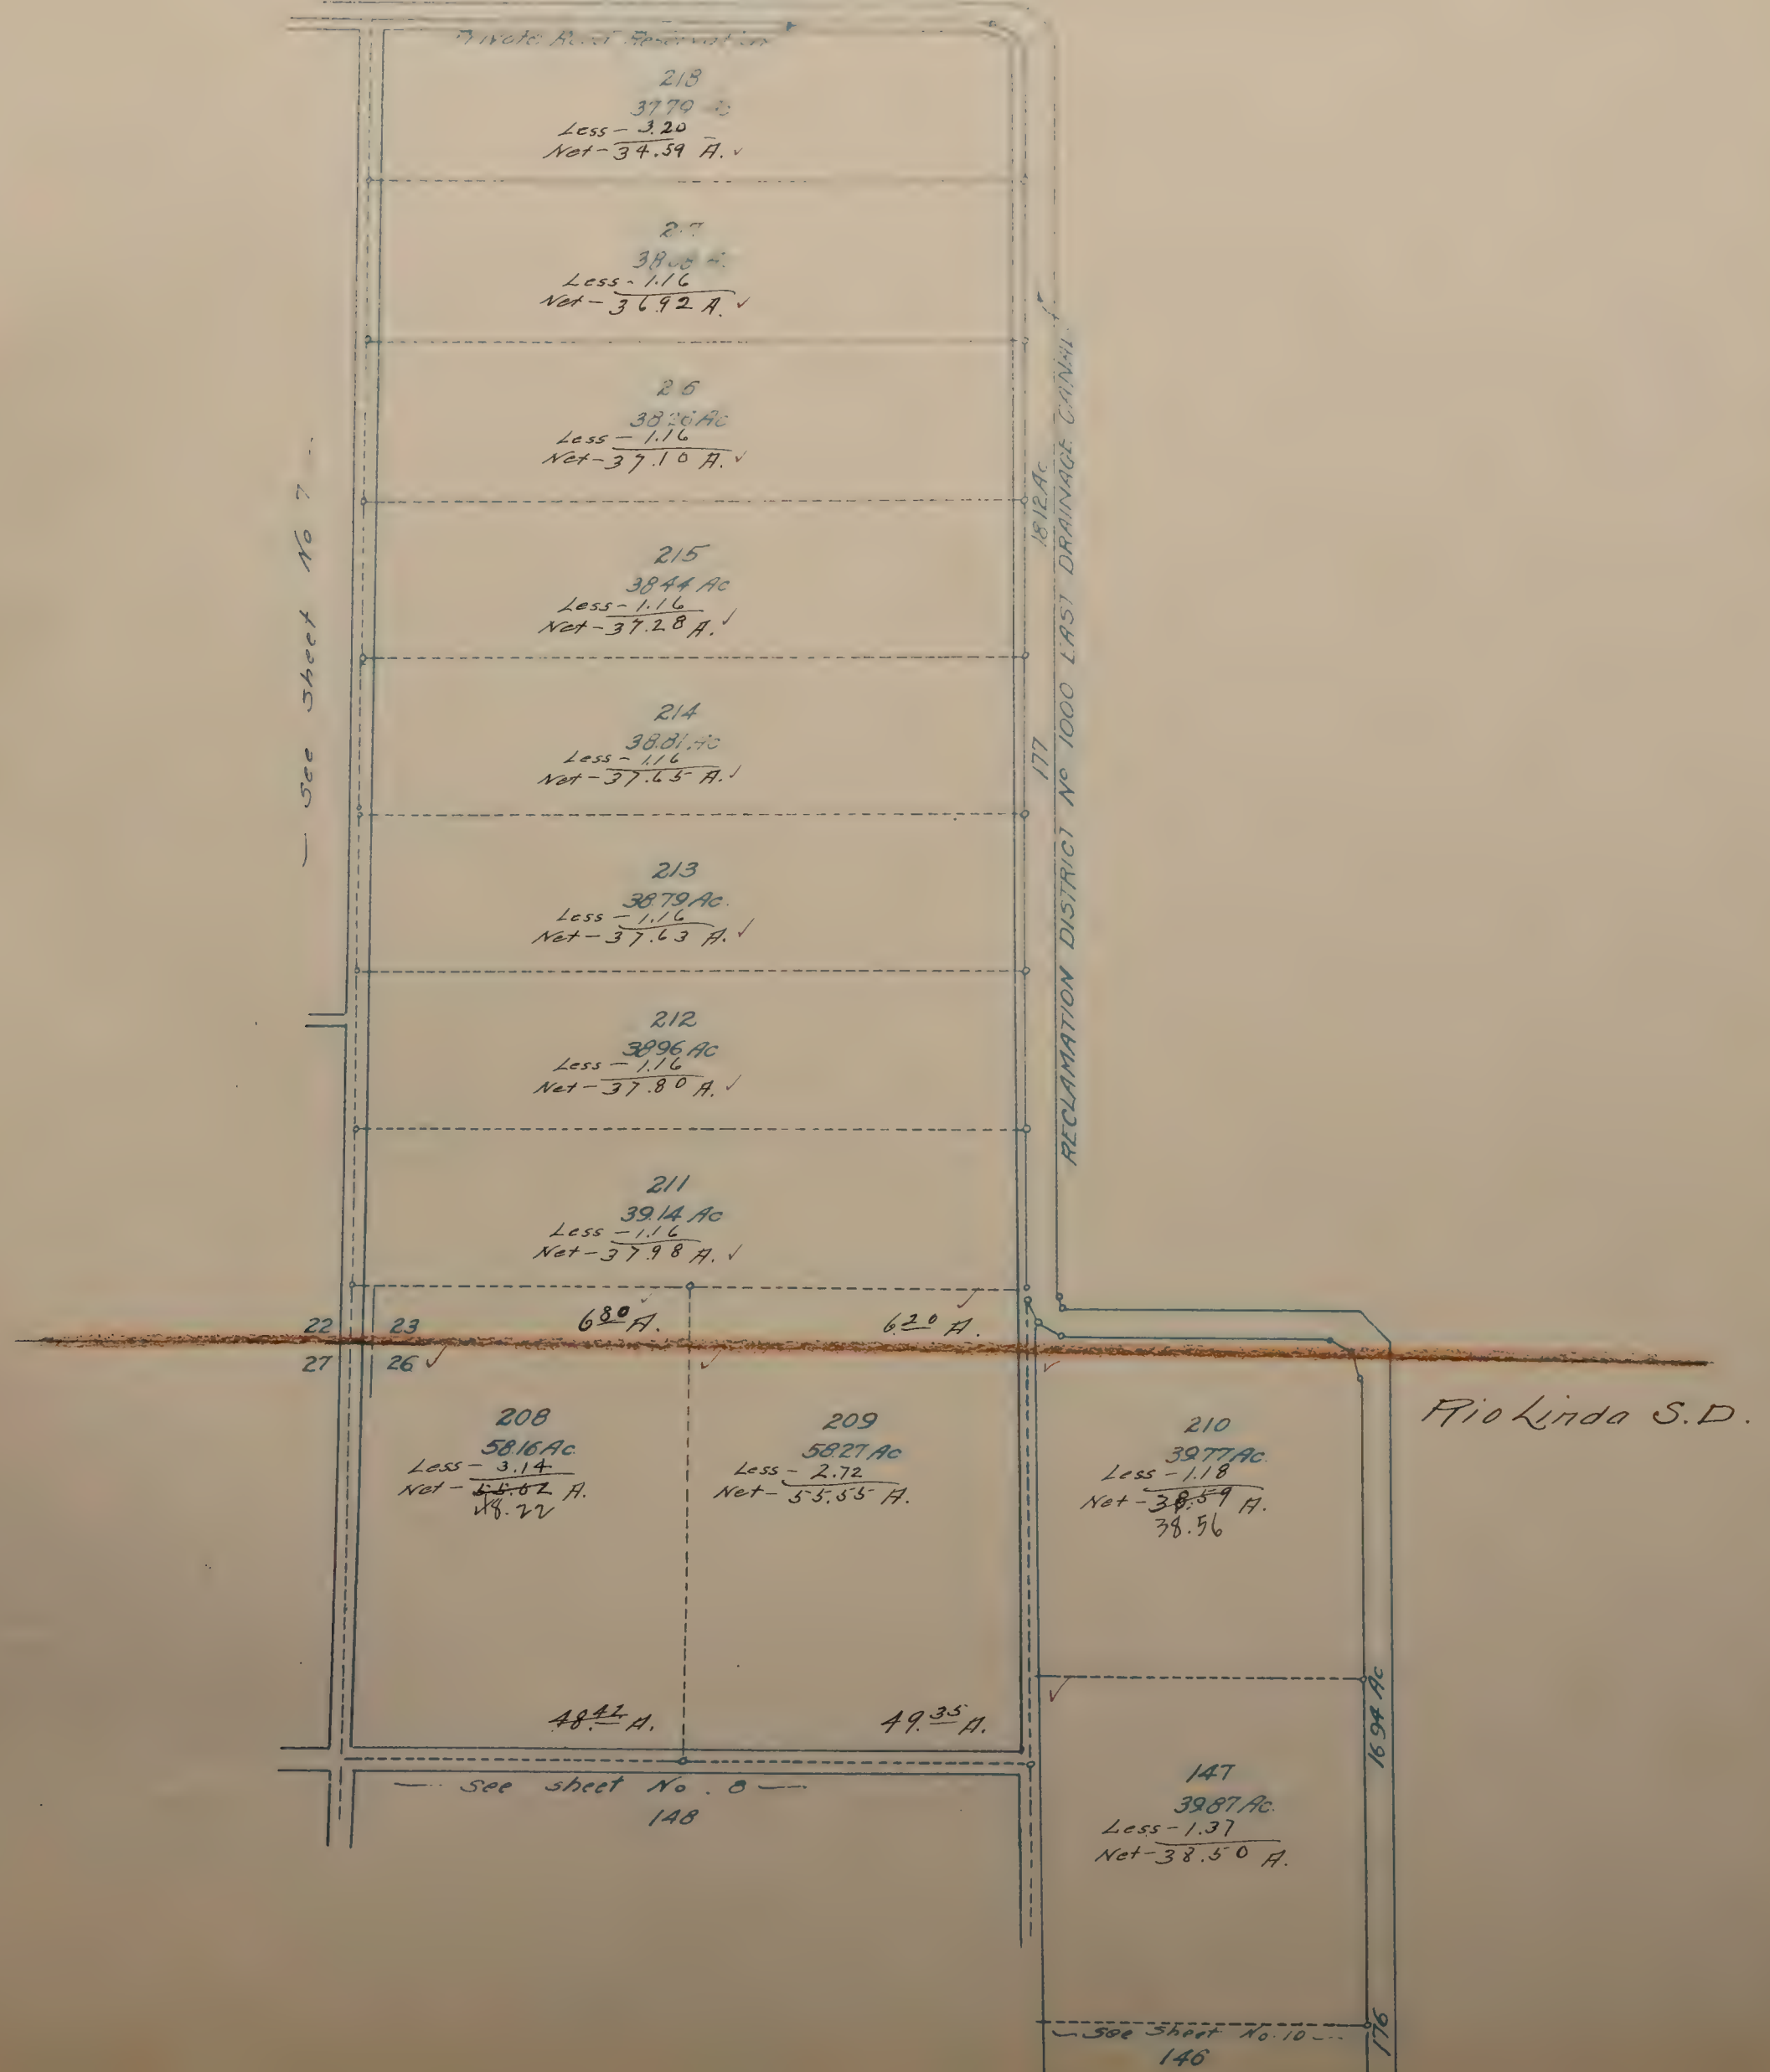


being a portion of Rancho Rio De Los Americanos.
Scale: 1"=800'

Kirksey 5.12

All Blanks to Natomas Co. of Calif.

All Lots 10 Hcs. unless otherwise noted.

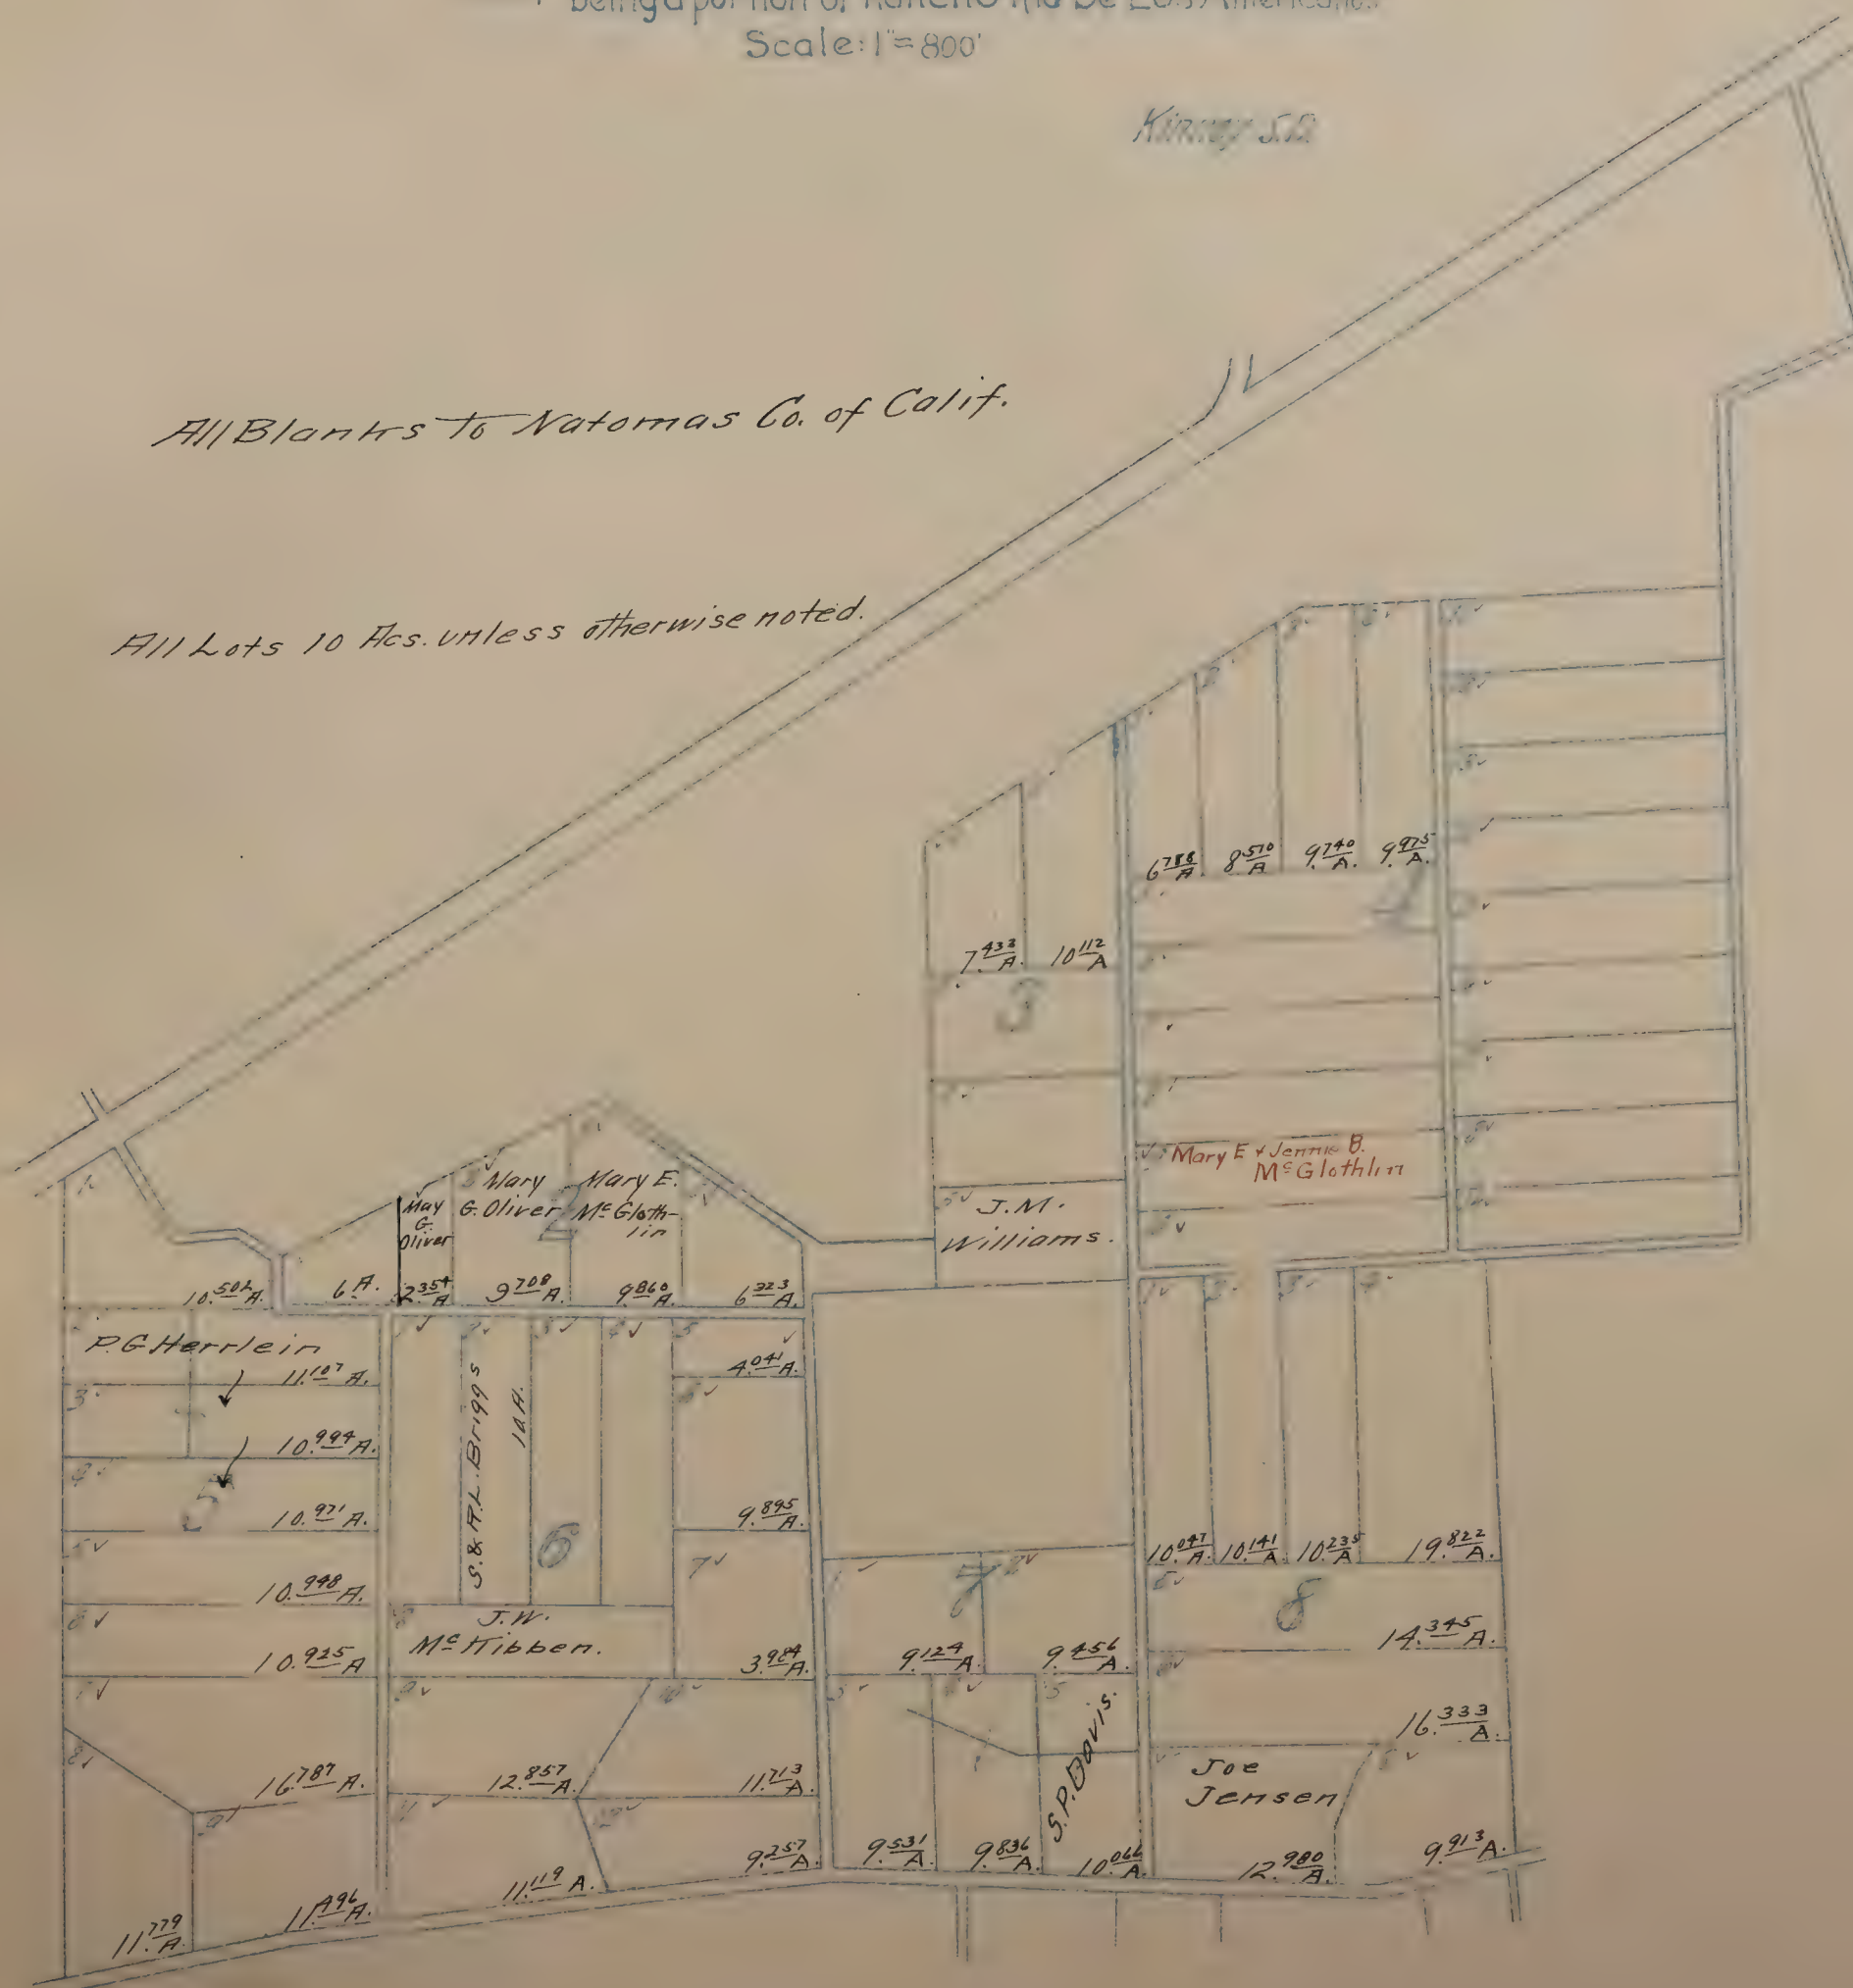

NATOMAS CONSOLIDATED ✓ OF CALIFORNIA

SUBDIVISION NO. 2

being a portion of Rancho Rio De Los Americanos

Scale: 1" = 800'

Kinney S.D.

All Blanks To Natomas Co. of Calif.

*All Lots 9.986 Acs. unless
otherwise noted.*



NATOMAS EAST SIDE SUBDIVISION ✓

SACRAMENTO COUNTY CAL.

Scale: 1 inch = 600 feet


Sheet 1 of 6 Sheets

LINCOLN - S.D.

NATOMAS GOODLAND SUBDIVISION

T. 10 N. R. 4 E.

D. A. PROCTOR

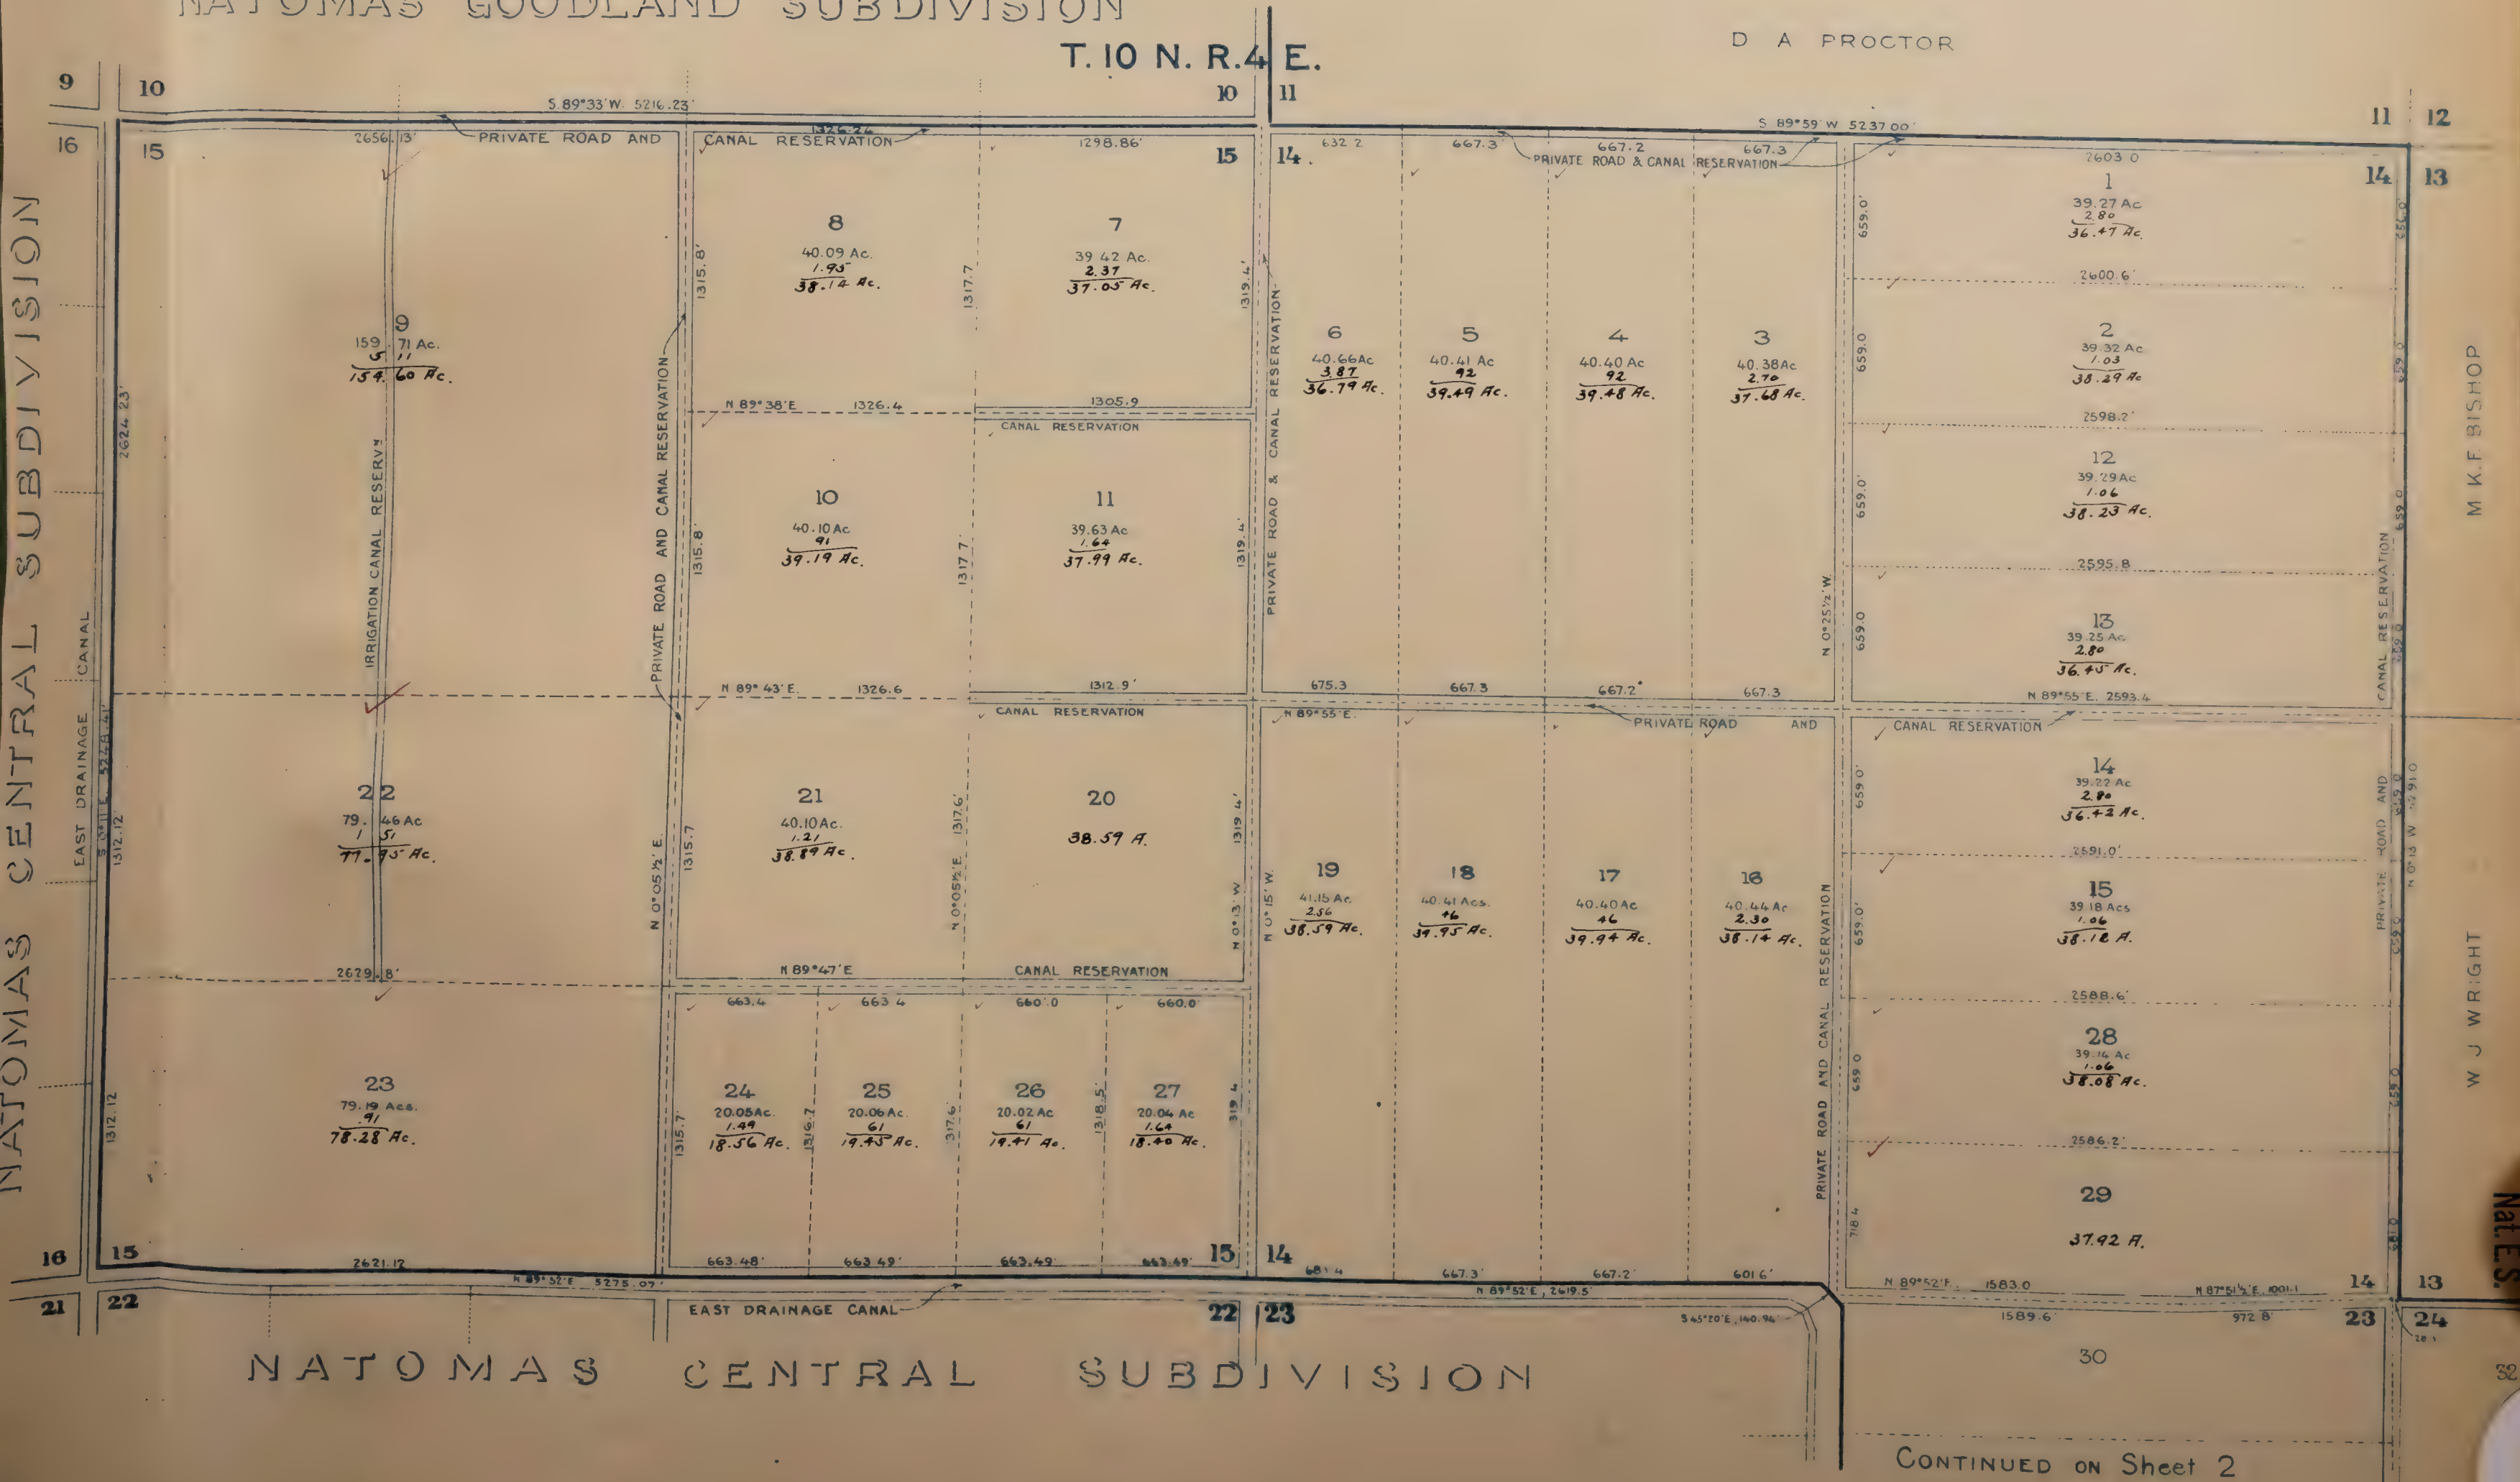

NATOMAS CENTRAL
SUBDIVISION

Scale: 1 inch = 600 feet

Sheet 2 of 6 Sheets

SEE

SHEET 1

W. J. WRIGHT

T. B. LEEPER




NATOMAS CENTRAL SUBDIVISION

NATOMAS EAST SIDE SUBDIVISION

SACRAMENTO COUNTY, CAL.


Scale: 1 inch = 600 feet
Sheet 3 of 6 Sheets.

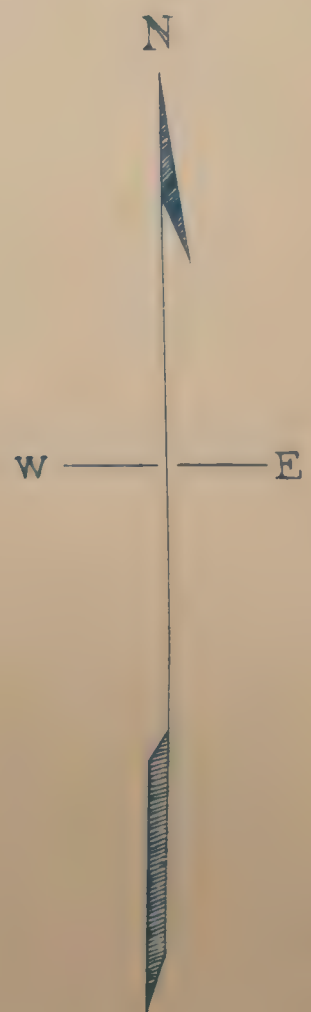

JEFFERSON S.D.

RIO LINDA S.D.

ROBLA S.D.

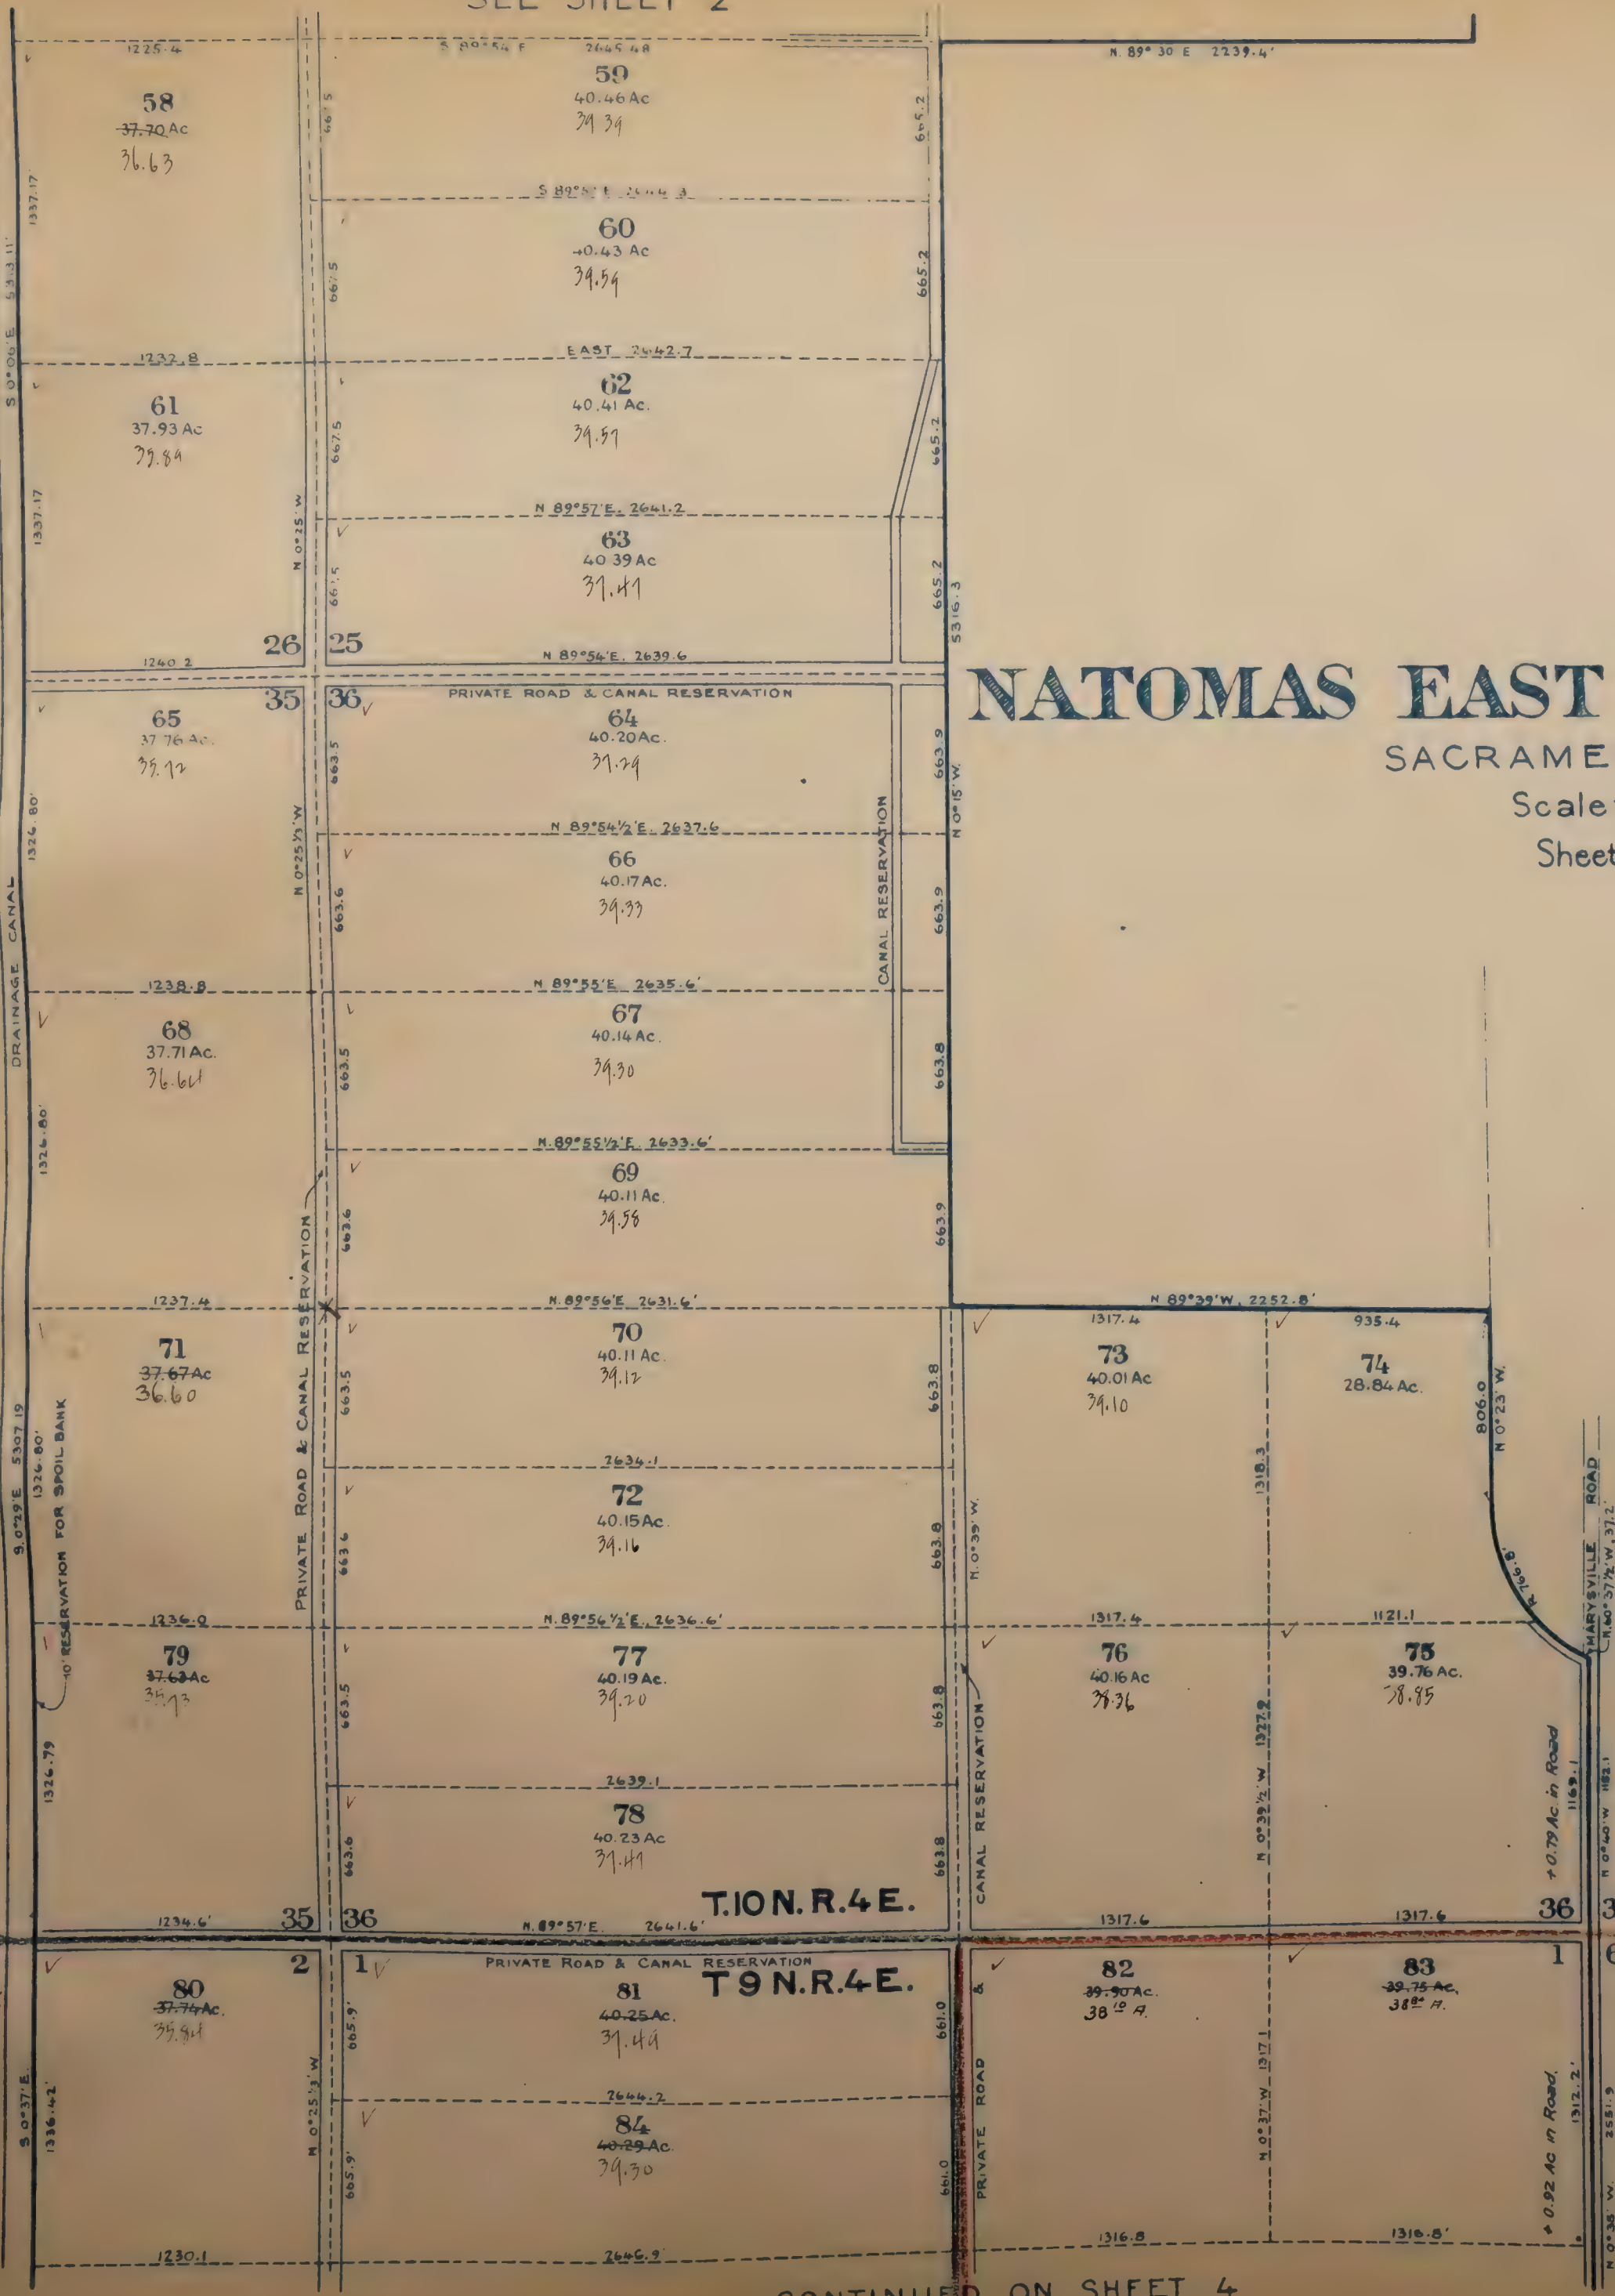

POBLA. S.D.

IN ATOMAS GENERAL SUBDIVISION



SEE SHEET 4


WITTENBROCK ESTATE COMPANY

NATOMAS EAST SIDE SUBDIVISION

SACRAMENTO COUNTY CAL.

Scale: 1 inch = 600 feet

Sheet 5 of 6 Sheets

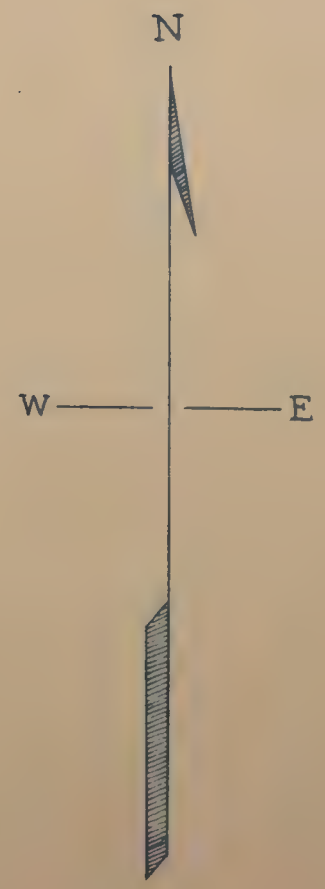

CHARLES E. MEISTER & WILLIAM H. STAFFORD

T. 9 N. R. 4 E

CENTRAL SUBDIVISION

NATOMAS

113
76.27 Ac.
72.81

114
74.88 Ac.
73.51

115
108.81 Ac.
106.15

117
56.51 Ac.

M. M. Azevedo

118
30.00 Ac.

J. W. L. Batchelder
S. E. LACAIR

119
42.51 Ac.

SEE NEXT PLAT

120
42.50 Ac.
42.02

NATOMAS ELKHORN SUBDIVISION ✓

Secs. 12, 13, 23, 24, 25, 26, 35, 36, T10N, R3E - Secs. 1, 2, T9N, R3E.


Secs. 7, 18, 19, 20, 29, 30, 31, 32, T10N, R4E - Secs. 5, 6, T9N, R4E.

Scale:- 1 in = 600 feet.

SHEET 1

All Blanks to Natomas Co. of Calif.

American Basin S.D.

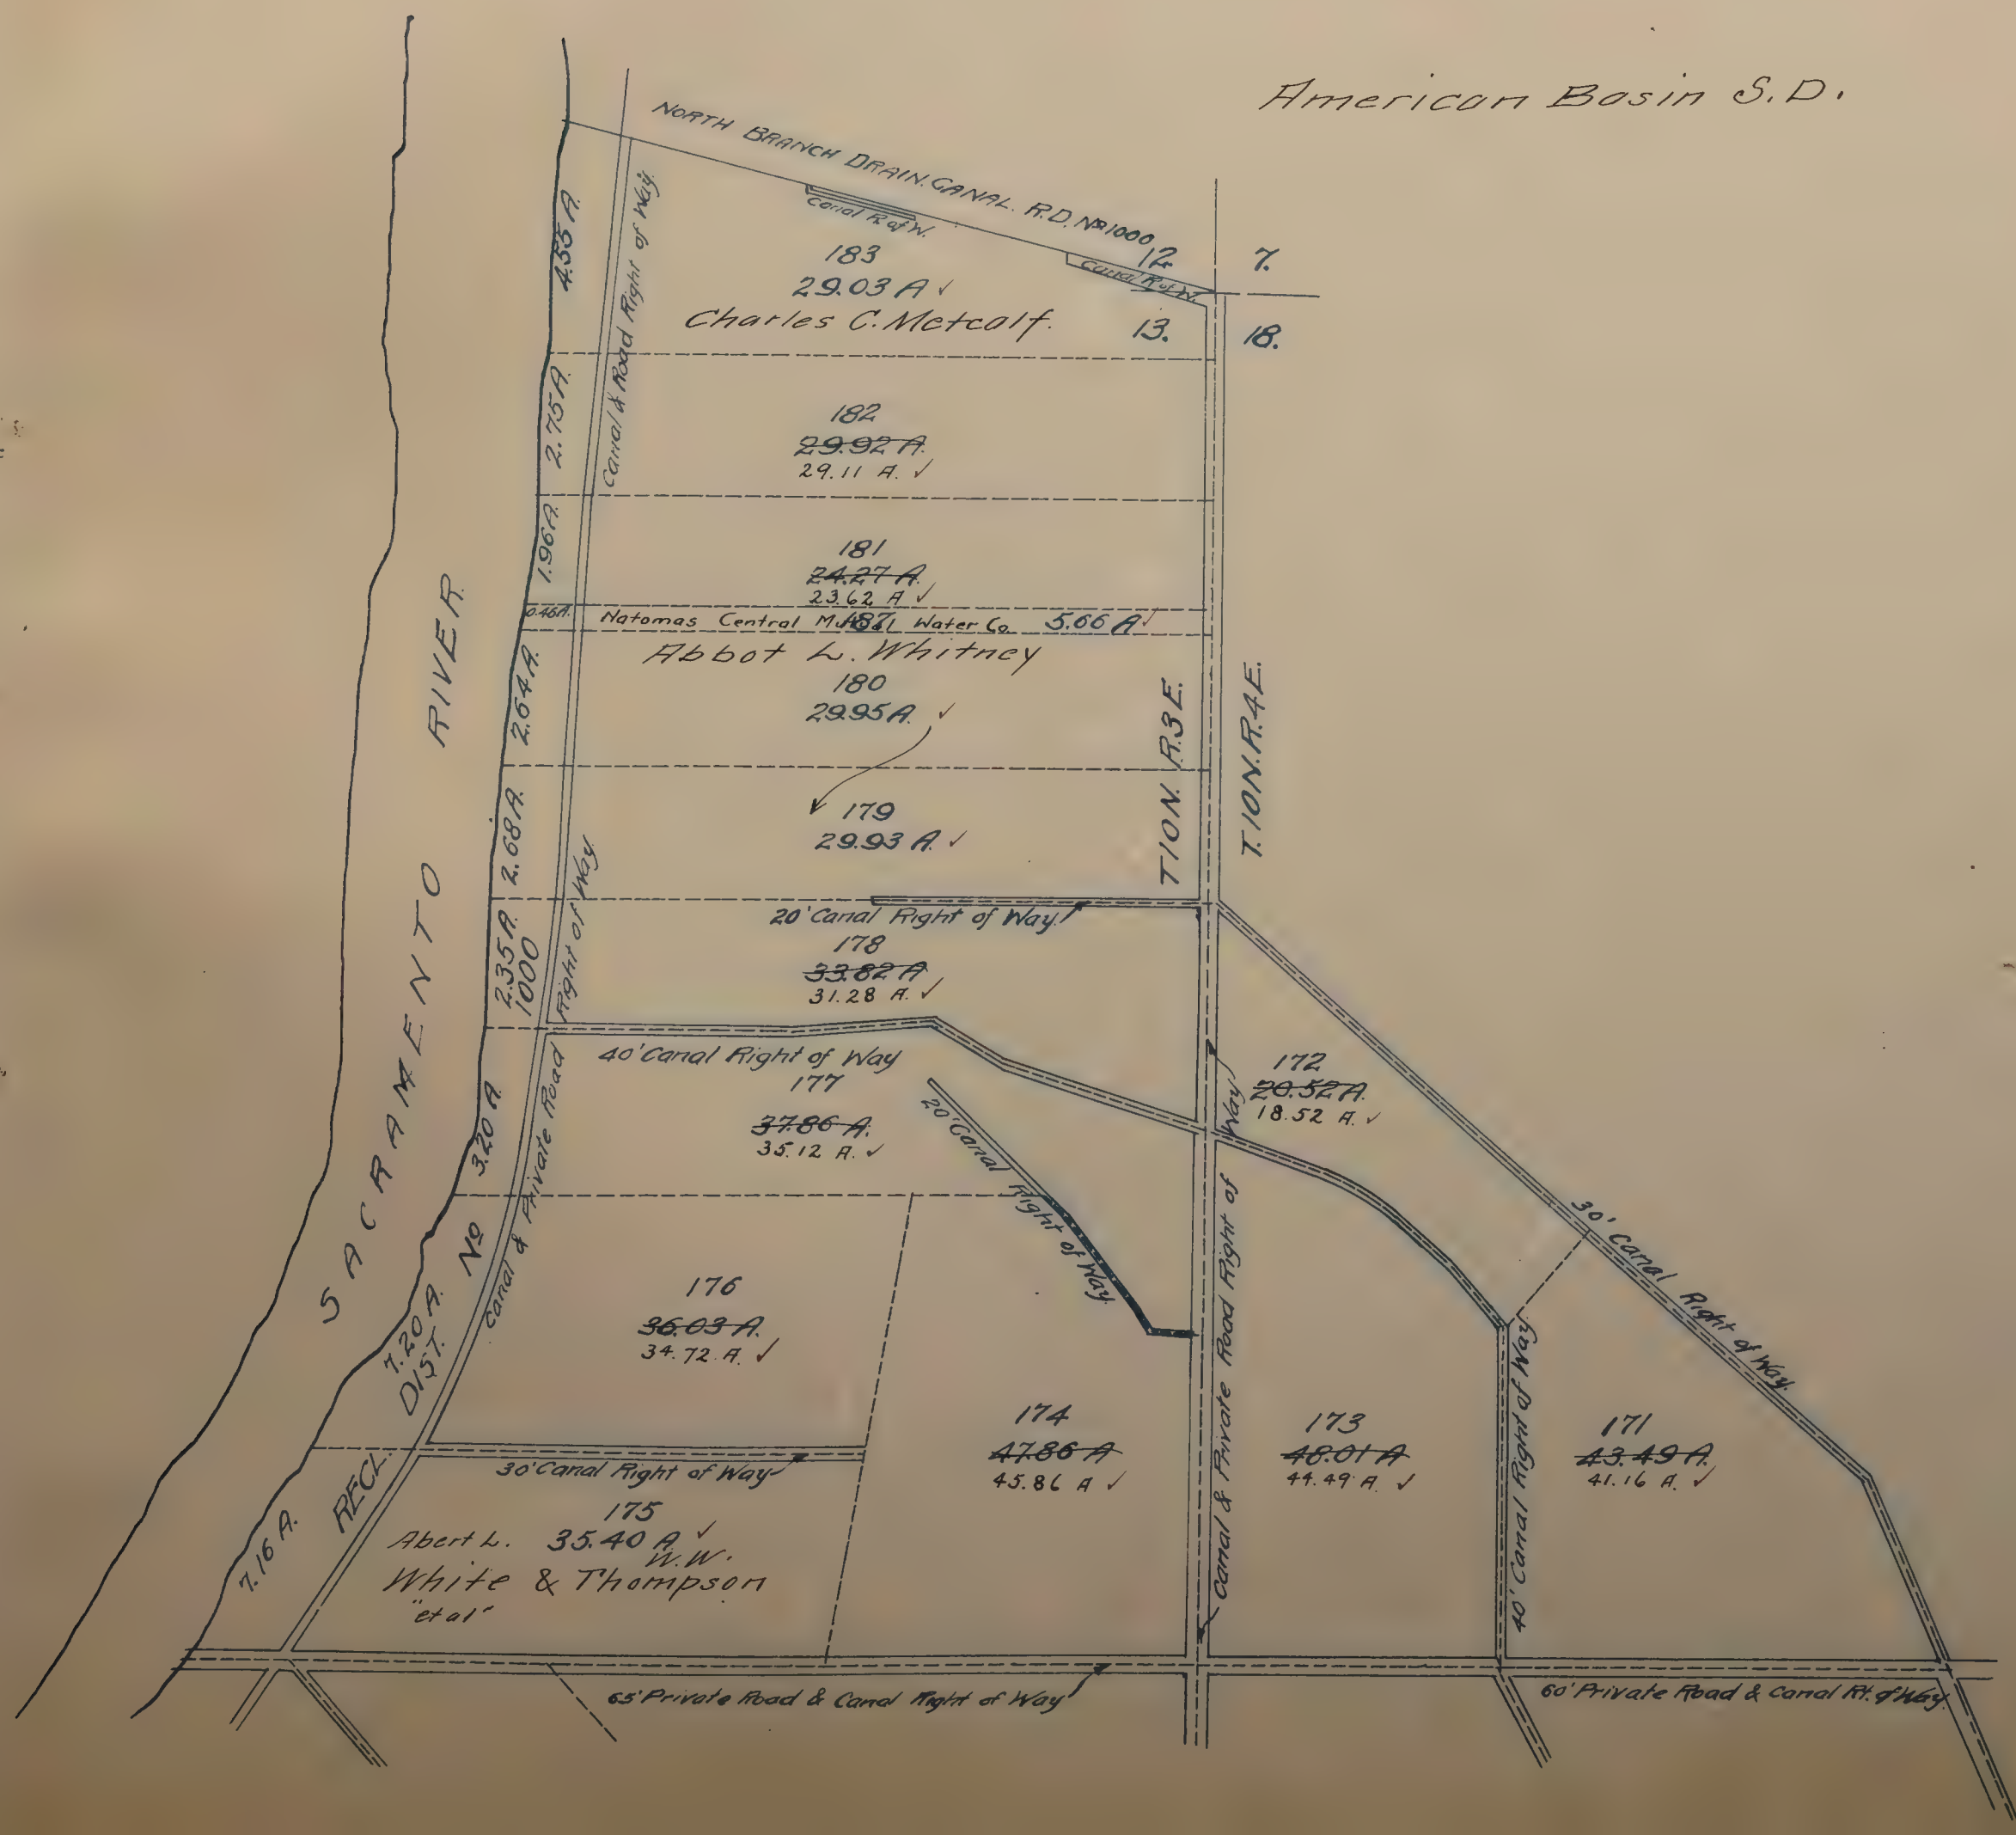

NATOMAS ELKHORN SUBDIVISION ✓


Secs. 12, 13, 23, 24, 25, 26, 35, 36, T10N, R3E - Secs. 1, 2, T9N, R3E.

Secs. 7, 18, 19, 20, 29, 30, 31, 32, T10N R4E - Secs. 5, 6, T9N, R4E.

Scale:- 1 in = 600 feet.

SHEET 2.

American Basin S. D.

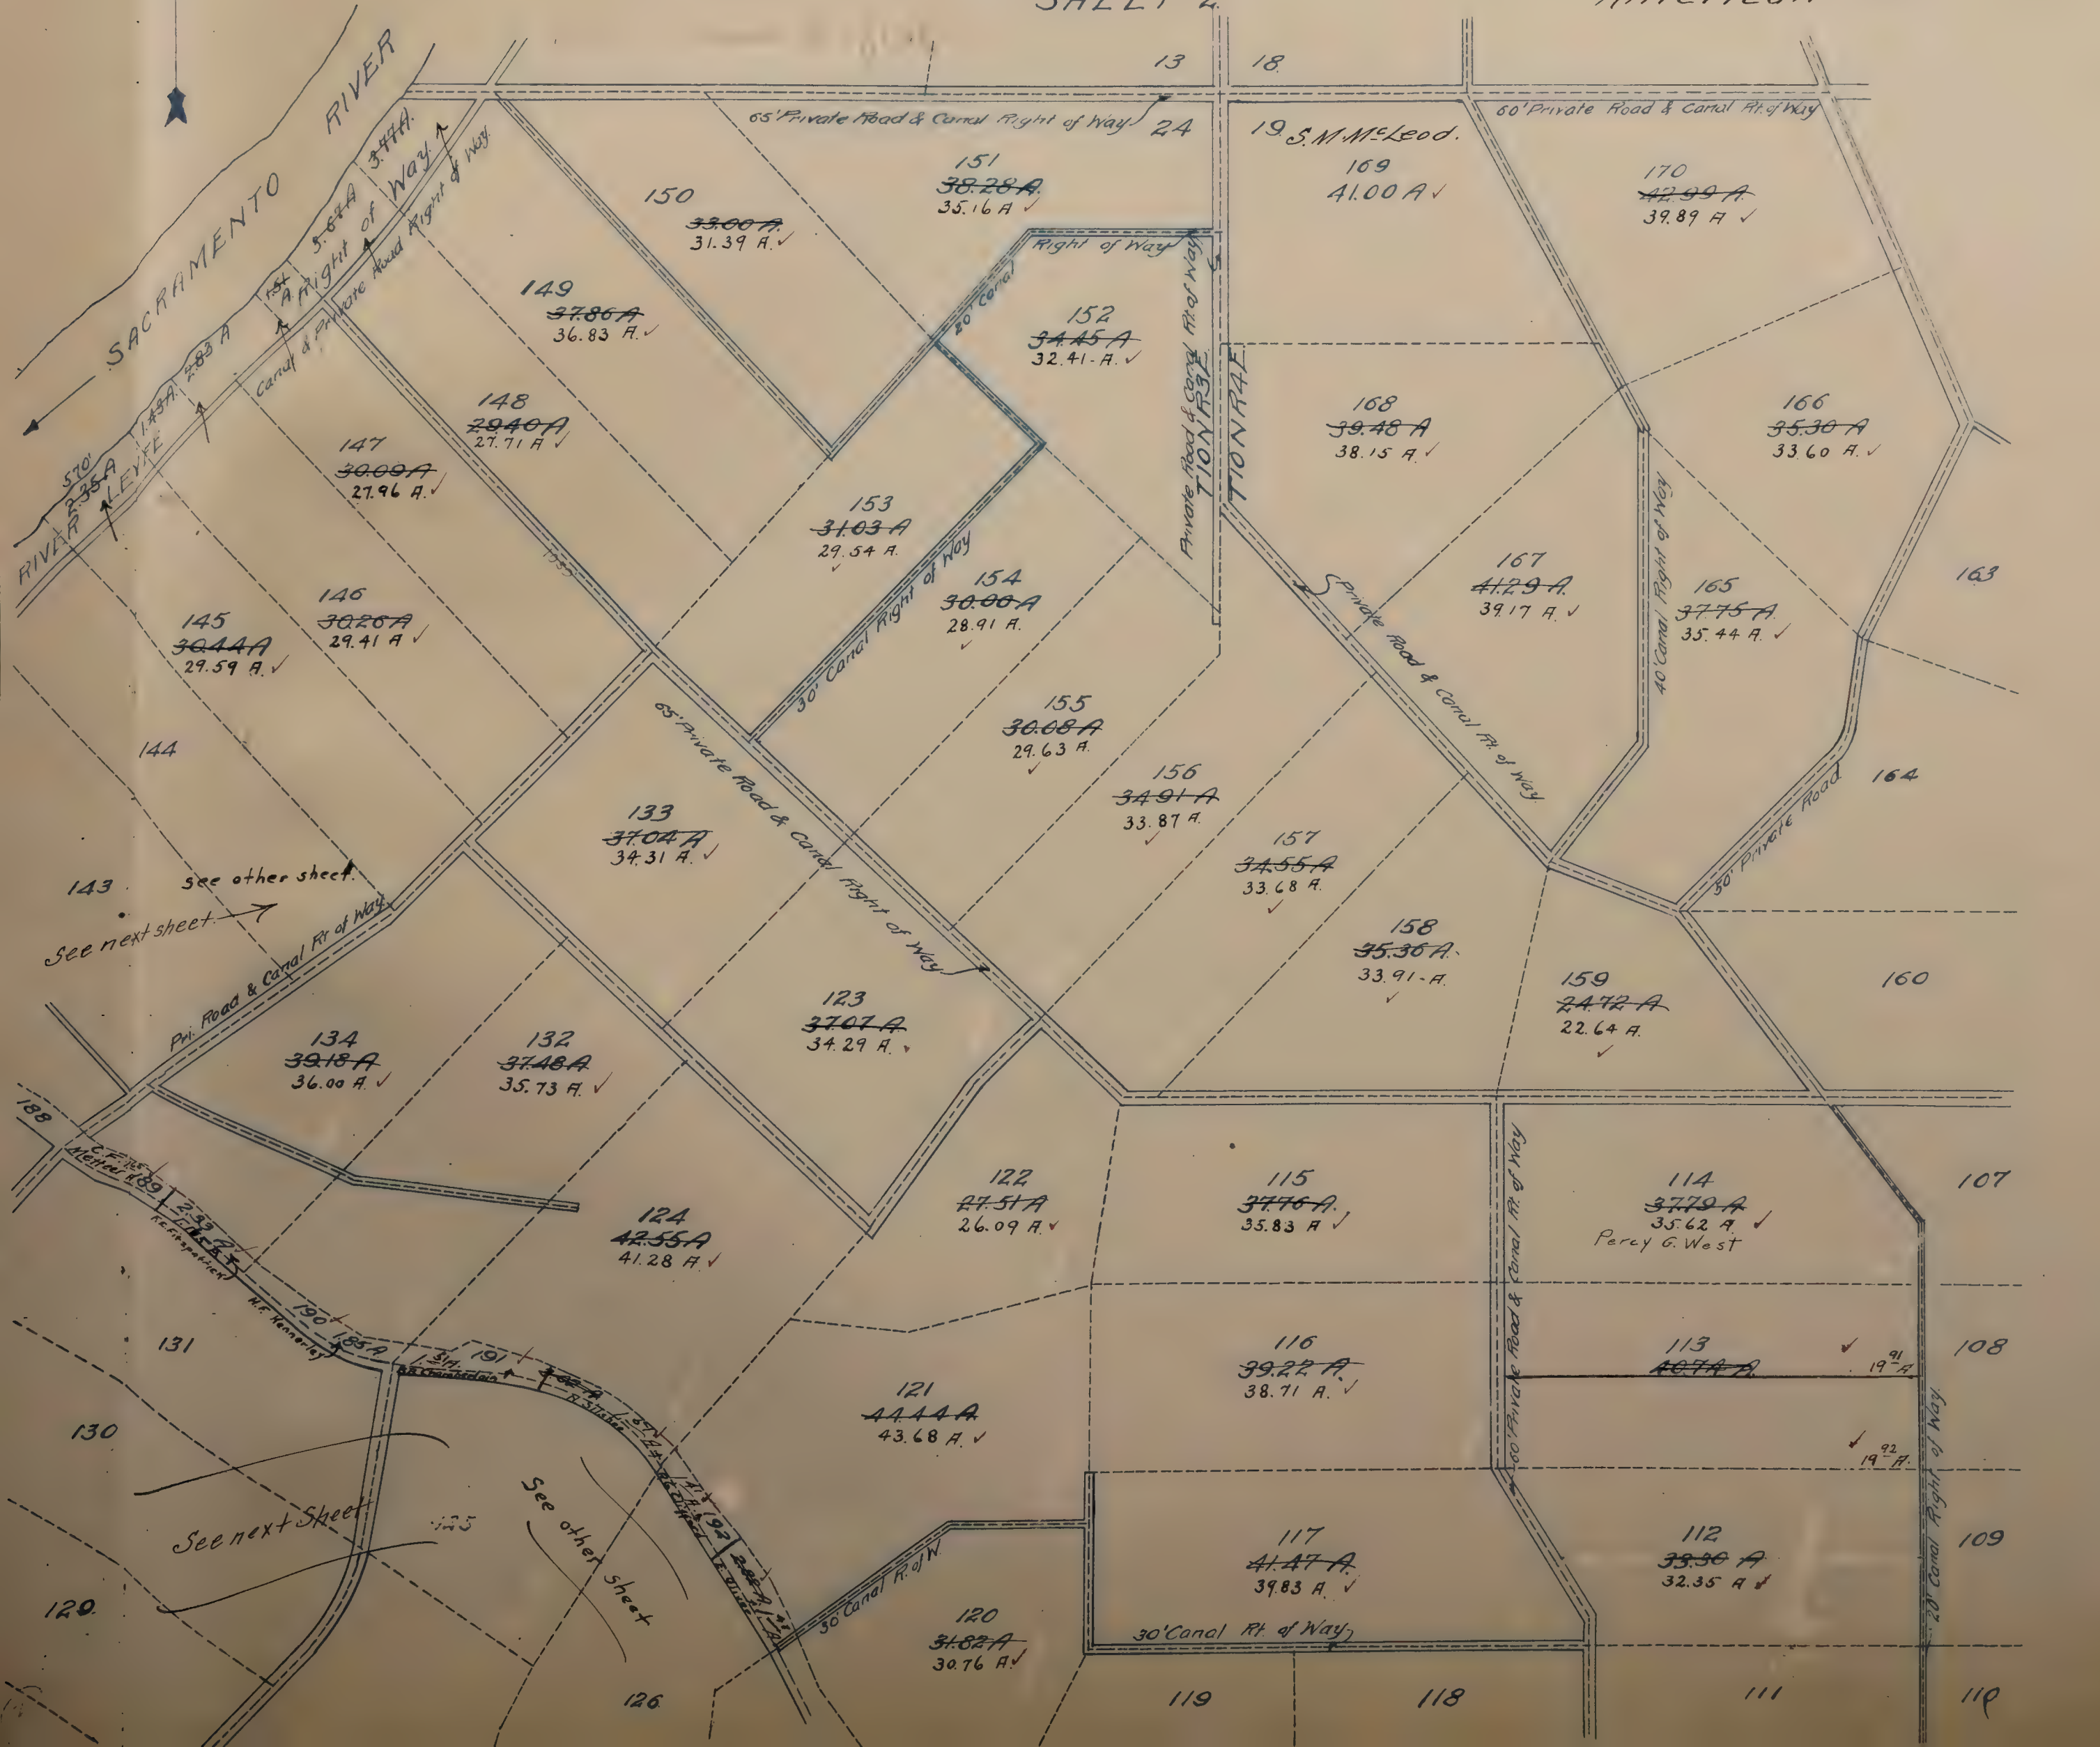


NATOMAS ELKHORN SUBDIVISION ✓

SECS. 12, 13, 23, 24, 25, 26, 35, 36, T10N, R3E - SECS. 1, 2, T9N, R3E

Secs. 7, 18, 19, 20, 29, 30, 31, 32 T10N, R4E - Secs. 5, 6, T9N, R4E.

Scale:- 1 in. = 600 feet.

SHEET 3.

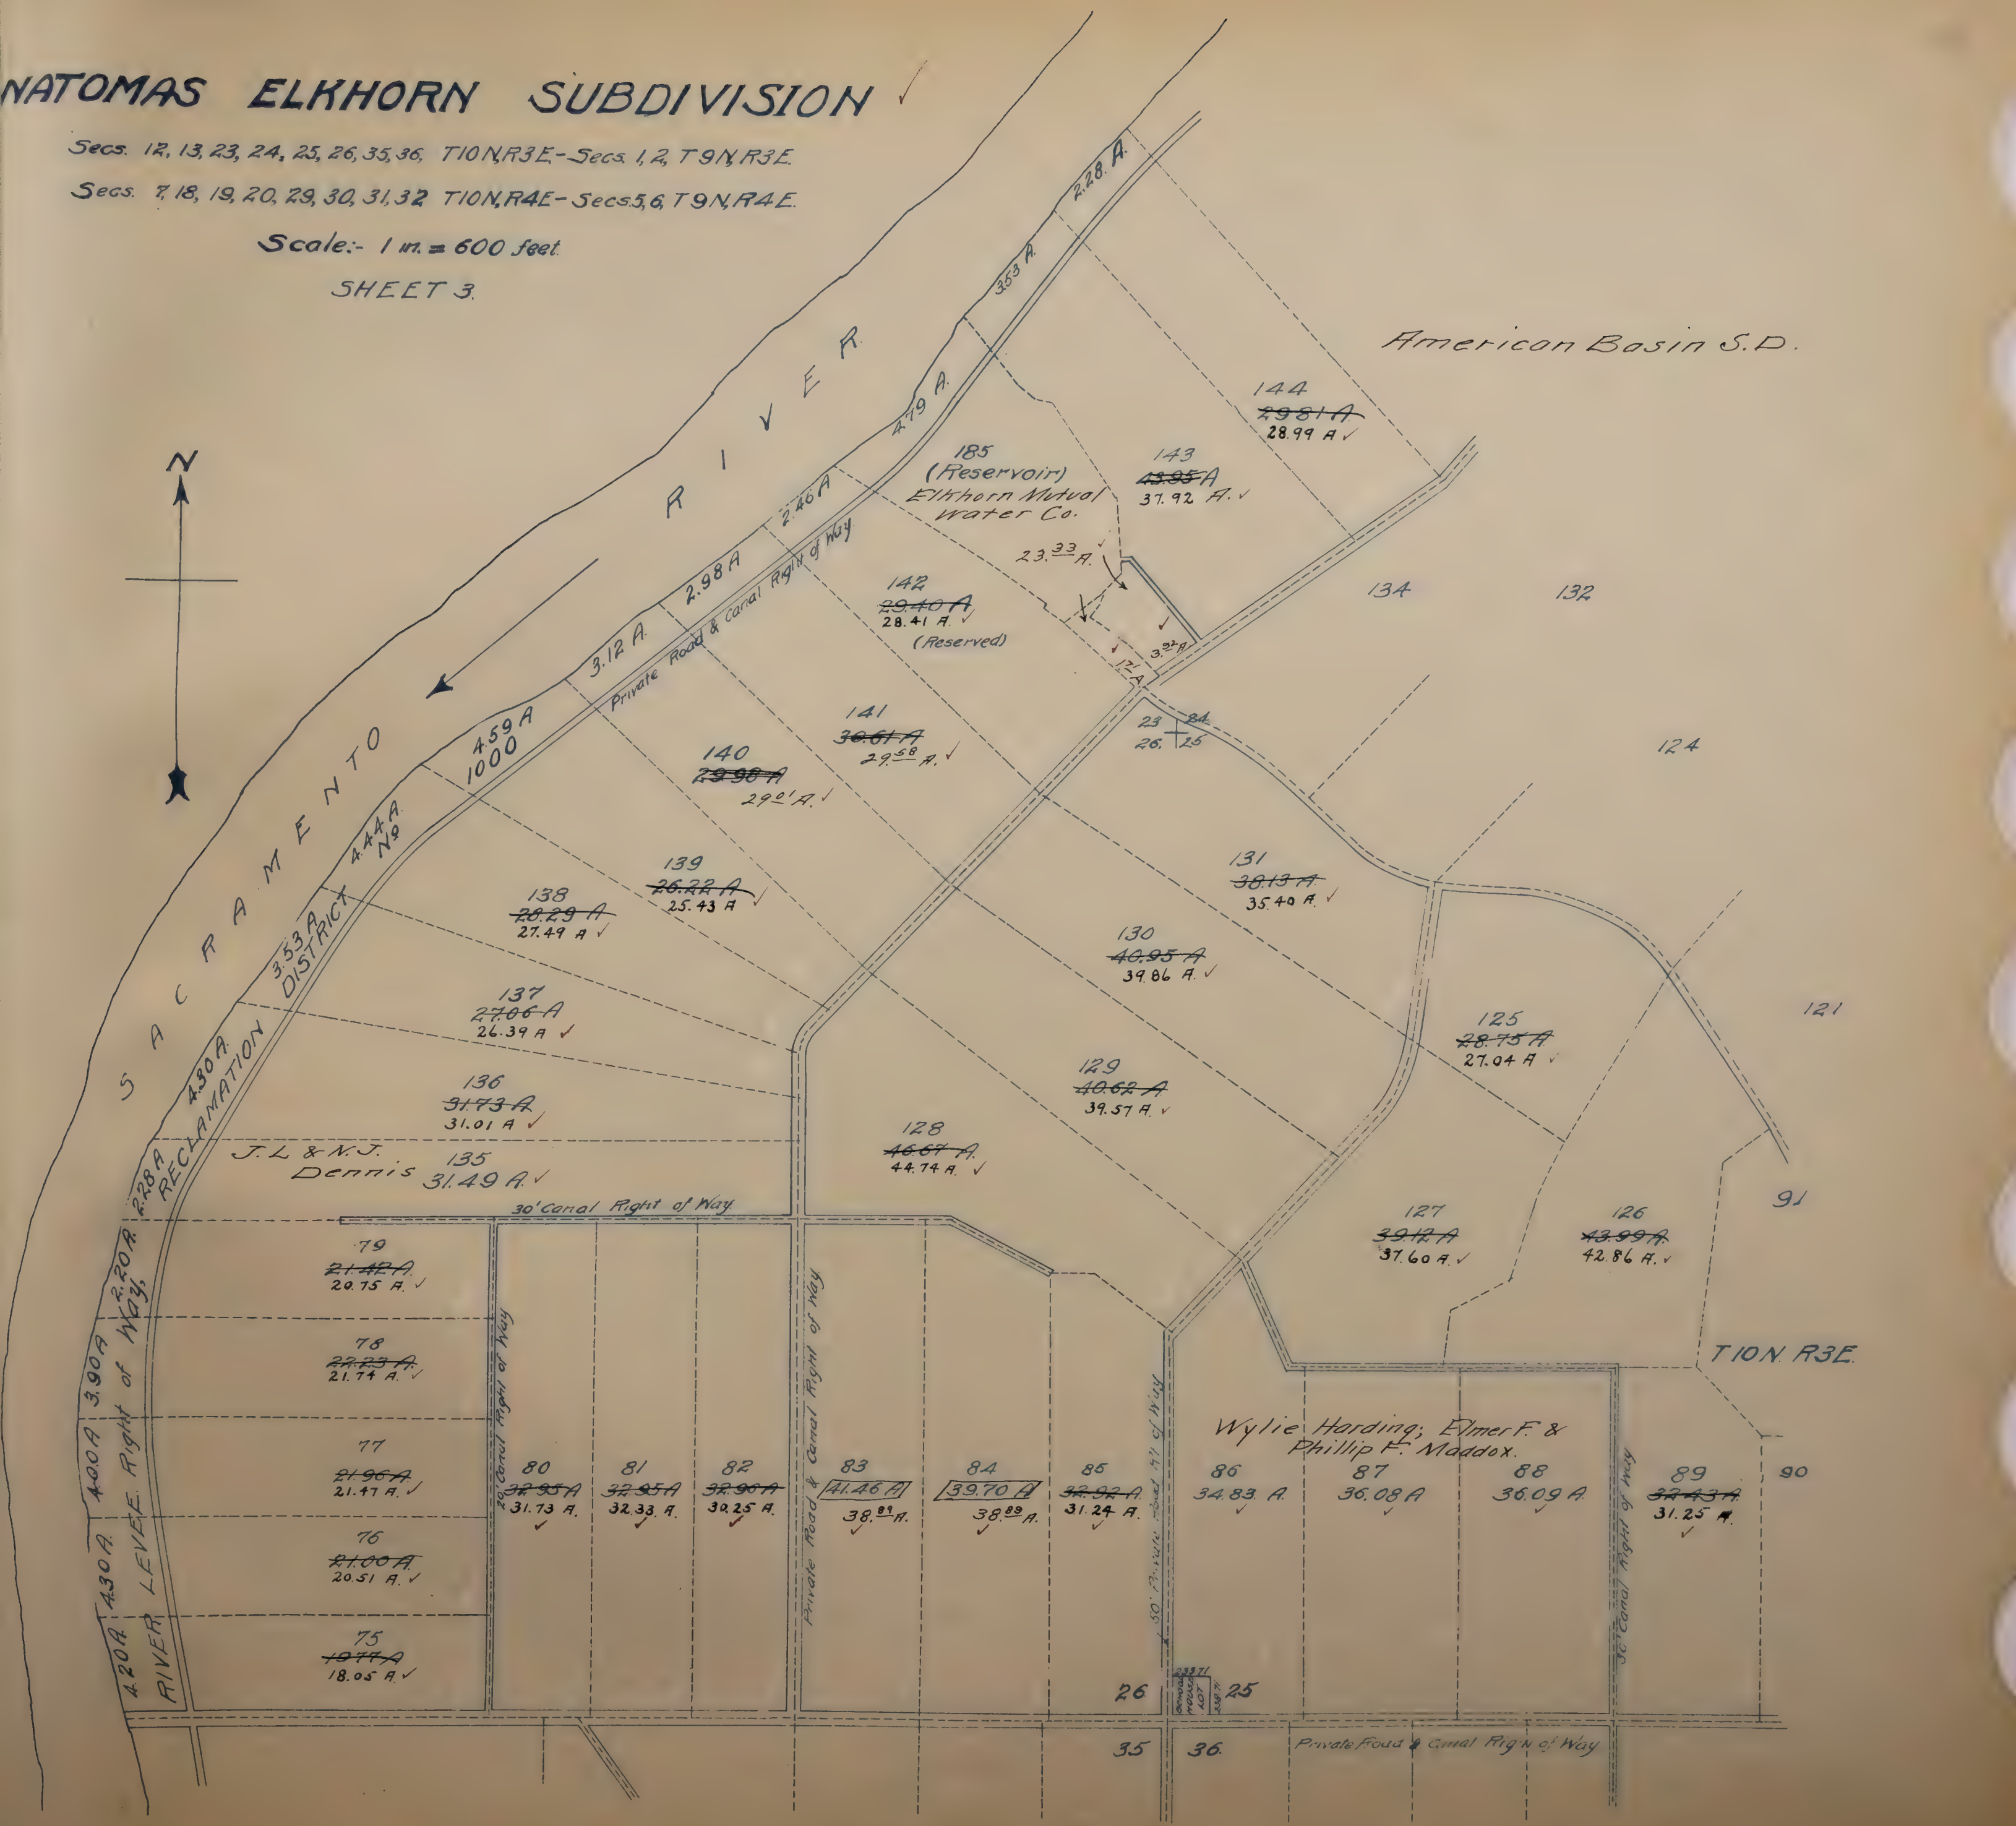


NATOMAS ELKHORN SUBDIVISION


Secs. 12, 13, 23, 24, 25, 26, 35, 36, T10N, R3E - Secs. 1, 2, T9N, R3E.

Secs. 7, 18, 19, 20, 29, 30, 31, 32 T10N, R4E - Secs. 5, 6, T9N, R4E.

Scale:- 1 in. = 600 feet.

SHEET 3.

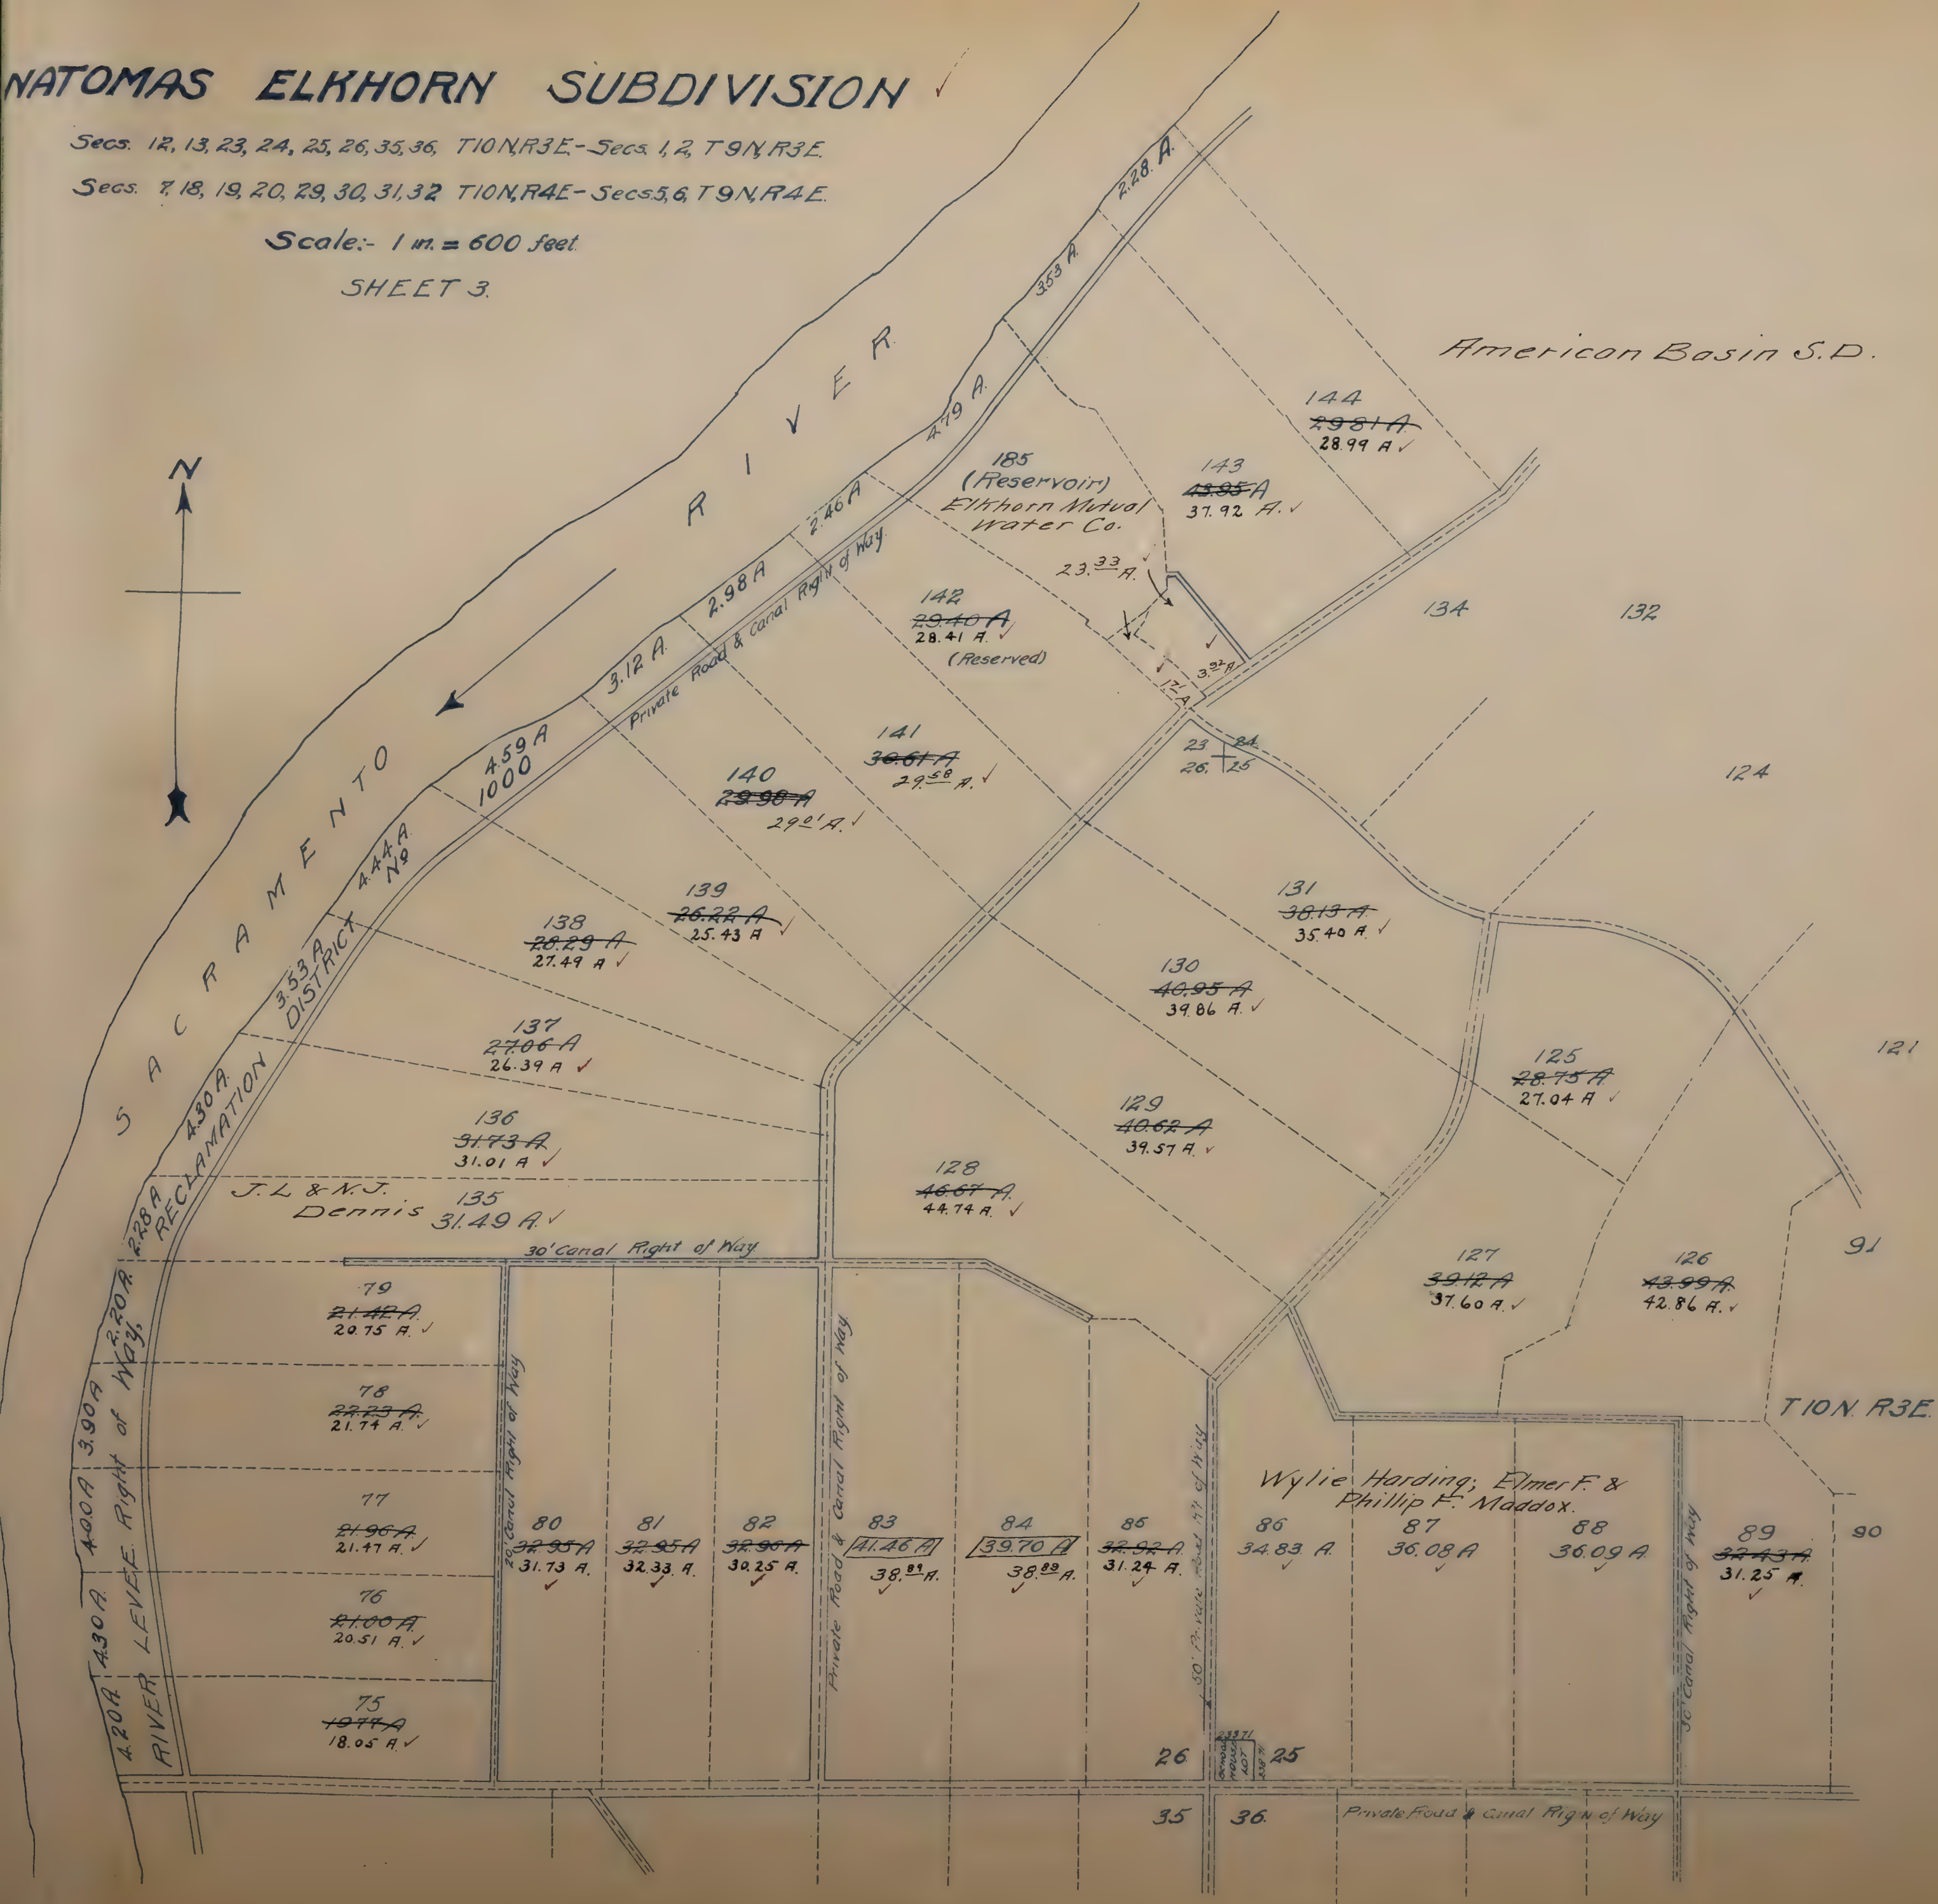

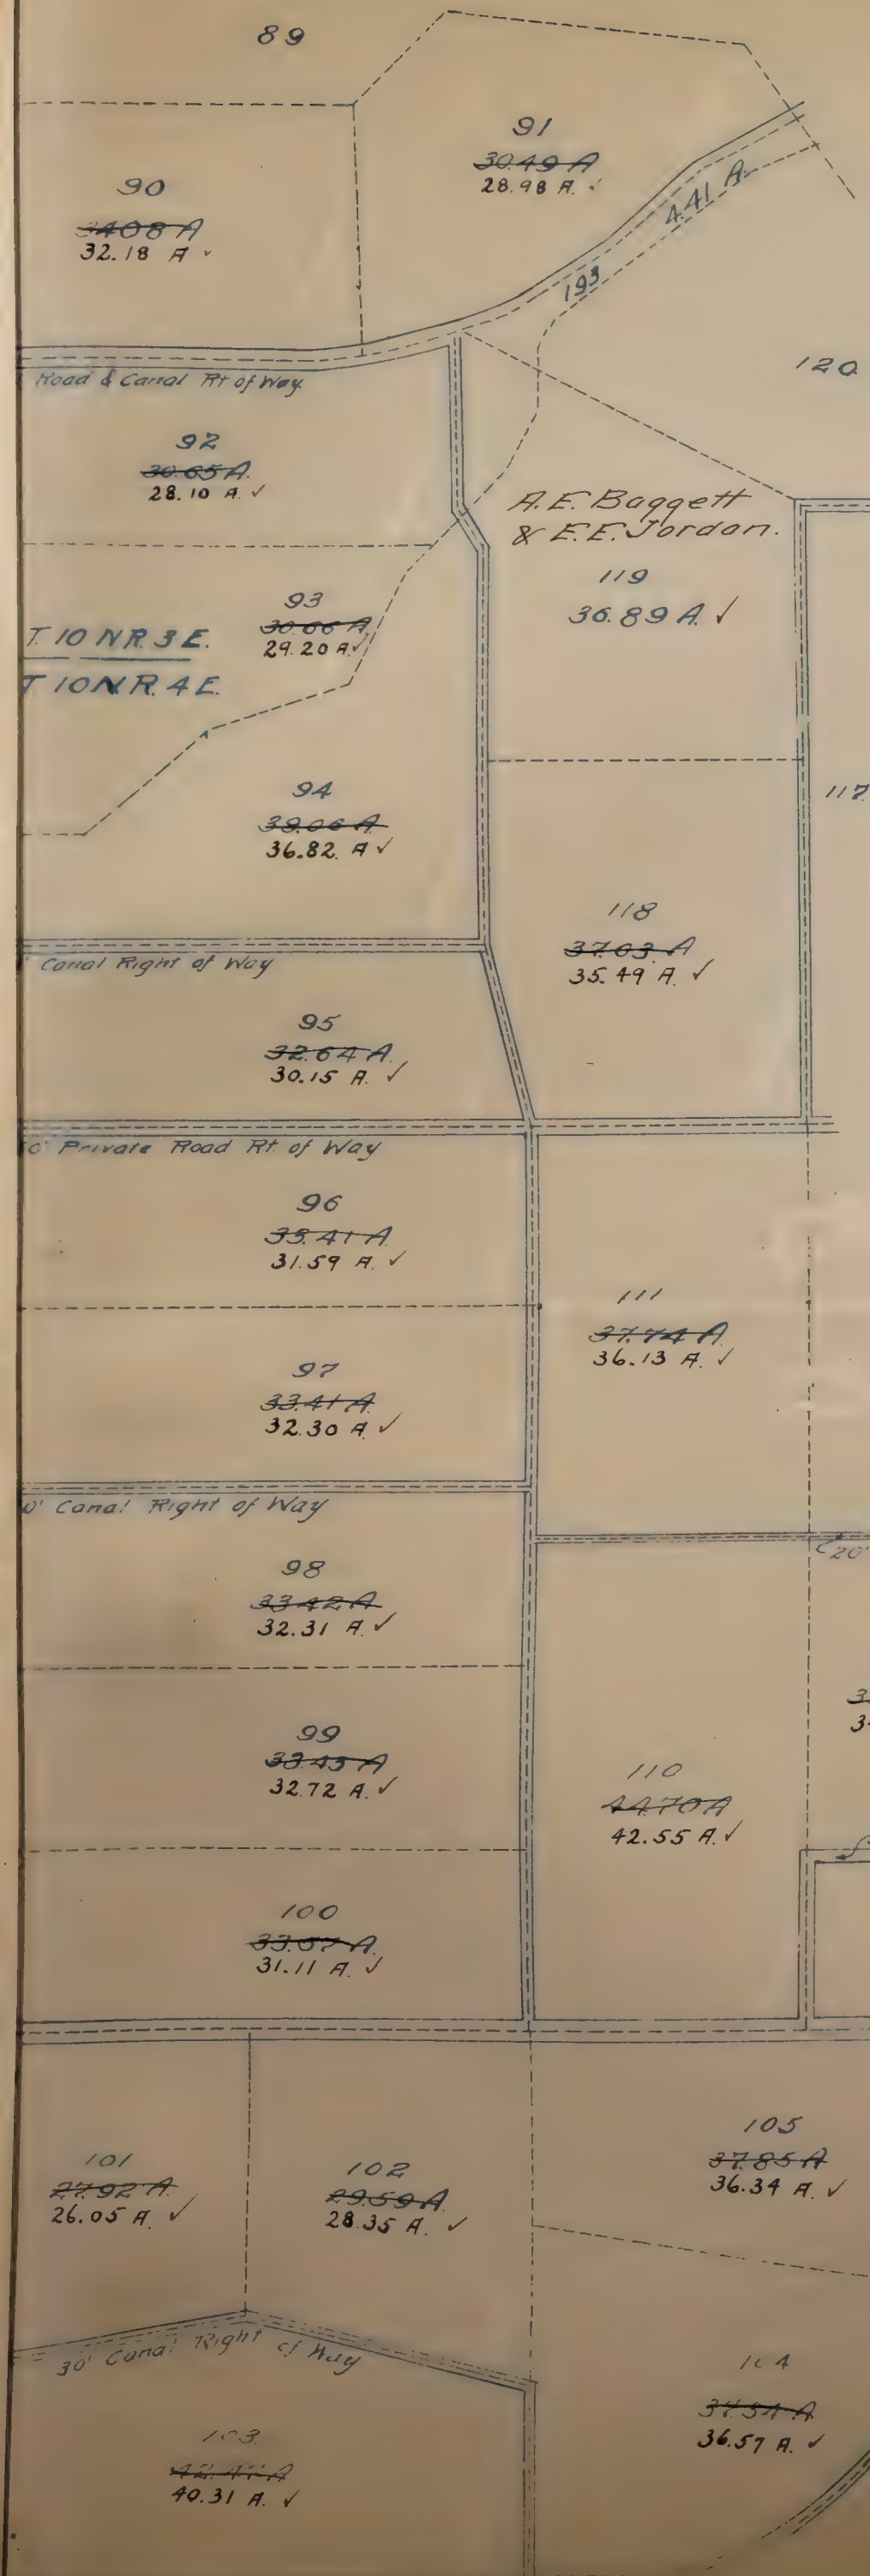

NATOMAS ELKHORN SUBDIVISION ✓


Secs 12, 13, 23, 24, 25, 26, 35, 36, T10N R3E- Secs 1, 2, T 9N, R3E.

Secs. 7, 18, 19, 20, 29, 30, 31, 32, T10N R4E- Secs 5, 6, T 9N R4E.

Scale: 1 inch = 600 feet.

SHEET 5

American Basin S.D.

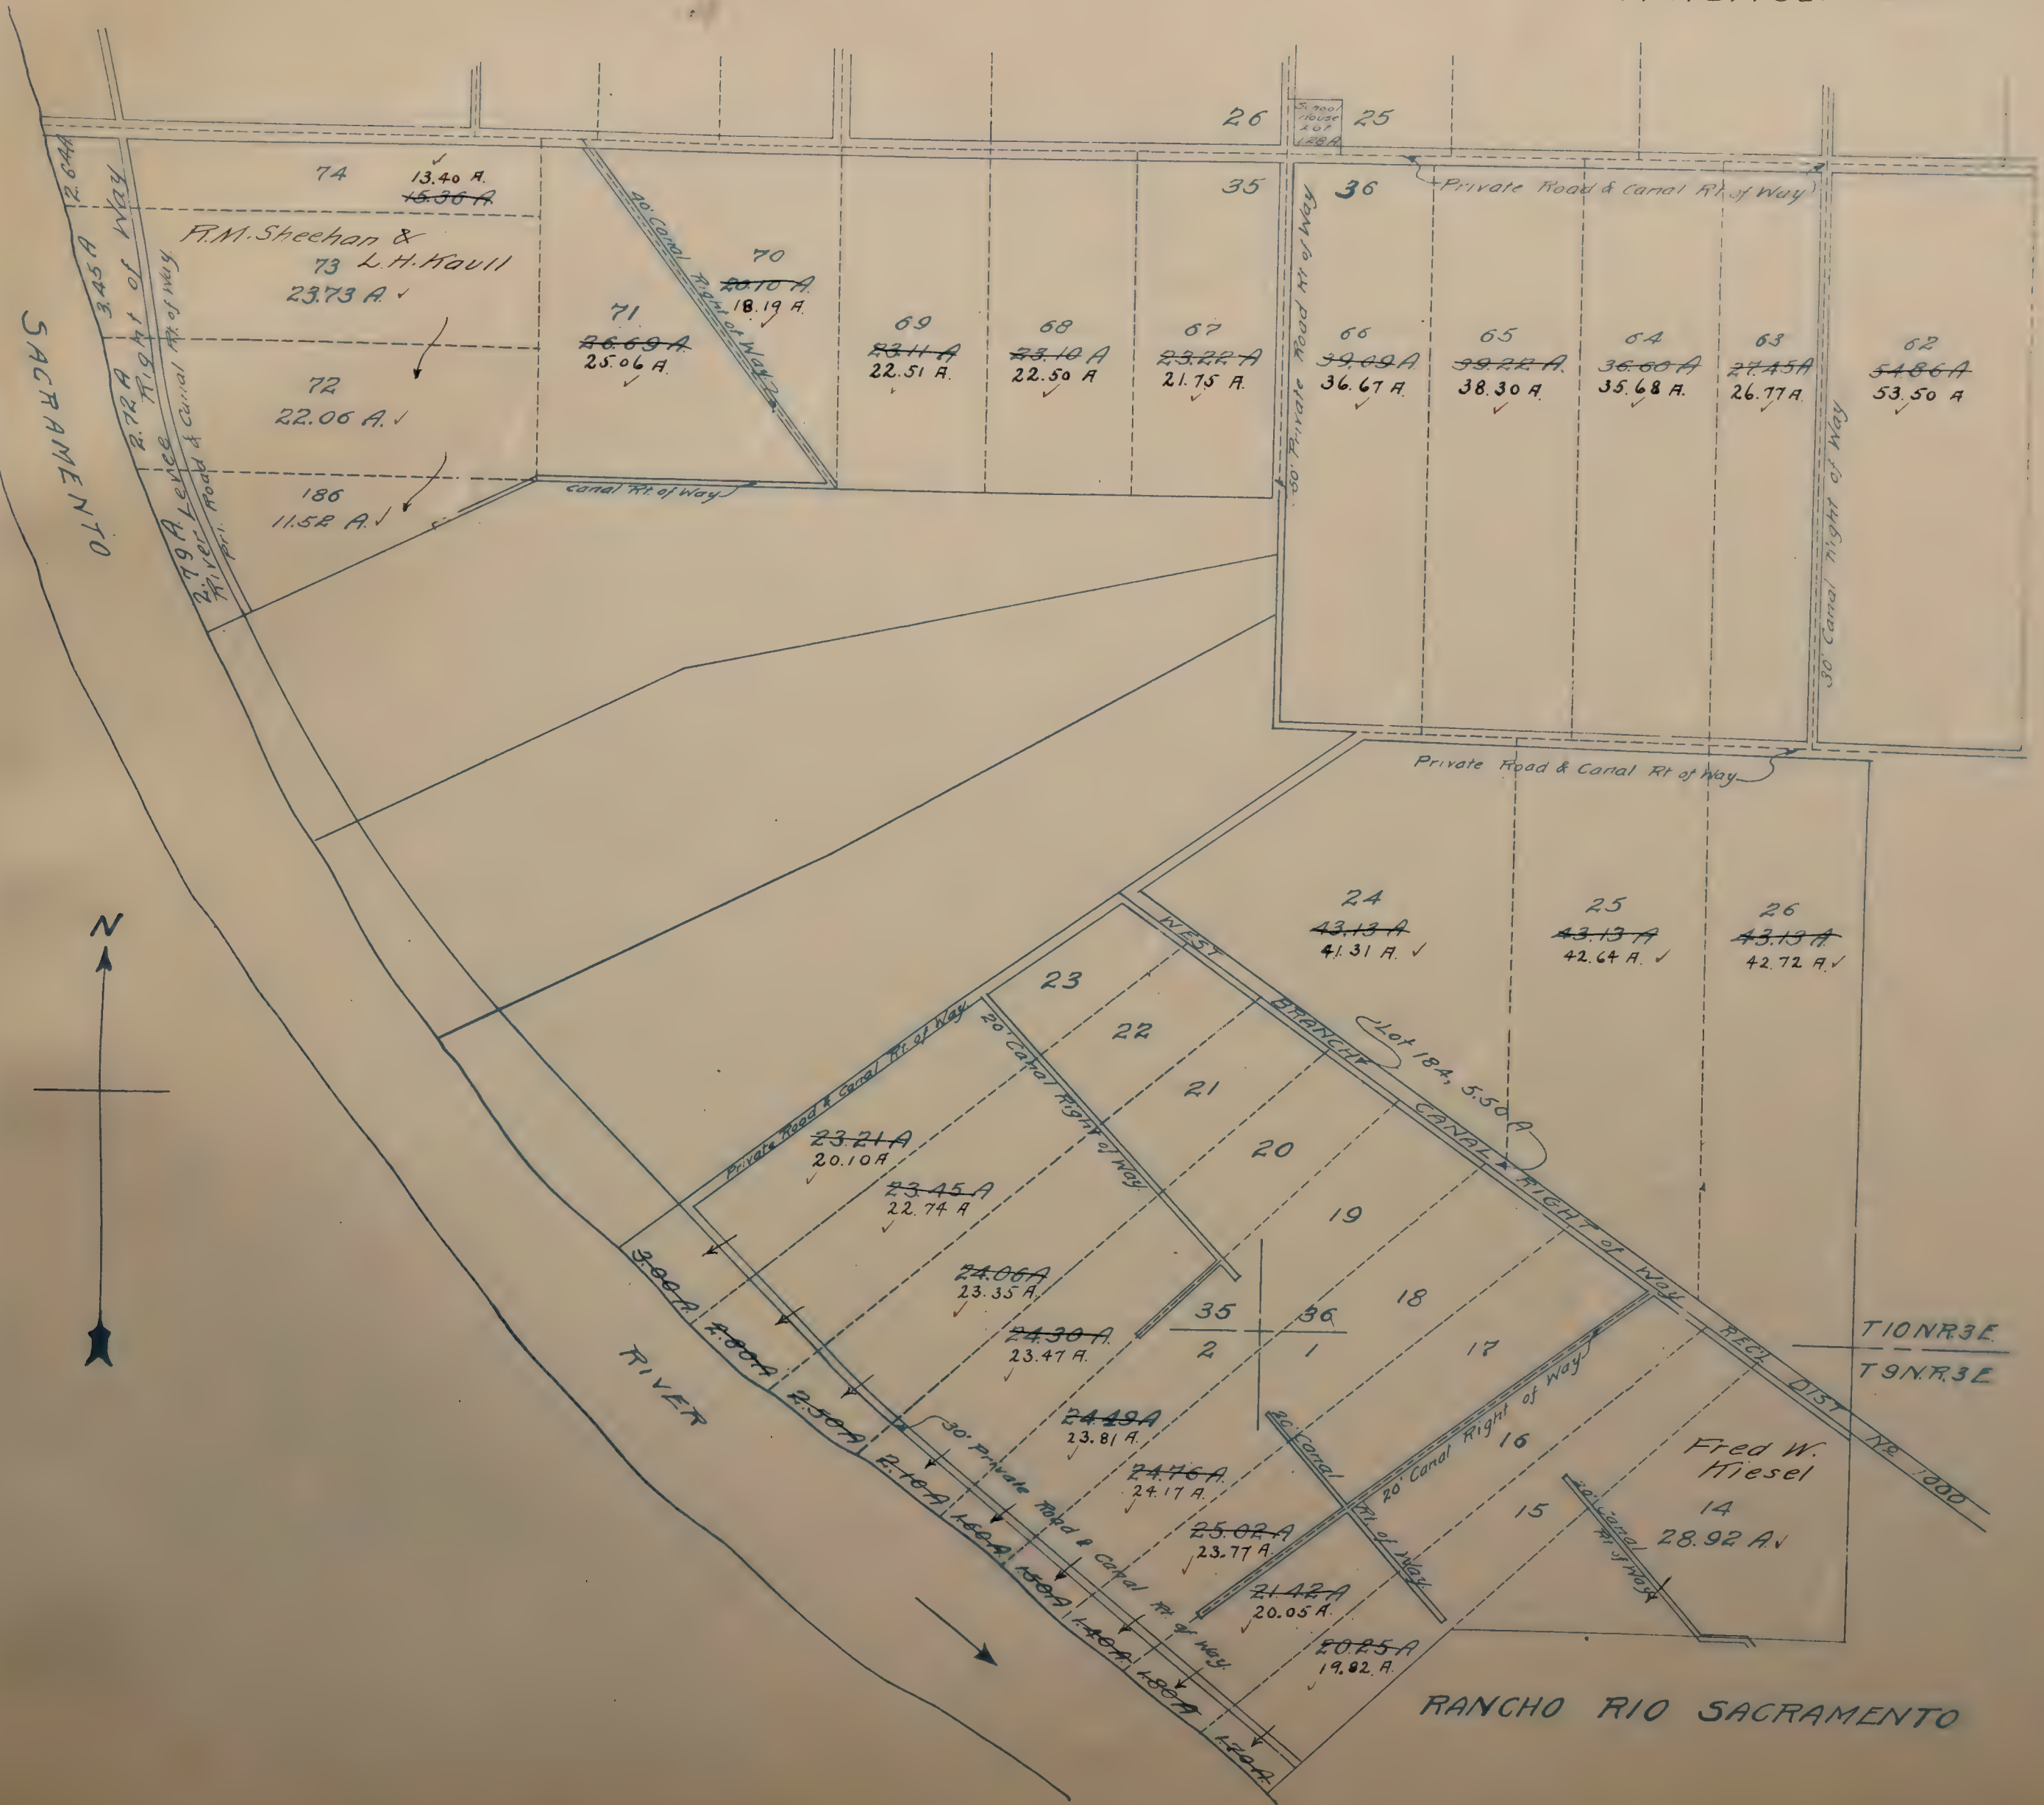

HATOMAS ELKHORN SUBDIVISION ✓

Secs 12, 13, 23, 24, 25, 26, 35, 36, T10NR3E - Secs 1, 2, T9N, R3E
Secs 7, 18, 19, 20, 29, 30, 31, 32, T10NR4E - Secs 5, 6, T9N, R4E.

Scale 1 inch = 600 feet

SHEET 6

American Basin S.D.

WEST BRANCH CANAL RIGHT OF WAY - REGISTRATION DISTRICT No 1000

Albert L. White
and
W. W. Thompson

13
156.92 A ✓

12
~~3950 A~~
39.12 A ✓

11
~~4010 A~~
39.72 A ✓

Rosa L. & Joseph L. Manica, Jr.
Rose Leaf Marica

10
39.48 A ✓

9
~~3962 A~~
37.47 A ✓

36

31

T9N, R4E. canal Right of Way
T10N, R4E

Private Road & Canal Right of Way

6

5

T10NR3E

T10NR4E

27
~~41.48 A~~
40.62 A ✓

28
~~40.00 A~~
39.17 A ✓

29
~~40.00 A~~
39.17 A ✓

F. A. Hilton.

30
~~40.00 A~~
20.0 A ✓

30' Canal Right of Way

31
40.01 A ✓
Mark D. Barrett.

32
~~40.02 A~~
39.54 A ✓

Edward Lauppe.

33
40.01 A ✓

34
39.62 A ✓

Private Road & Canal Right of Way

32

Private Road Right of Way

61
~~39.90 A~~
38.91 A ✓

60
~~39.88~~
39.00 A ✓

59
~~40.17 A~~
39.18 A ✓

58
~~40.78 A~~
38.89 A ✓

30' Canal Right of Way
Wm A & Chas E. Porter

57
~~40.12 A~~
19.05 A ✓

19.05 A ✓

56
~~40.12 A~~
38.98 A ✓

55
40.11 A ✓
{ Geo. Parashaktis
Jas. Parashaktis
Stetios Parashaktis }

54
40.11 A ✓

53
~~40.23 A~~
39.65 A ✓

52
~~40.11 A~~
39.05 A ✓

Lysle E. & Marg't. W. Spangler

51
~~39.00 A~~
36.27 A ✓

31

32

36

31

30

25

30

Private Road & Canal Right of Way

30

29

NATOMAS ELKHORN SUBDIVISION. ✓


Secs. 12, 13, 23, 24, 25, 26, 35, 36, T10N, R3E. Secs. 1, 2, T9N, R3E
Secs. 7, 18, 19, 20, 29, 30, 31, 32, T10N, R4E - Secs. 5, 6, T9N, R4E.

Scale 1 inch = 600 feet.

SHEET 7.

American Basin S.D.

All Blanks To Natomas Co. of Calif.

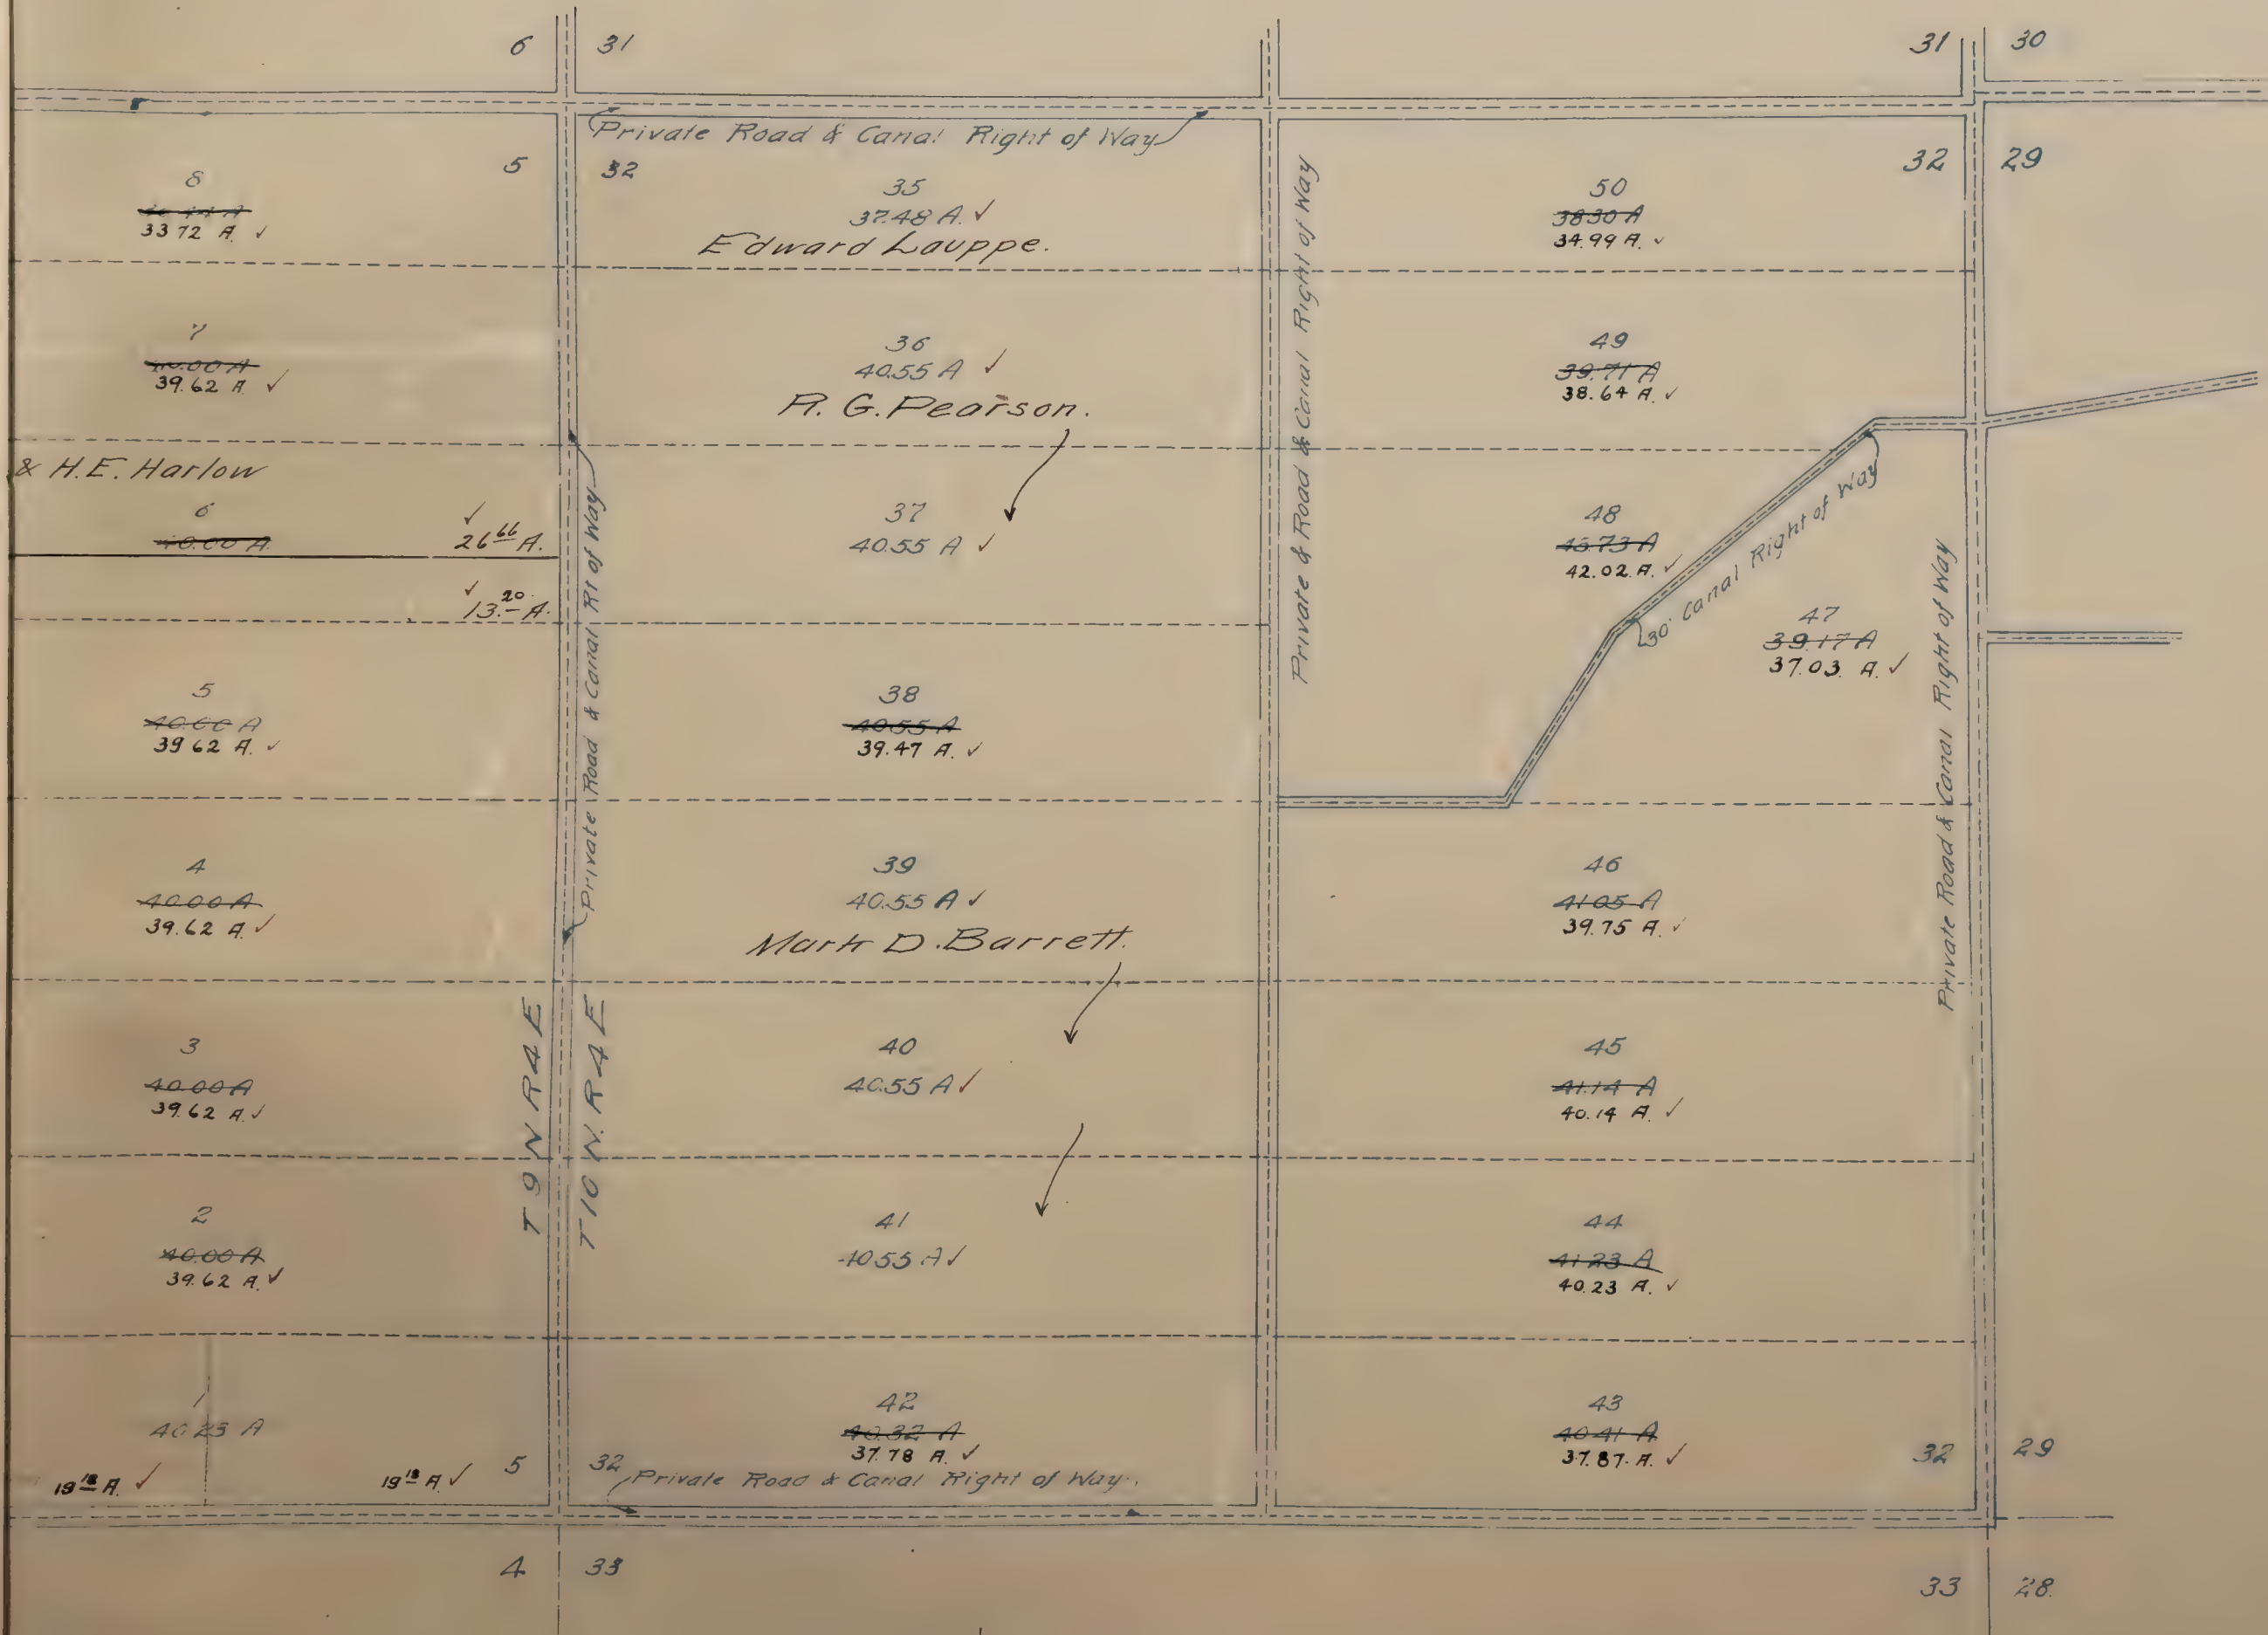

NATOMAS COMPANY OF CALIFORNIA
PRESENTED MAP OF
NATOMAS AMERICAN RIVER
SUBDIVISION NO 4
BEING A PORTION OF NATOMAS CONSOLIDATED
OF CALIFORNIA TRANCEL NO 7 IN THE RANCHO
RIO DE LOS AMERICANOS, SACRAMENTO CO. CAL

Scale 1 inch = 400 feet.

Blanks to Natomas Co. of Calif.



SHEET NO 2

NATOMAS COMPANY OF CALIFORNIA
AMENDED MAP OF
NATOMAS AMERICAN RIVER
SUBDIVISION NO 4
BEING A PORTION OF NATOMAS CONSOLIDATED
OF CALIFORNIA PARCEL NO 7 IN THE RANCHO
RIO DE LOS AMERICANOS, SACRAMENTO CO. CAL.

Scale 1 inch = 400 feet

Edw. Kelly S.D.
~~Brighton S.D.~~

Minney S.D.

All Blanks To Natomas Co. of Calif.




NATOMAS COMPANY OF CALIFORNIA
 MAP OF
 NATOMAS GOODLAND SUBDIVISION ✓
 IN section 10-T 10'N R 4E. M.Q.N.

Scale 1 inch = 600 Feet.

Lincoln S.D.

NATOMAS COMPANY OF CALIFORNIA

All Blanks to Natomas Co. of Calif.

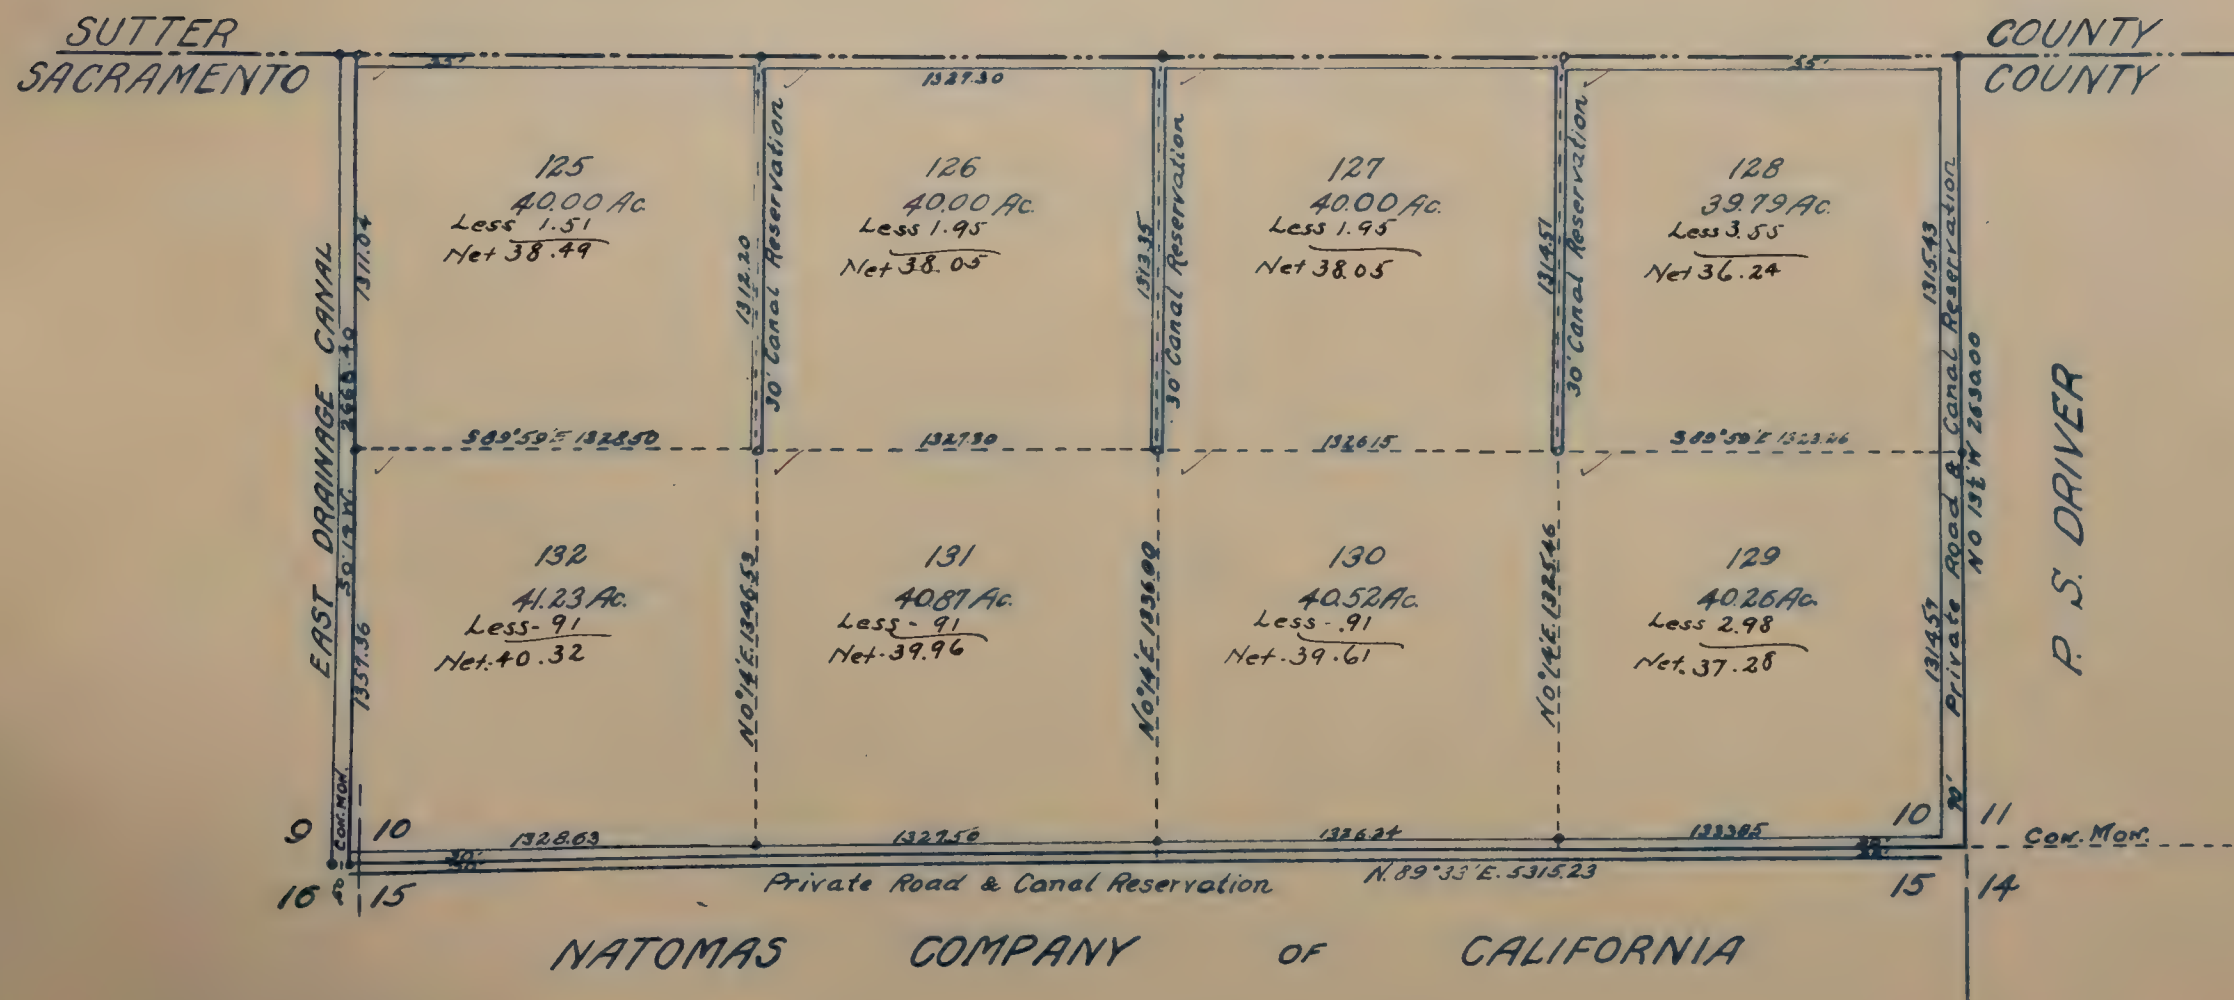

2 11
10 17


NATOMAS RIVERSIDE SUBD'N No 1 ✓

LOCATED IN
SEC'S 27 & 28, T. 3 N. R. 4 E.

Scale 1" = 400 Feet

All Blanks to Natomas Co. of Calif.

Jefferson S. D.

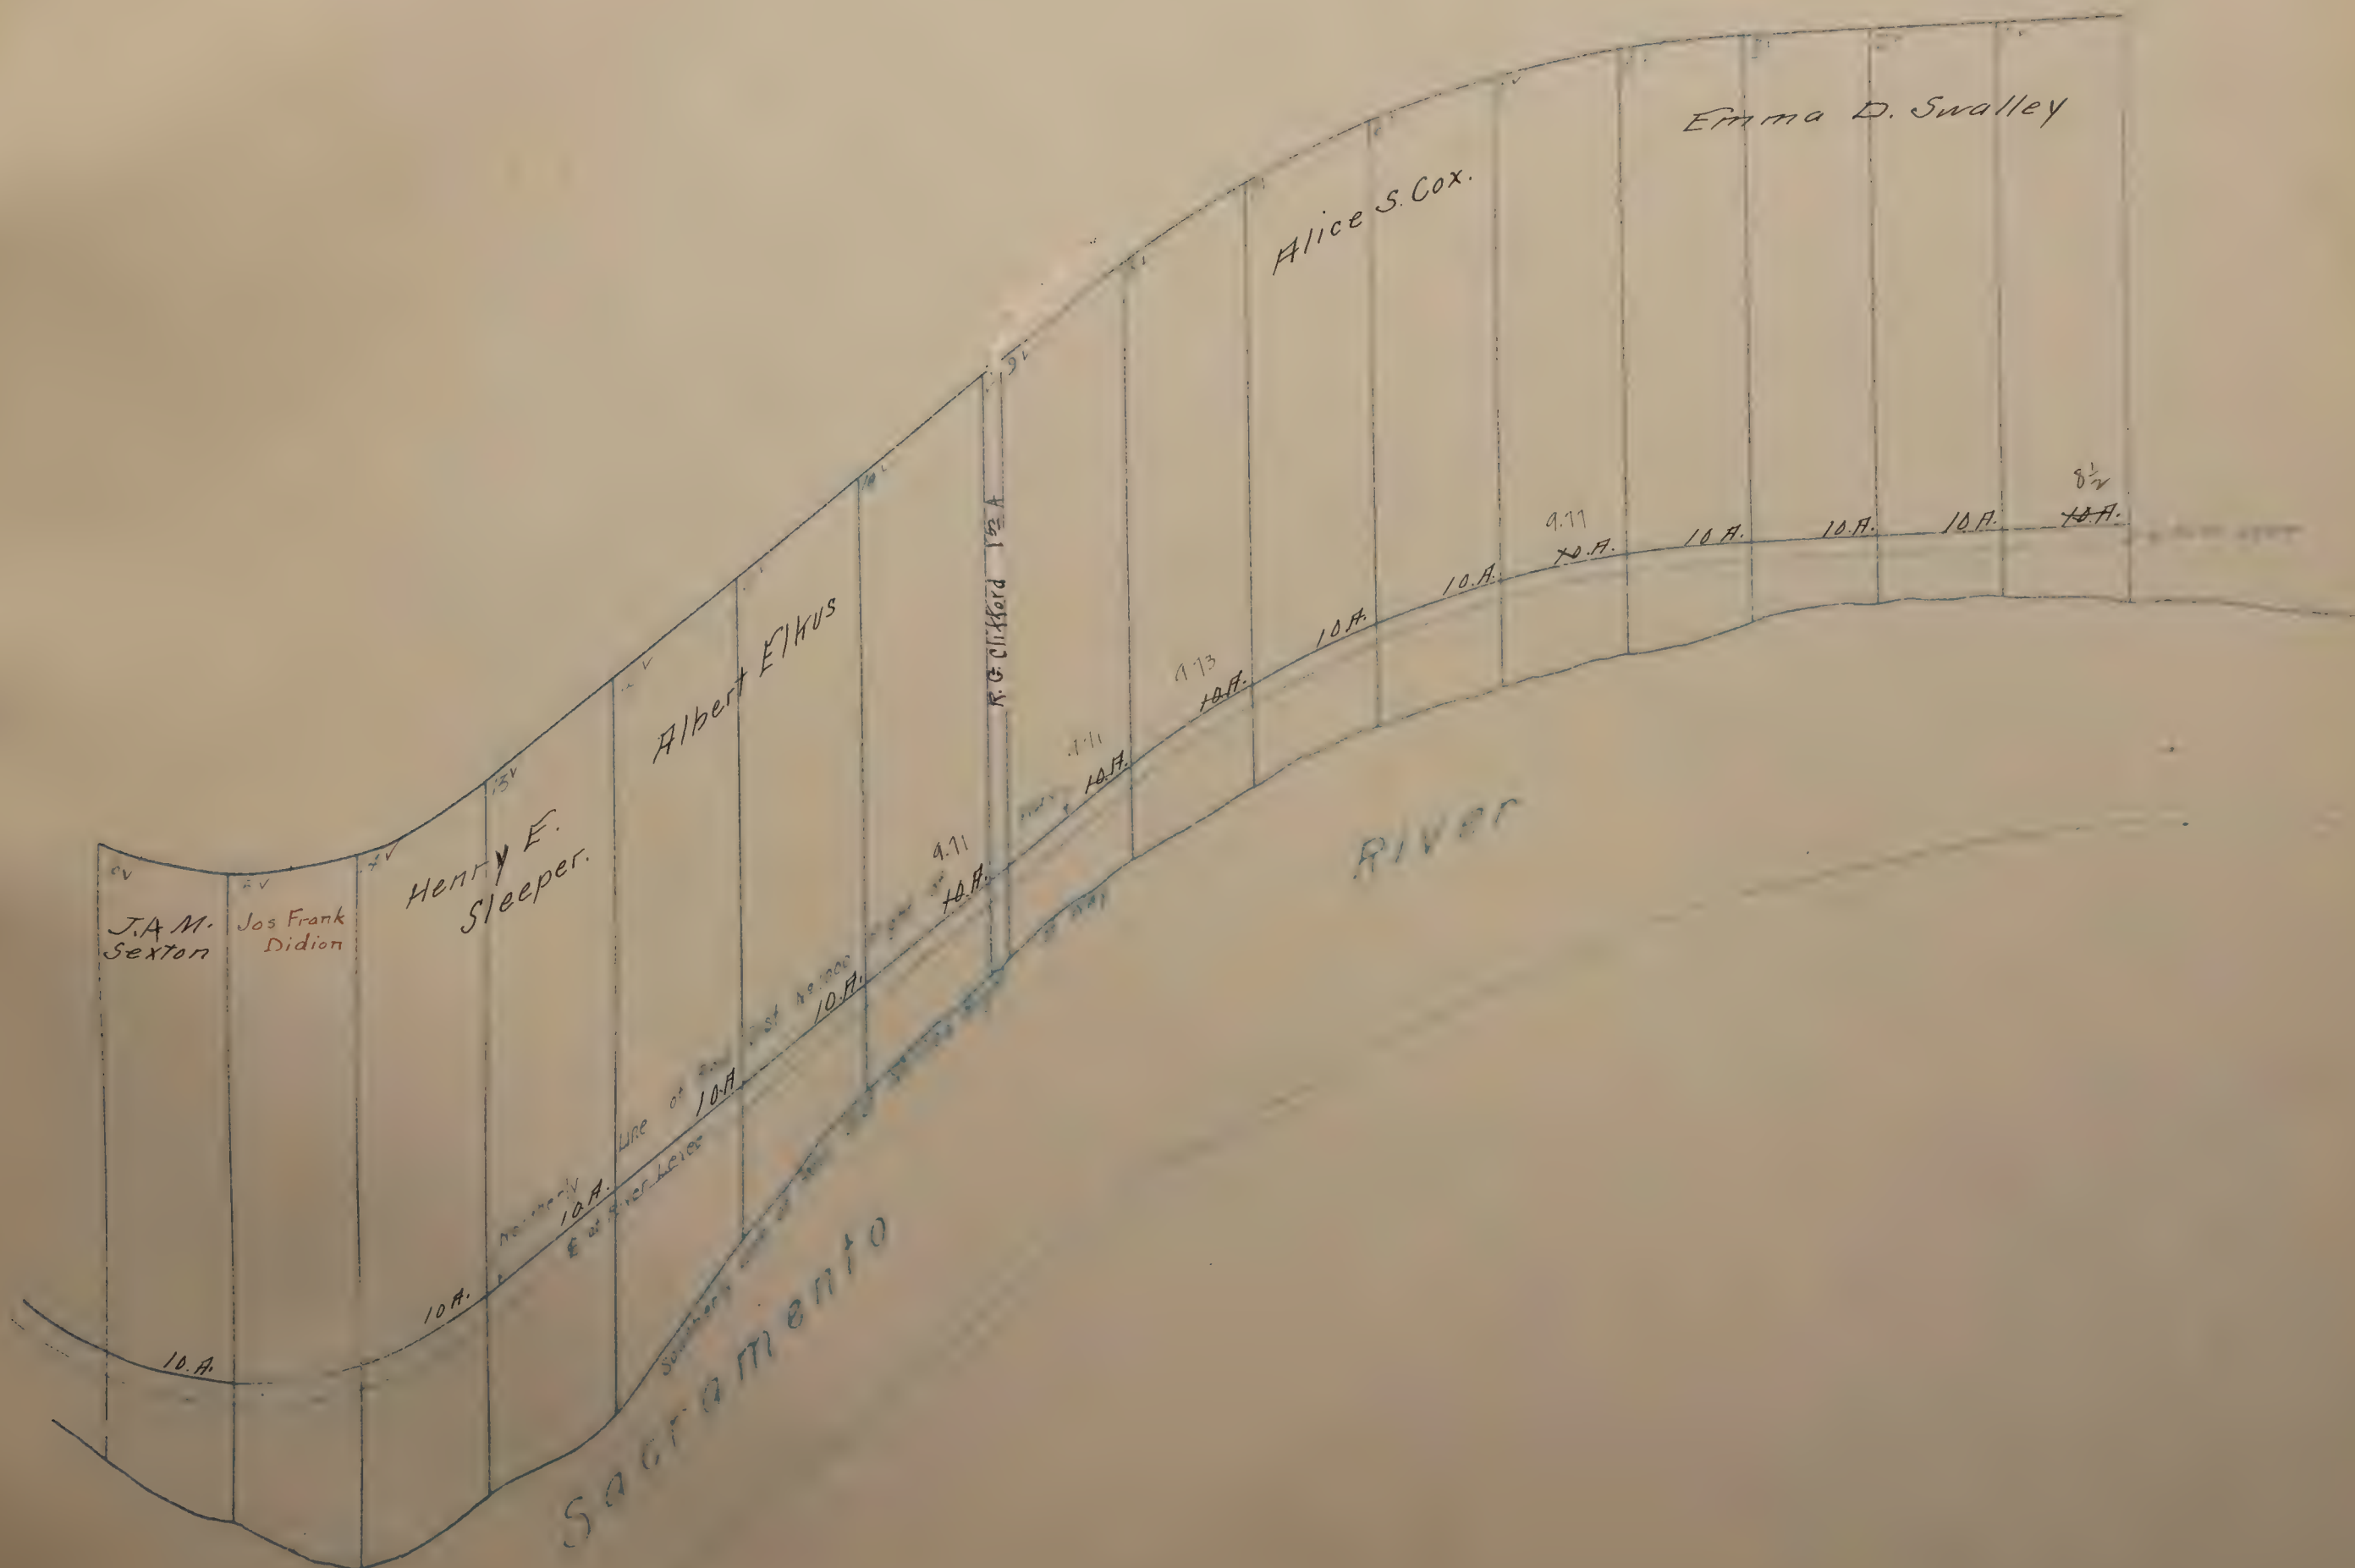

NATOMAS RIVERSIDE SUBDIVISION No 2 ✓


Recorded in Book 14 of Maps 27, 28, 29, 30 of Map 42

SHEET 2

Scale 1" = 40' 60' 120'

All Blanks to Natomas Co. of Calif.

Jefferson S. D.

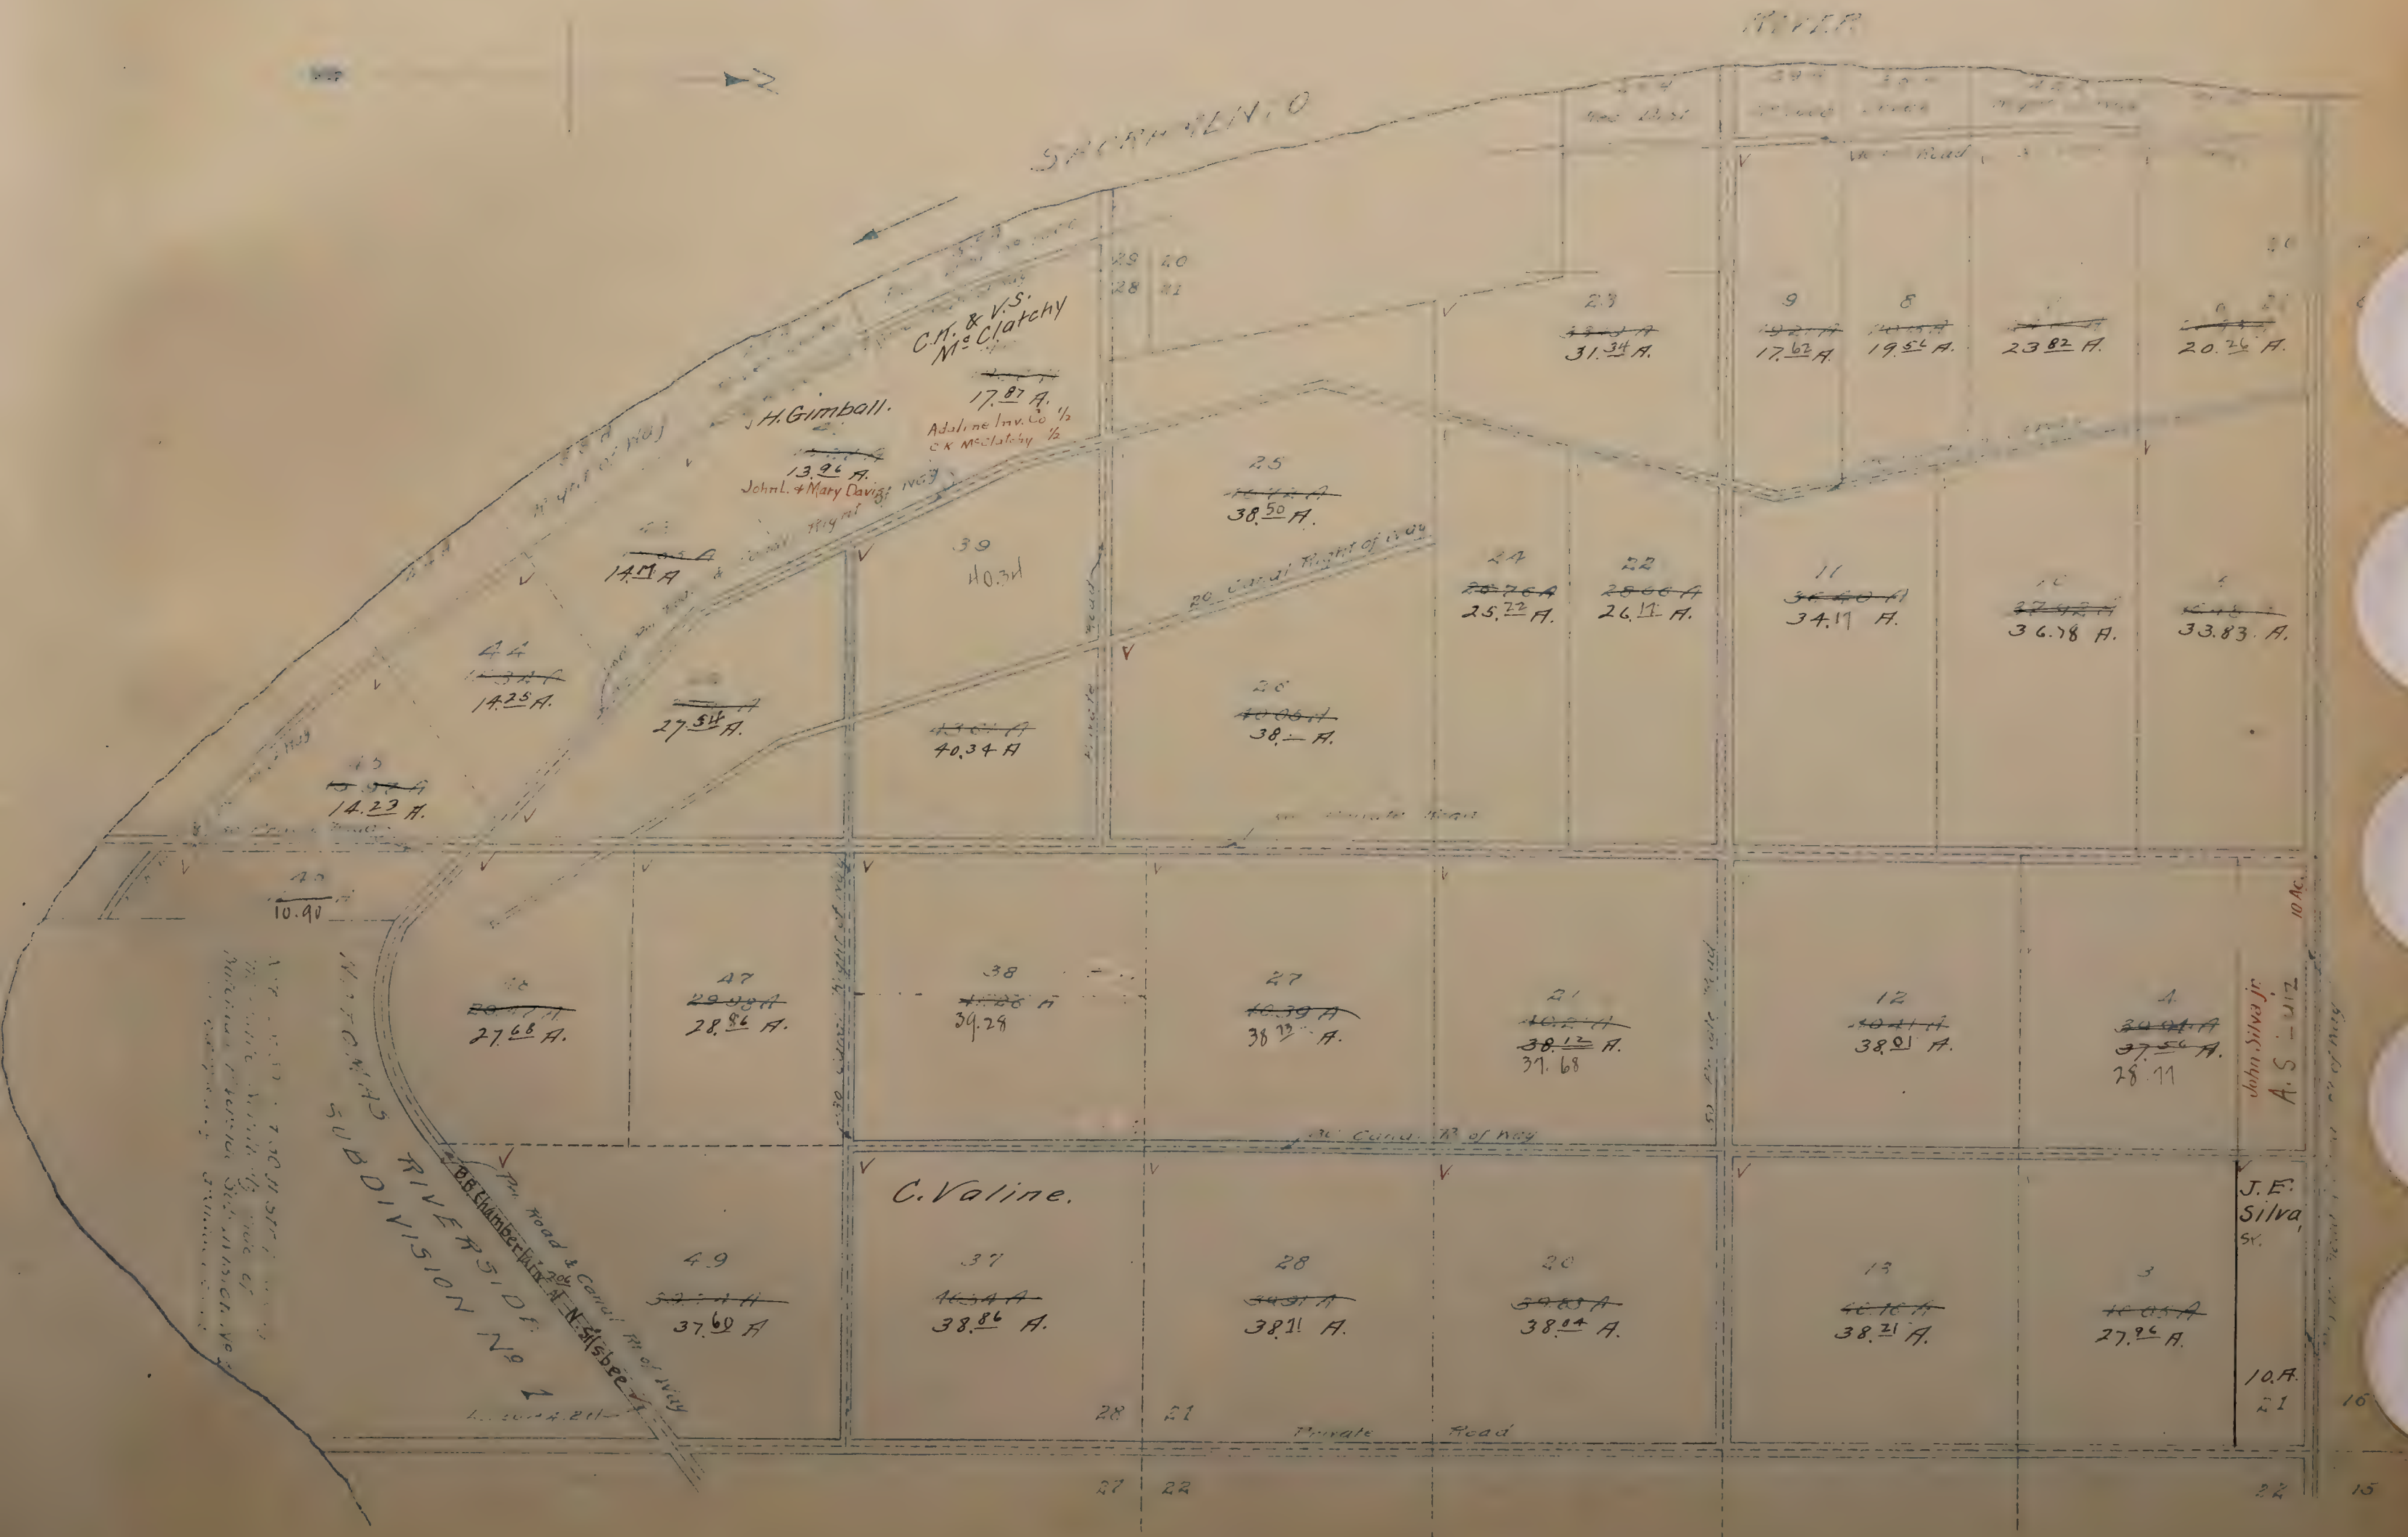

NATOMAS RIVERSIDE SUBDIVISION NO 2 ✓


Location - Same as Division No 1

Sheet No.

Scale 1 inch = 40 feet

All Blanks To Natomas Co. of Calif.

Jefferson S.D.

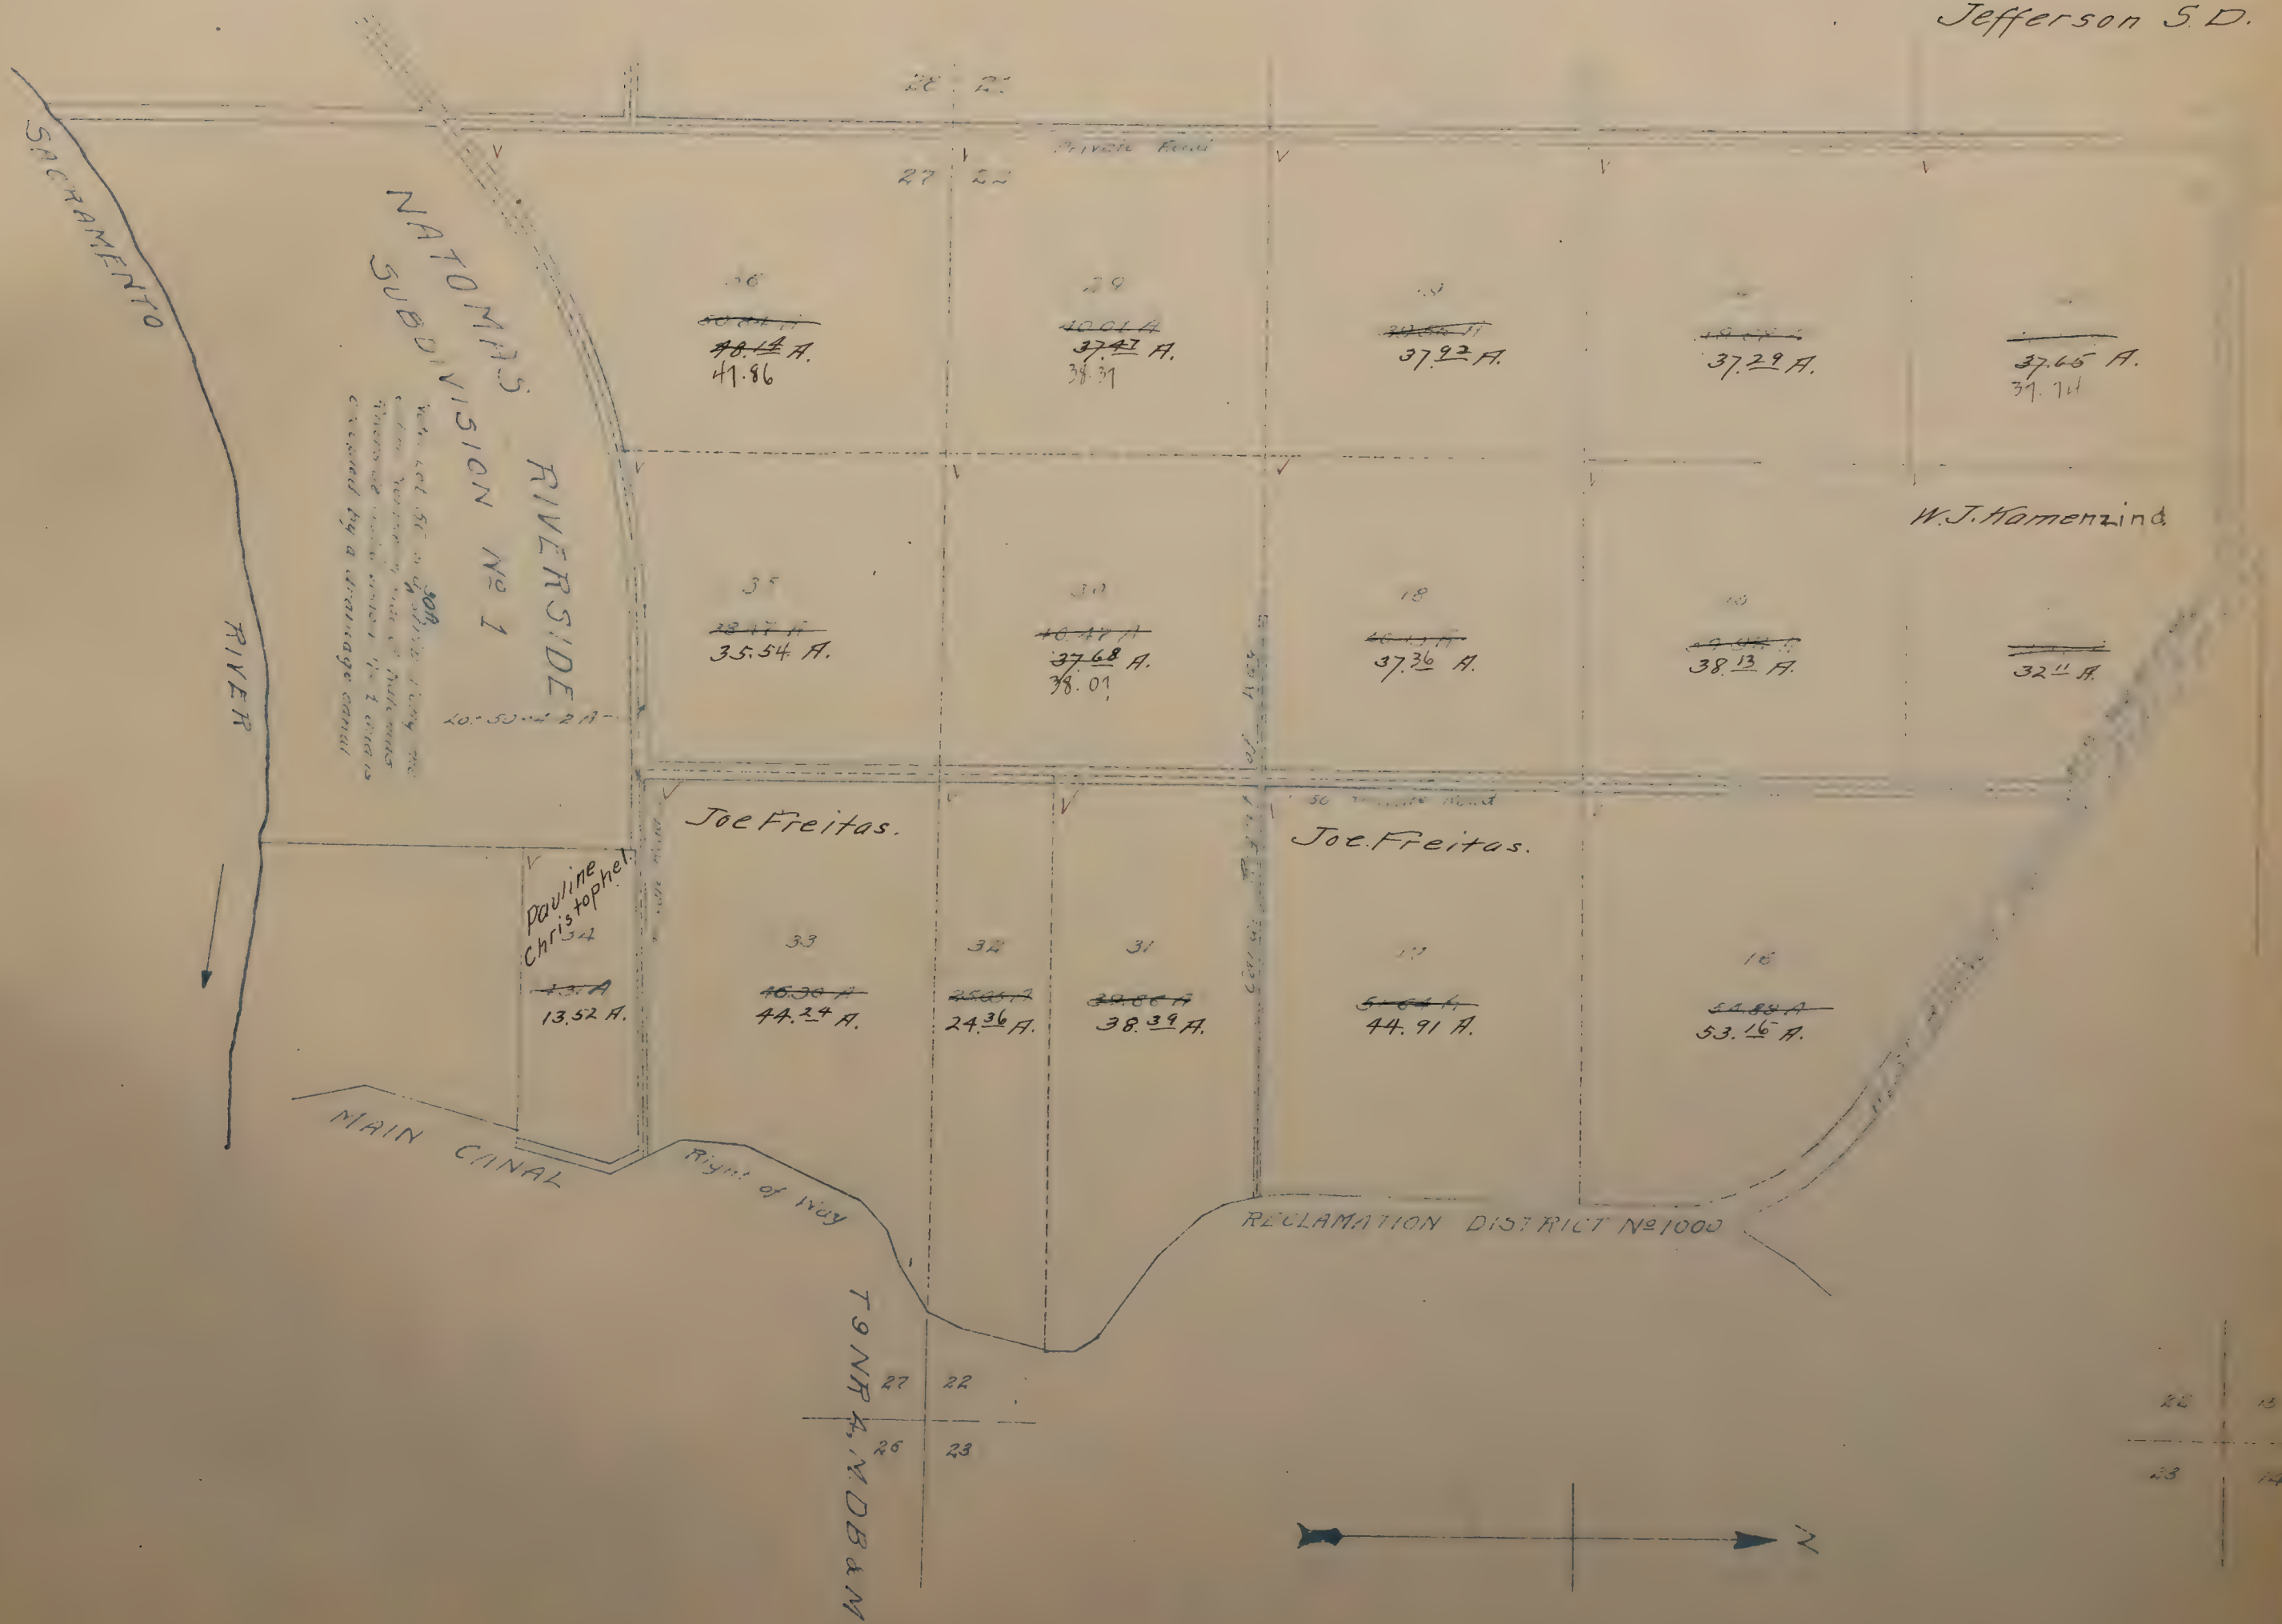

Located in Secs 4, 5, 6, 7, 8, 9, 15, 16, 17 - T. 9 N. R. 4 E. & Sec. 12. T. 9 N. R. 3 E.

NATOMAS RIVERSIDE SUBDIVISION No. 3.

Scale 1" = 100 Ft.

All Blanks to Natomas Co of Calif.

RECLAMATION DISTRICT No 1000 DRAINAGE CANAL RIGHT OF WAY

Private Road Reservation

American Basin S.D.

30675 Ac

See Acreage

RANCHO RIO SACRAMENTO

✓ Pumping Plant on Lot 34

34
~~3405 AC~~
31.37 A. ✓
E.W. F.S. &
E.P. DRIVER

35
~~32.89 AC~~
31.35 A. ✓

33
~~4770 AC~~
45.10 A. ✓

32
~~3980 AC~~
37.58 A. ✓

F.E. Bennett.

27
~~3406 AC~~
33.76 A. ✓

31
~~3582 AC~~
34.59 A. ✓

28
~~6287 AC~~
59.94 A. ✓

30
~~2089 AC~~
19.00 A. ✓

36
~~3617 AC~~
34.23 A. ✓

37
~~4638 AC~~
43.41 A. ✓

29.
~~4613 AC~~
42.12 A. ✓

RECLAMATION
DISTRICT
2120 AC

463 AC

RIVER

NATOMAS COMPANY OF CALIFORNIA
MAP OF

NATOMAS RIVERSIDE SUBDIVISION No. 3
SACRAMENTO COUNTY, CALIFORNIA

NATOMAS RIVERSIDE SUBDIVISION No 3.

Located in Sec's. 4, 5, 6, 7, 8, 9, 15, 16, 17 T. 9 N. R. 4 E. & Sec. 12 T. 9 N. R. 3 E.

Scale. - 1" = 600 FT.

NATOMAS ELKHORN SUB'D.

RECLAMATION DISTRICT No 1000 DRAINAGE CANAL RIGHT OF WAY

Blanks to Natomas Co. of Calif.



NATOMAS RIVERSIDE SUB'D. No 3. ✓


Located in Sec's. 4, 5, 6, 7, 8, 9, 15, 16, 17 - T. 9 N. R. 4 E. & Sec. 12 T. 9 N. R. 3 E.

Scale: - 1" = 600 Ft.

All Blanks to Natomas Co. of Calif.

Jefferson S.D.

NATOMAS COMPANY OF CALIFORNIA

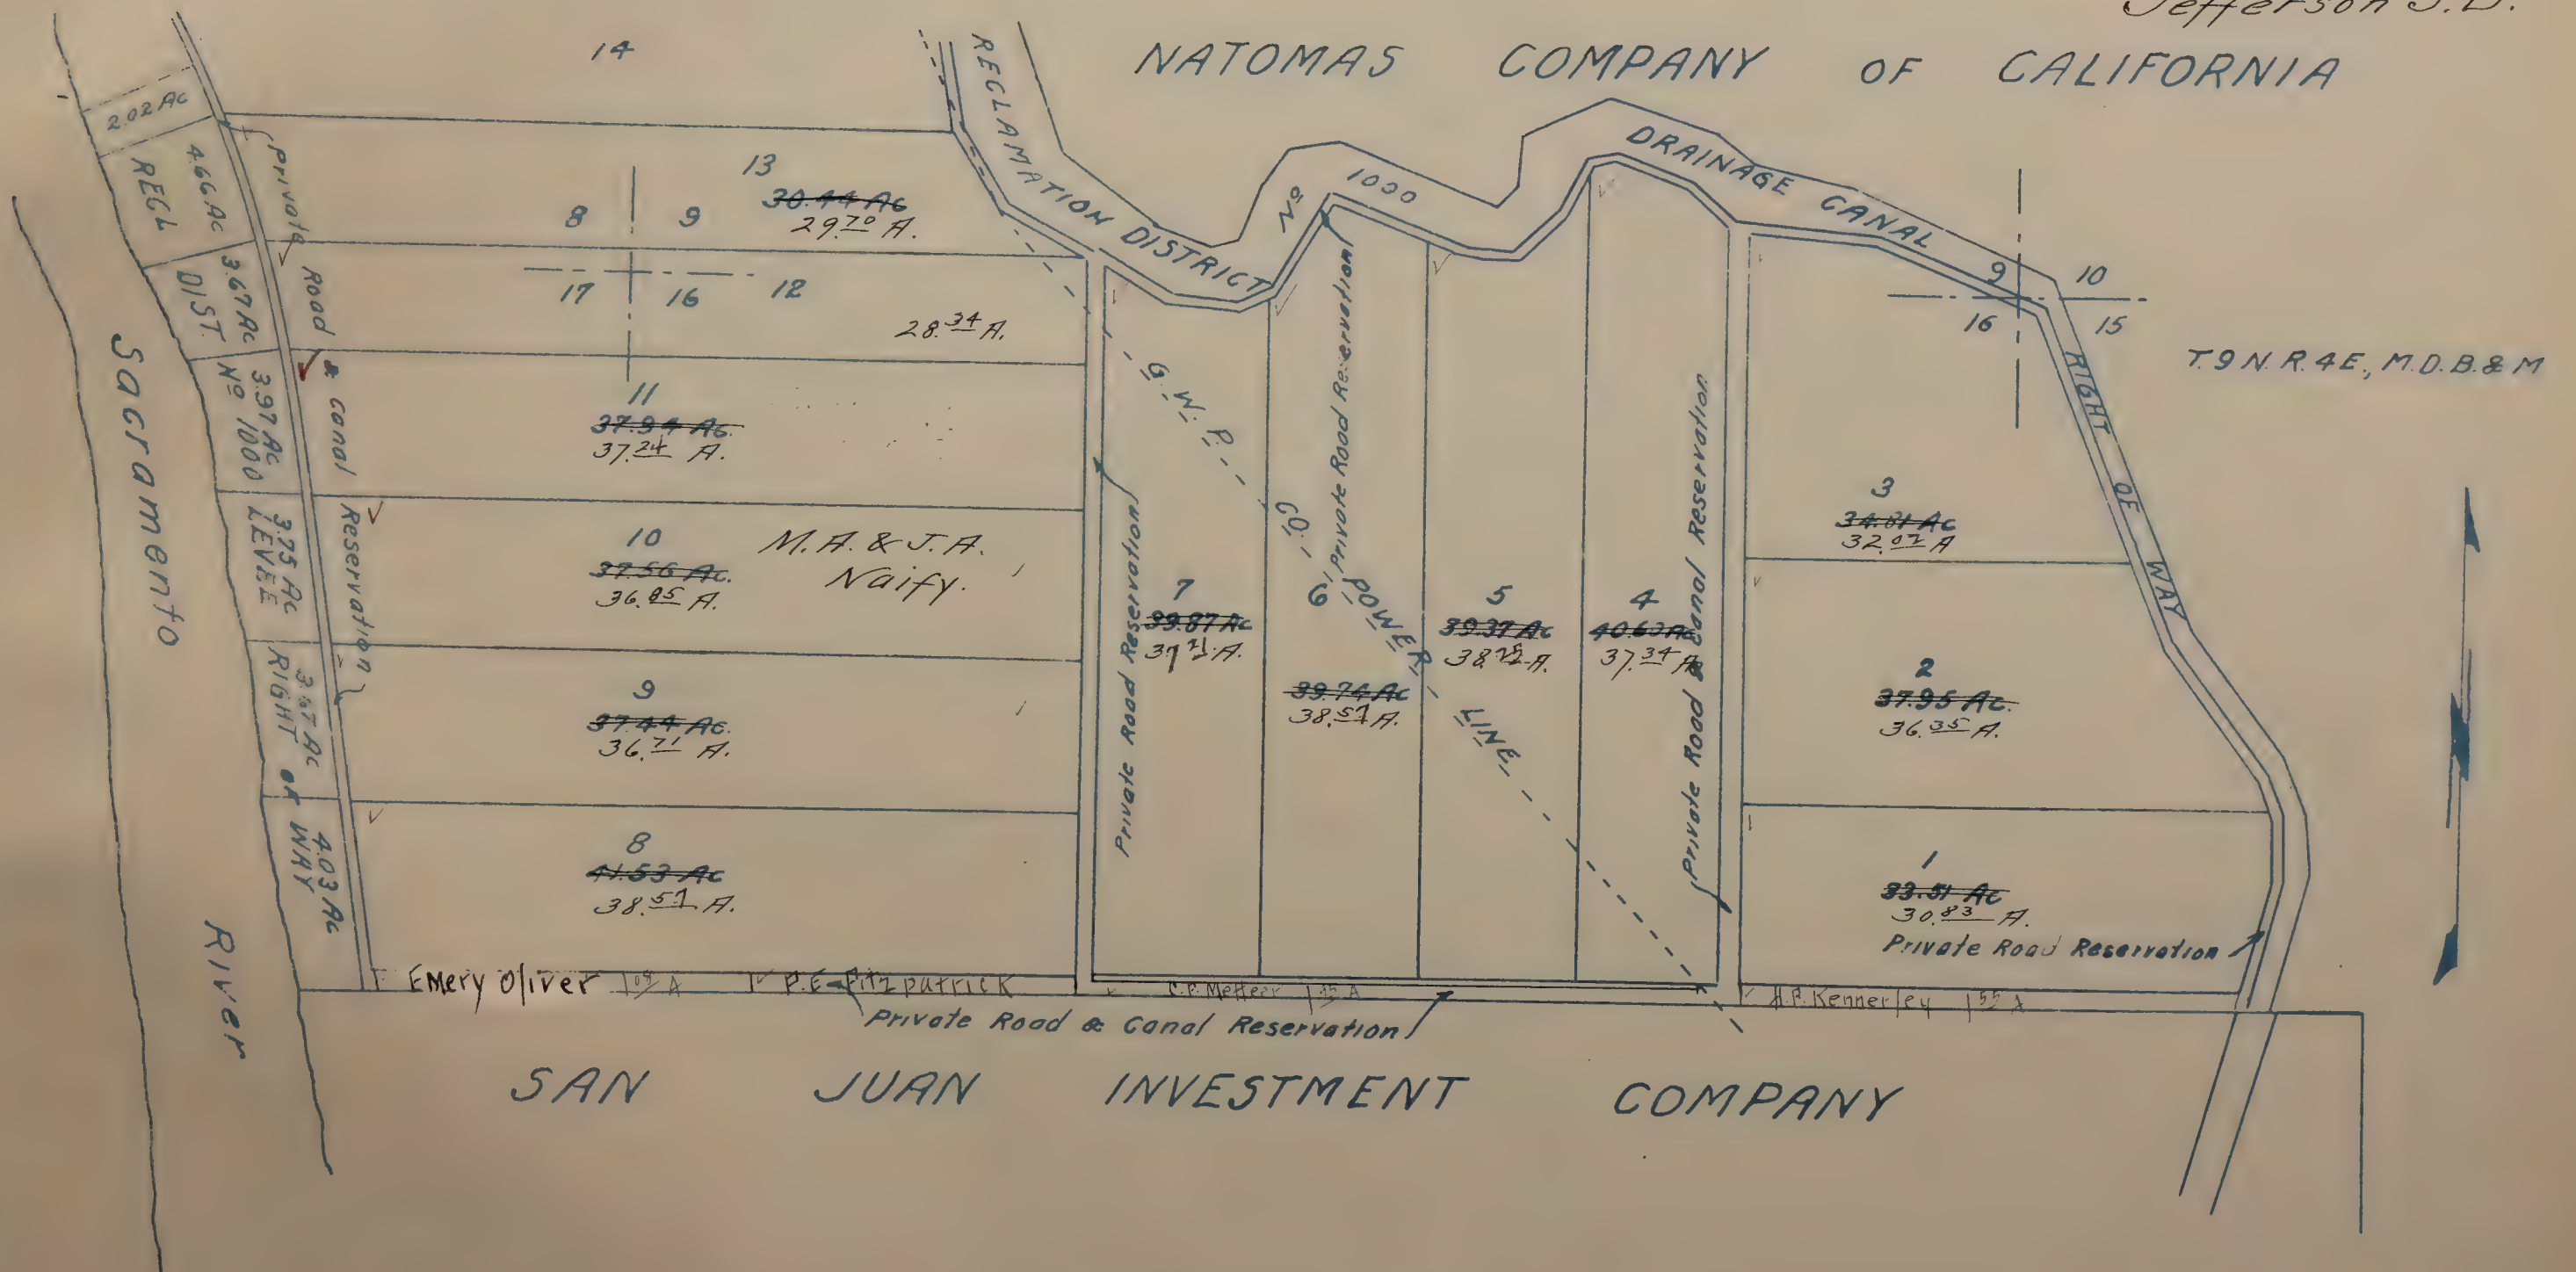

NATOMAS COMPANY OF CALIFORNIA
MAP OF
NATOMAS RIVERSIDE SUBDIVISION No 3
SACRAMENTO COUNTY, CALIFORNIA

NATOMA SUBDIVISION

Scale 8 chains = 1 inch

Granite S.D.

All Blanks to Natomas Co. of Calif.



H. Reed Fc's

Fc. Lot 29 - 0.80
 " " 30 - 12.65
 " " 31 - 10.34
 " " 32 - 9.15

33.12

Less - .854 sold to Pratt Co.

checked on map Total = 32.266

Western States Gas.

& Electric Co. Fc. 1/3 A. Lots 40 & 41

SACRAMENTO & PLACERVILLE RAILROAD

Pratt Rock & Gravel Co.
 157.40 Acs. inc.

Pratt Rock & Gravel Co.
 157.40 Acs. inc.
 checked above

Ulrich Tanner.
 30 A.

Hayward Field
 32.266 A.

Humbug
 Willow Creek

Slough

W.H. Comstock.
 14.6 A.

Natomas Co. of Calif.

Nat. Co. of Calif.

Natomas Co. of Calif.

Natomas Acs.

Fc. Lot 13 & 14
 " " 15 to 23 + 24 to 29 } 156.678 Acs. ✓
 " " 30 + 31

Fc. Lot 32-33 & 42 - - } 226.444 ✓
 All Lots 43 & 46 - -

Fc. Lots 47 & 48 - -
 Fc. 5 1/2 Lots 8-9-10-11 & all
 Lots 49 to 53 inc. } 68.971 ✓
 452.093 Acs.

W.H. Comstock 5.65
 Fc. Lots 10-11-13-14

Geo. White

Natomas Co. of Calif.

Nat. Co. of Calif.

Natomas Co. of Calif.

Natomas Co. of Calif.

NEW GLENDALE

SUBDIVISION

Page 52

All Blanks to F. G. Ames.

MASCOT		WARWICK		FRUIT RIDGE PARK	
1		26		70	
2		25	Miss C. McLean	69	
3		24		68	
4		23		67	
5		22		66	
6		21		65	
7		20		64	
8		19		63	
9		18		62	
10		17		61	
11		16		60	
12		15		59	
13		14		58	
14		13		57	
15		12		56	
16		11		55	
17		10		54	
18		9		53	
19		8		52	
		7		51	
		6		50	
		5		49	
		4		48	
		3		47	
		2		46	
		1		45	

Rio Linda S.D.

Rio Linda S.D.



NEW RAMONA ✓

LOCATED IN
SECTION 15 T 8 N. R 5 E

Scale 4 chains = 1 inch

Junction S.D.

430 A.

Charles C.
&
Mildred Turner.

5 A.

Sven
Johnson

Celeste Staug.

10 A.

1.7 A.

See Ramona Villa

J.L. Nilsson.

Silvio Laurenzi.

13 3/4 A.

Thos. Laine.

Alfred Palm
Jennie H. Nilsson

J.L. Nilsson.

Olive E. Flint.

4.50 A.

Mary A. Powell O.W. Stafford.

Frank
Armbruster.

New Ramona

N.W. 1/4 of Section 20, T.8 N.R.5E.

All Blanks to E. A. Thiele, B. F. Driver & W. T. Foster.

Fruit Ridge S.D.

